


AUG. 1911

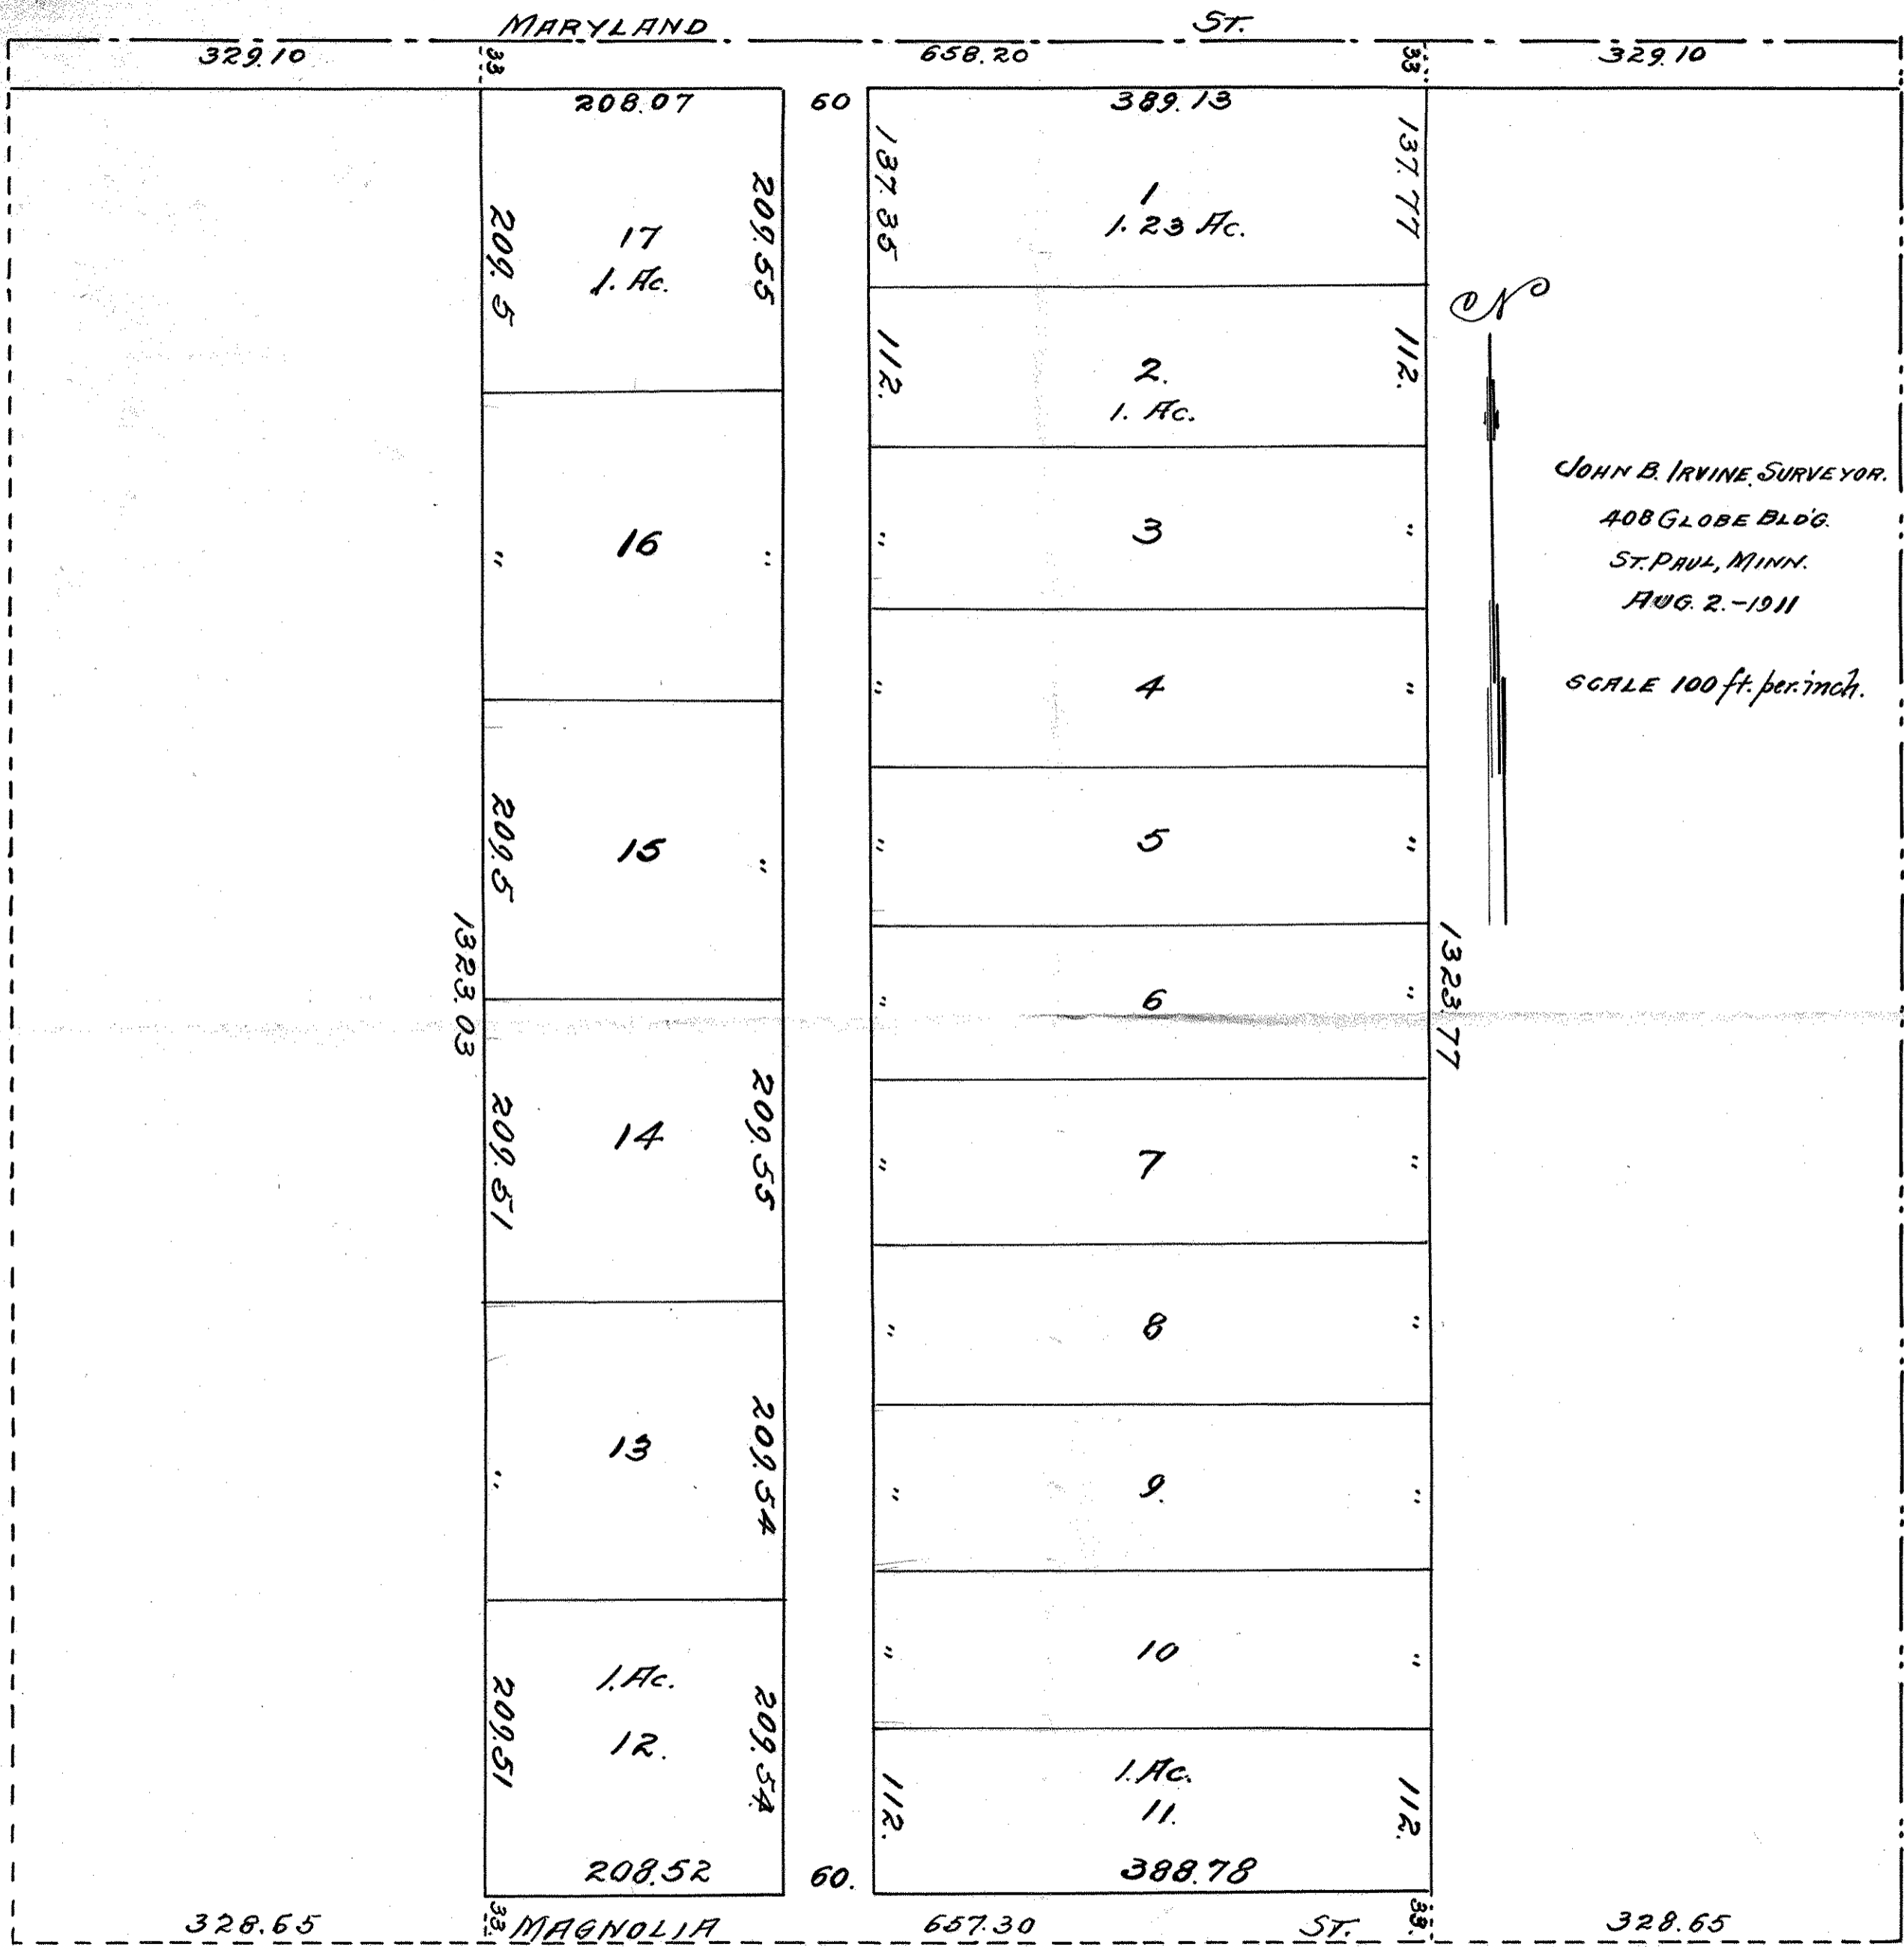

*Handwritten mark*

JOHN B. IRVINE SURVEYOR.  
 408 GLOBE BLDG.  
 ST. PAUL, MINN.  
 AUG. 2. - 1911  
 SCALE 100 ft. per inch.

Lot. 1 = 1.22 Ac  
 Lots 2-17 = 1. Ac.

THE WEST 20 ACRES OF THE EAST 30 ACRES OF  
 N. E. 1/4 OF N. W. 1/4 SEC. 27. T. 29. R. 22.

*County & Meiers*