28 22

LOT 6. BLOCK 5
BANNING & OLIVER'S ADD.
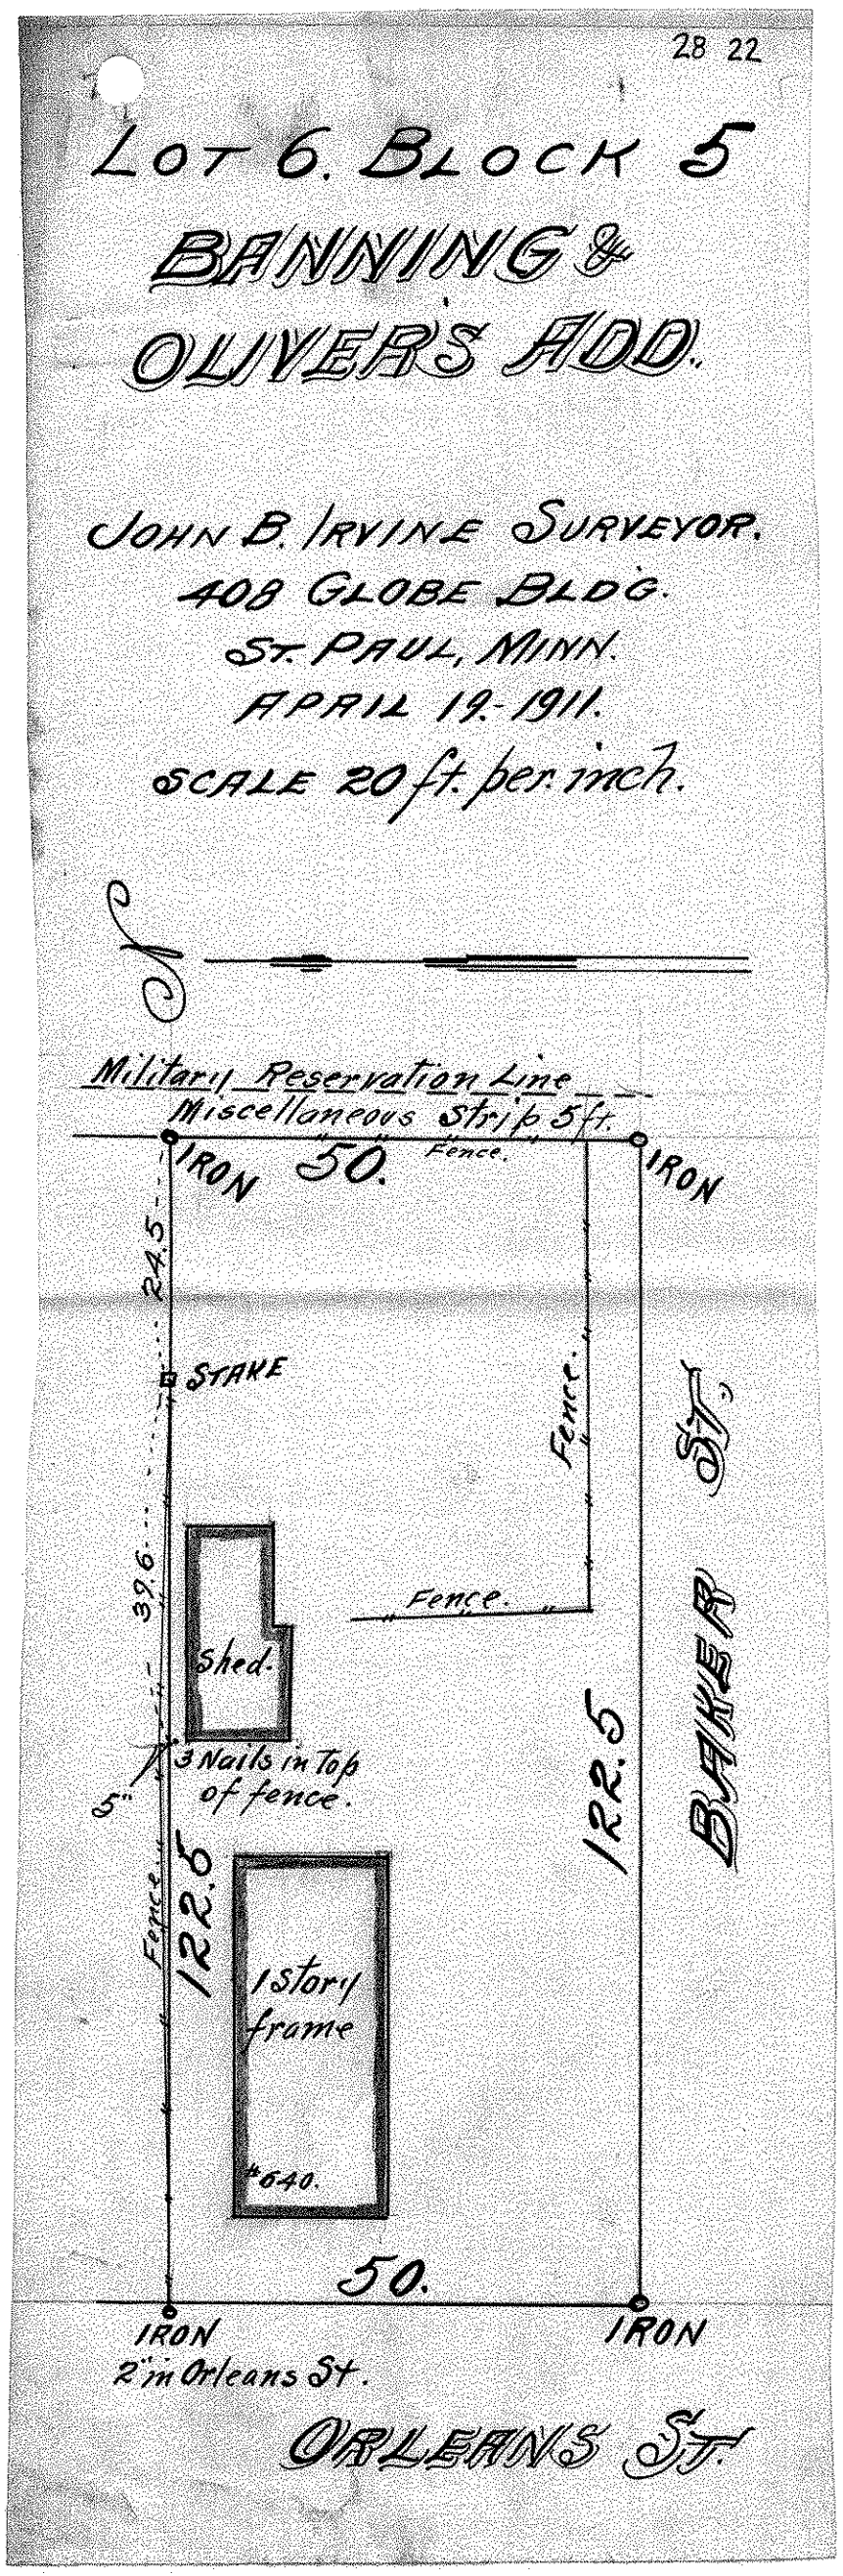
JOHN B. IRVINE SURVEYOR.
408 GLOBE BLDG.
ST. PAUL, MINN.
APRIL 19.- 1911.
SCALE 20 ft. per inch.