


LOTS 21, 22, 23 & 24
 BROOKVALE 2ND ADD.



JOHN B. IRVINE, SURVEYOR.
 408 GLOBE BLDG.
 ST PAUL, MINN.
 OCT. 17-1911.

SCALE 20 ft. per inch.

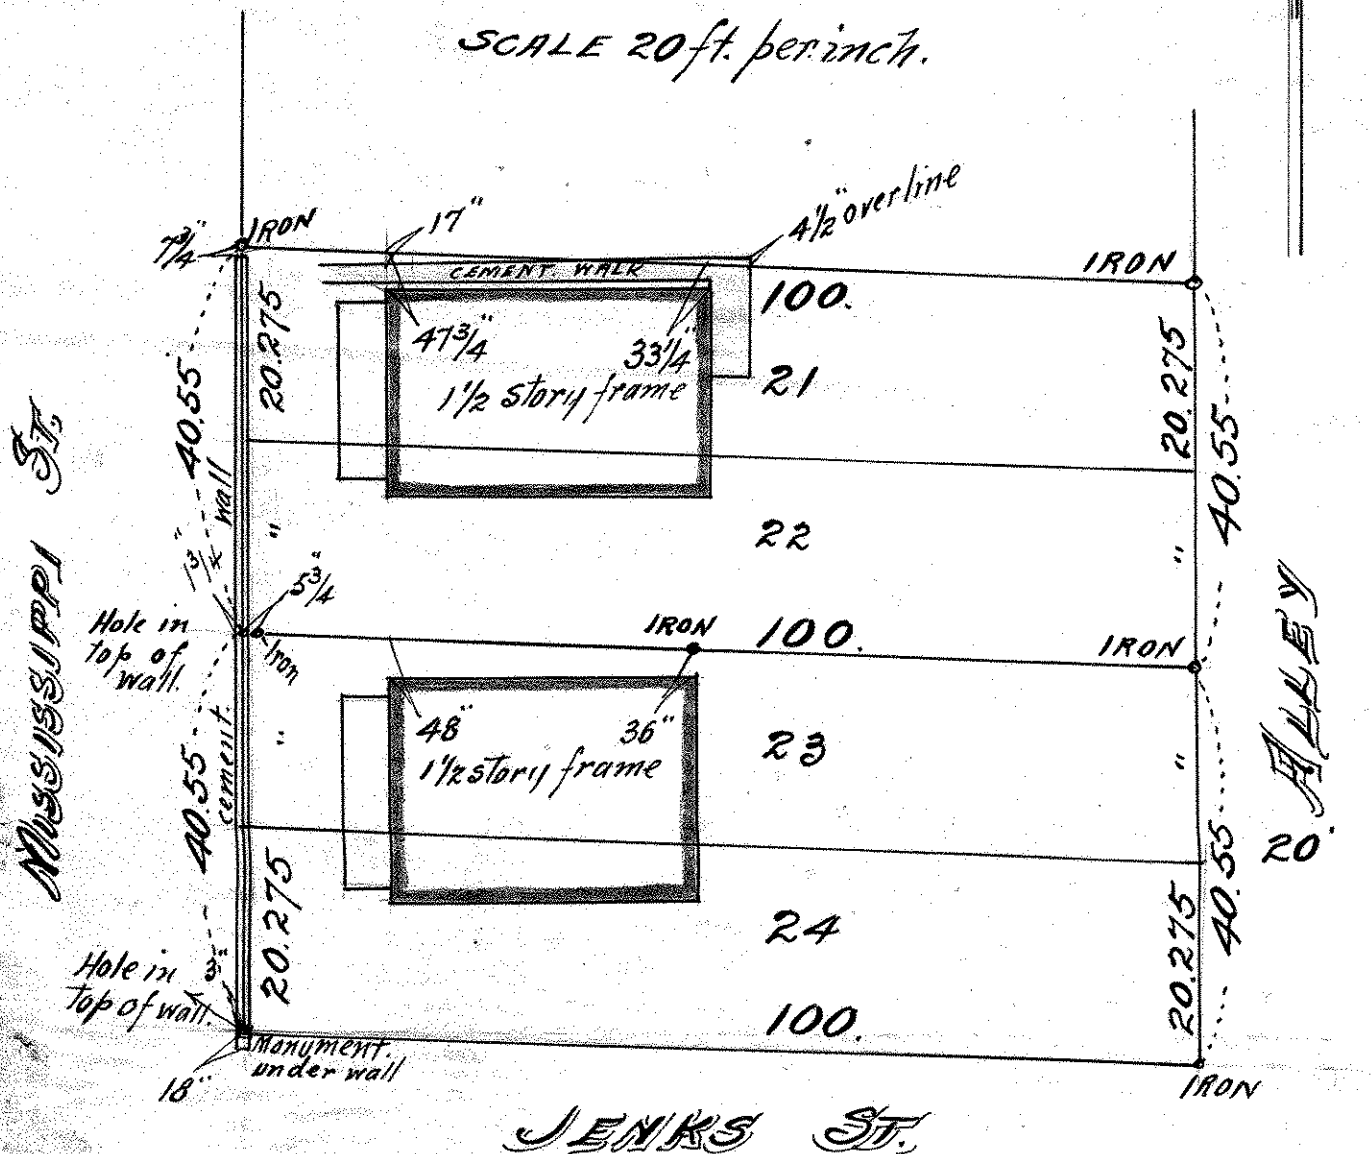

JENKS ST.