


LOT 4 BLOCK 47

BANNING & OLIVER'S ADD.

APRIL 12-1912

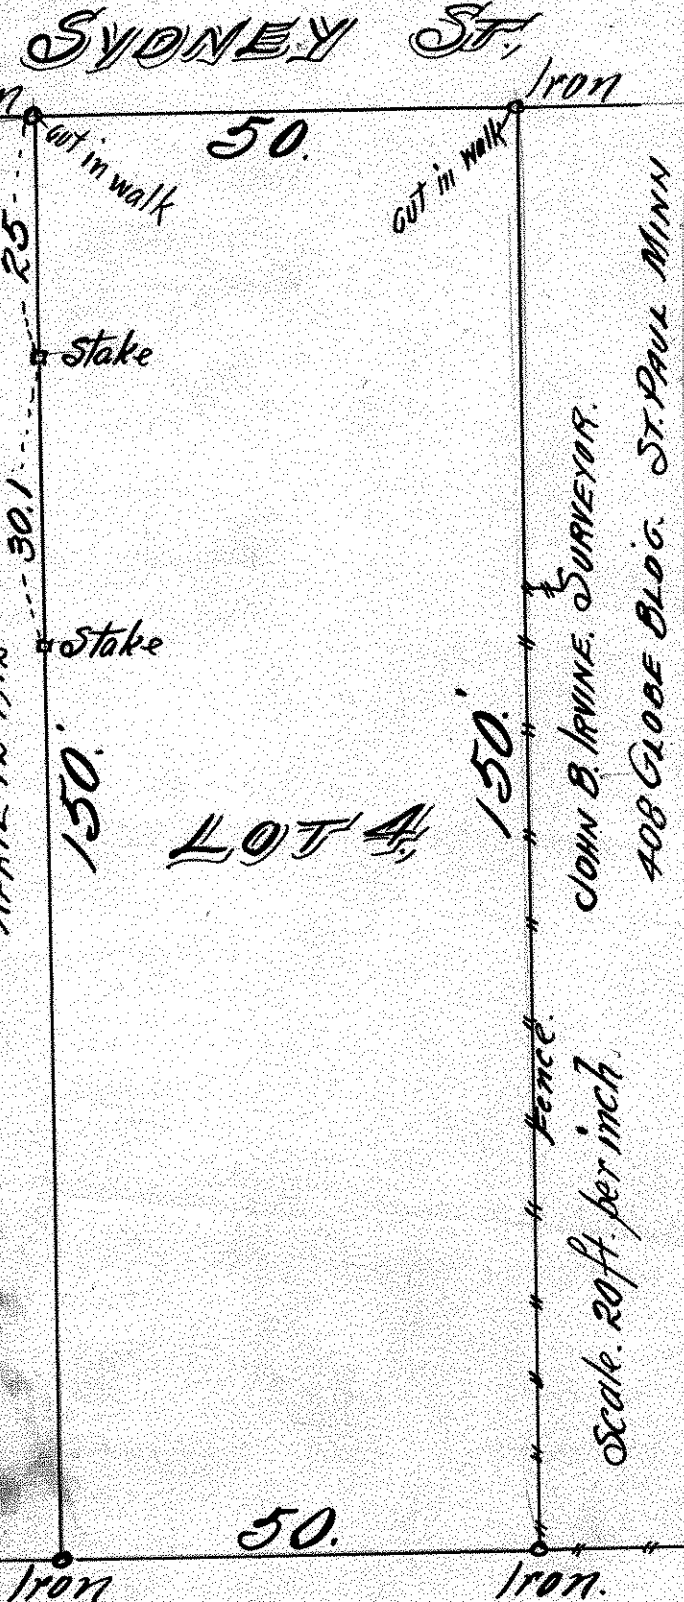

LOT 4

JOHN B. IRVINE, SURVEYOR.

408 GLOVE BLDG. ST. PAUL MINN

Scale. 20 ft. per inch.