

LOT 9 BLOCK 59.


BANNING & OLIVER'S ADD.

JOHN B. IRVINE, SURVEYOR.

408 GLOBE BLDG.

ST. PAUL, MINN.

APRIL 28-1913

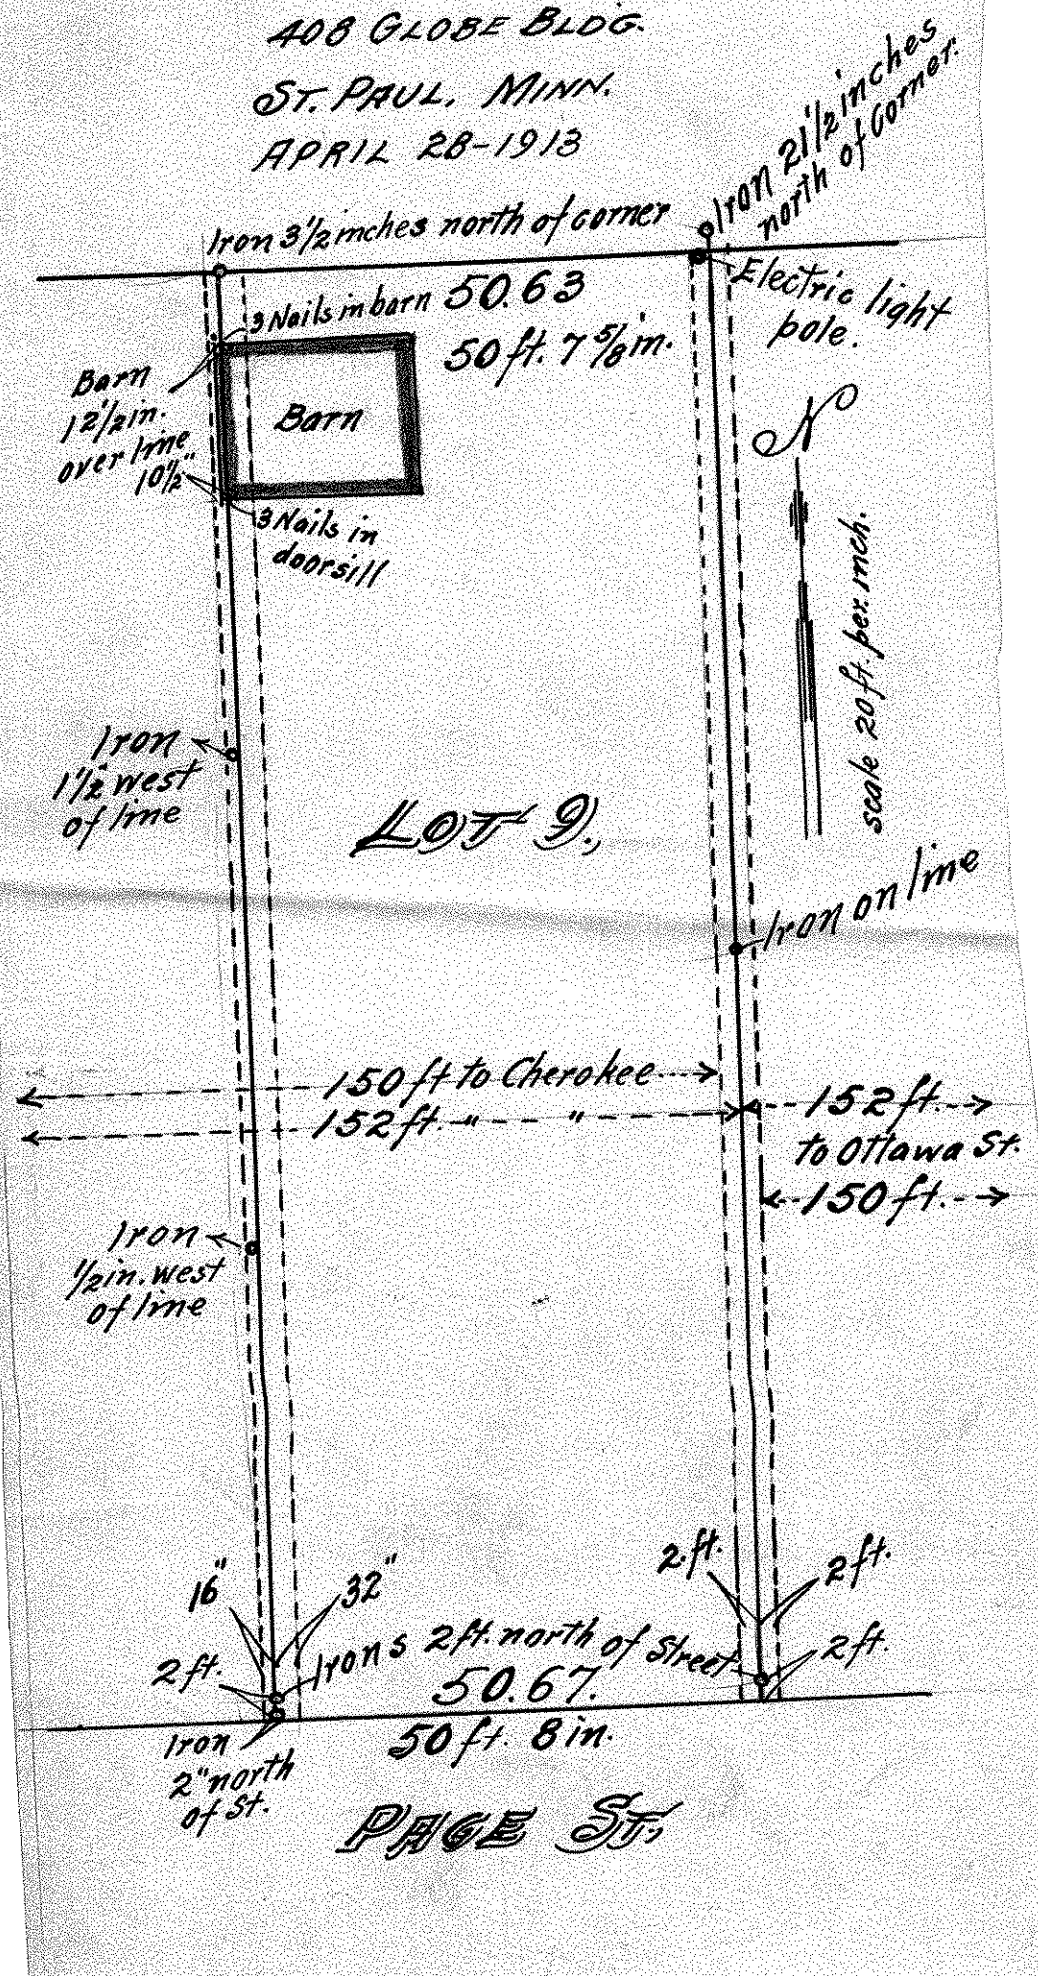

PAGE 57