


360.57 on Deluvers the line

Cherokee

360.65

300.47 pro. 150. nt

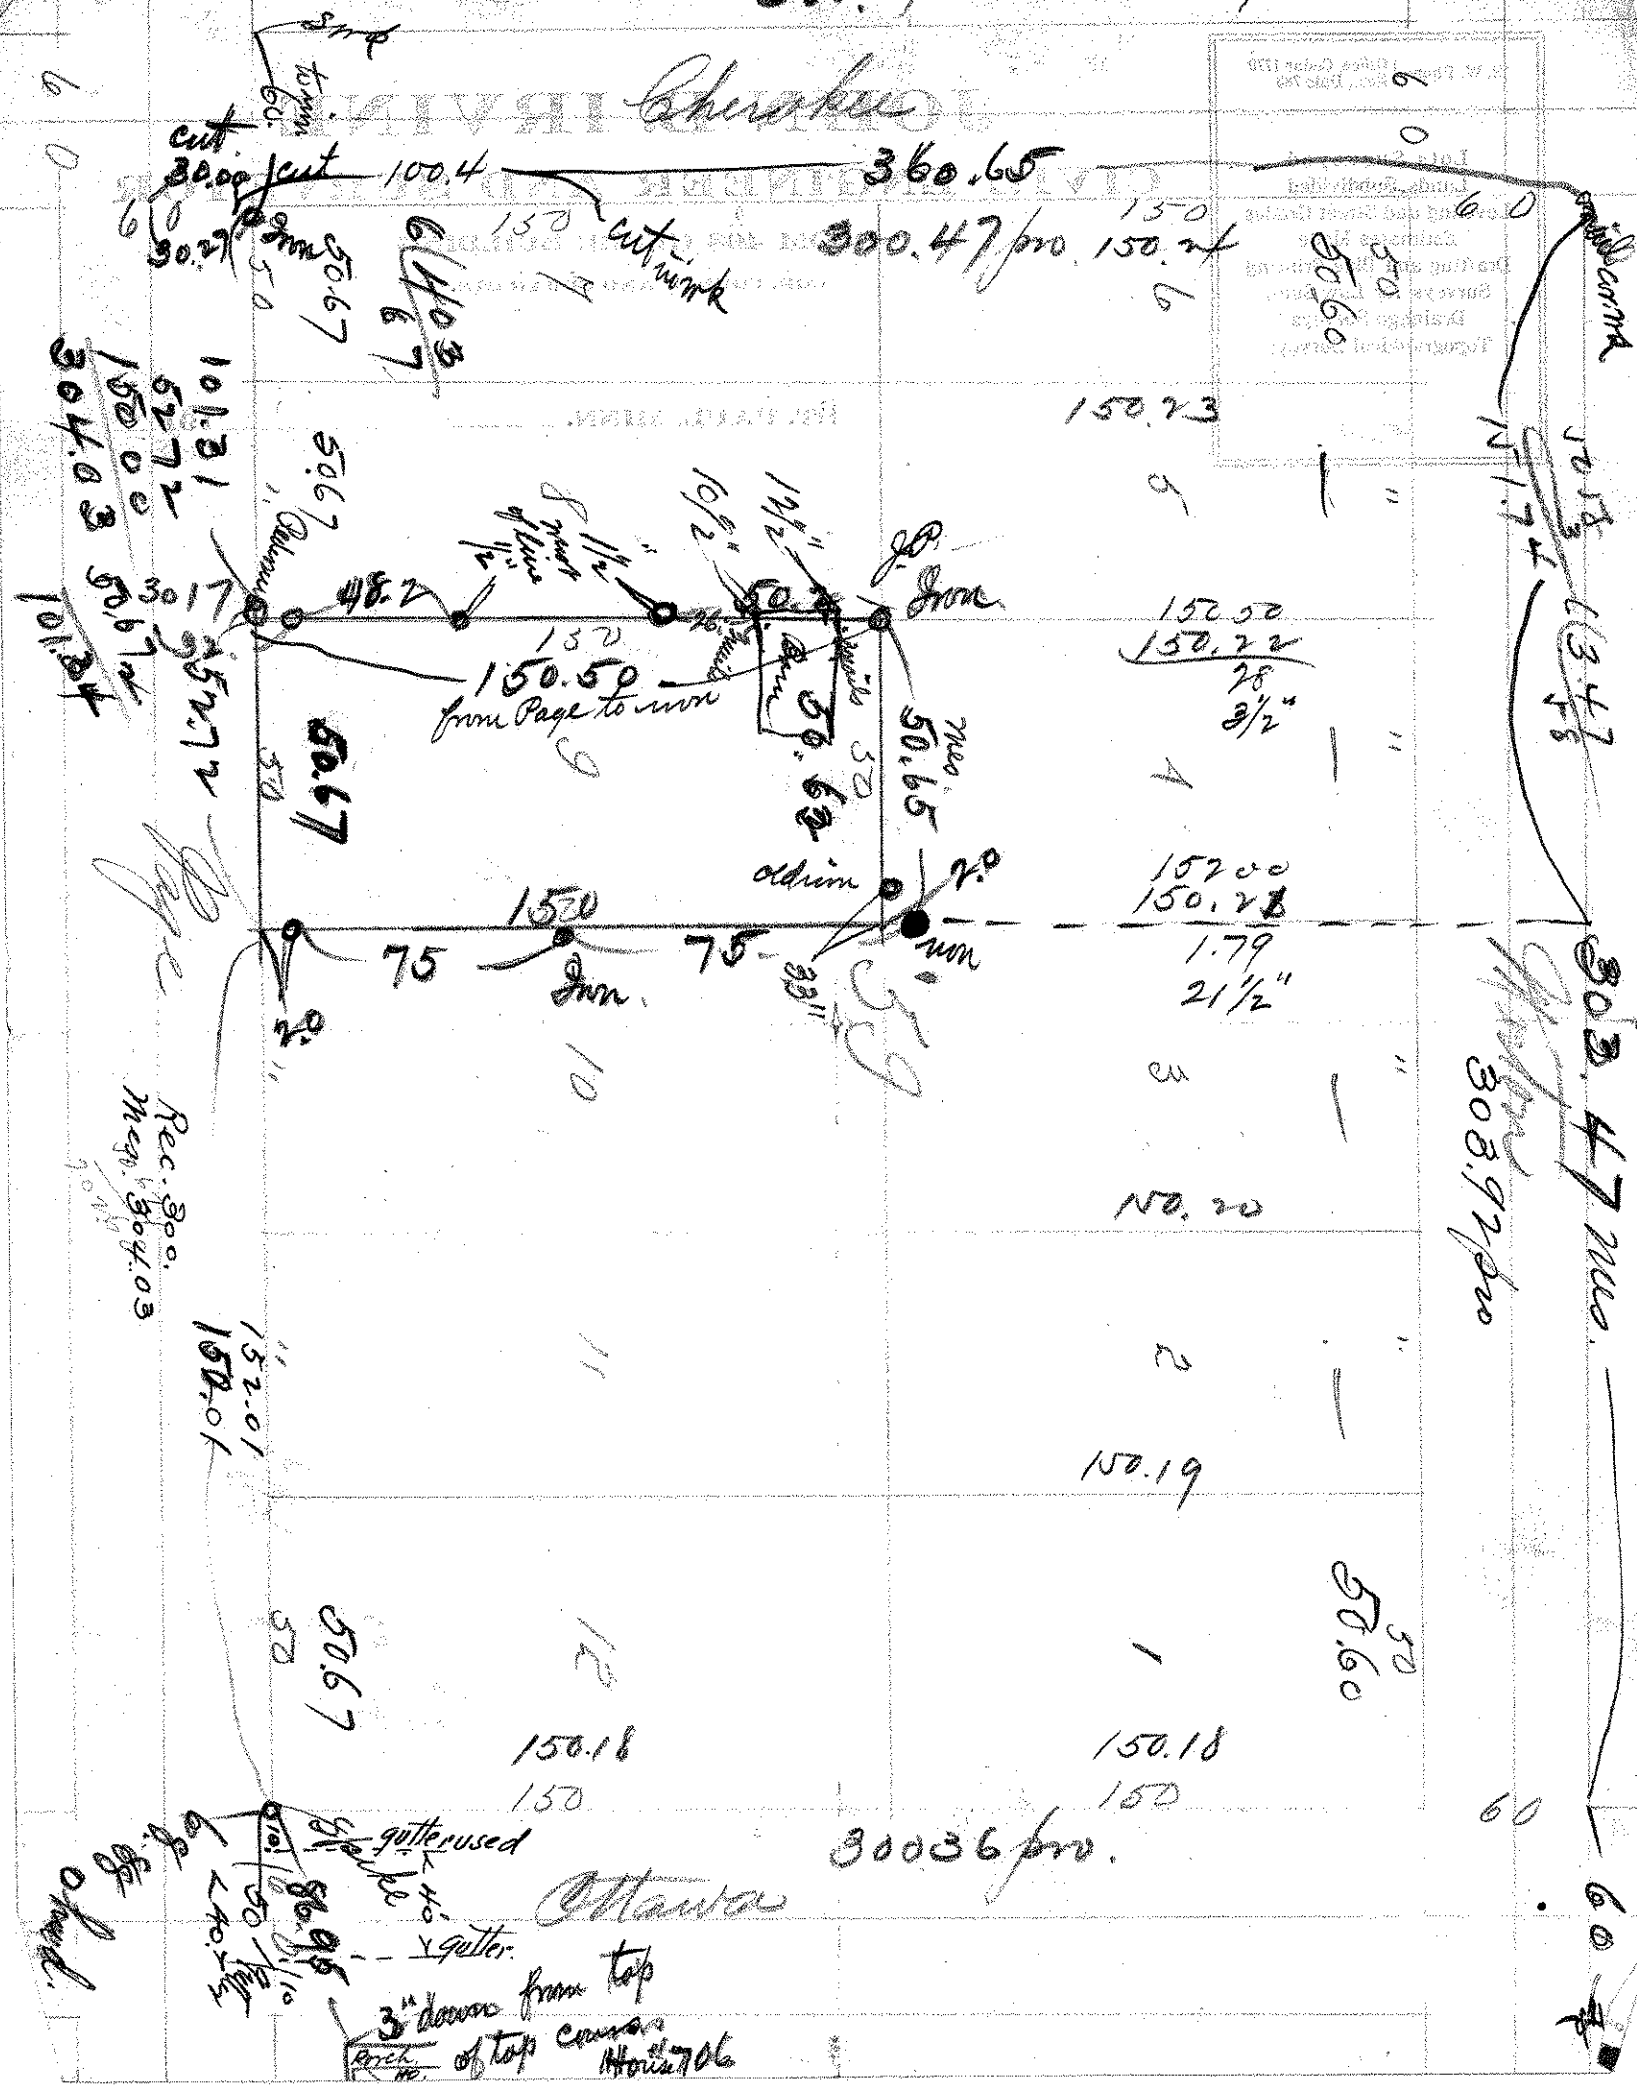

cut 30.00 feet
50.27
50.67

6140.3
667

101.31
52.72
150.00
304.03
50.67
101.34

506.7
506.7
506.7

150.50
from Page to work

50.65
50.62
50.67

150.73

152.52
150.72
28
2 1/2

152.00
150.78
1.79
2 1/2

150.20

150.19

150.18

150

50.60
50

30036 pro.

Ottawa

3" down from top
of top course
Hous 706

151.74
163.43

303.47 me.
303.92 pro

60.4