


SURVEY OF LOTS 1, 2, 3, 4 & 7 MEYER & PETER'S BALD EAGLE GARDEN LOTS  
MAY 1913

Scale 100 feet per inch  
J. H. Armstrong L. E.

7-710  
#818 F

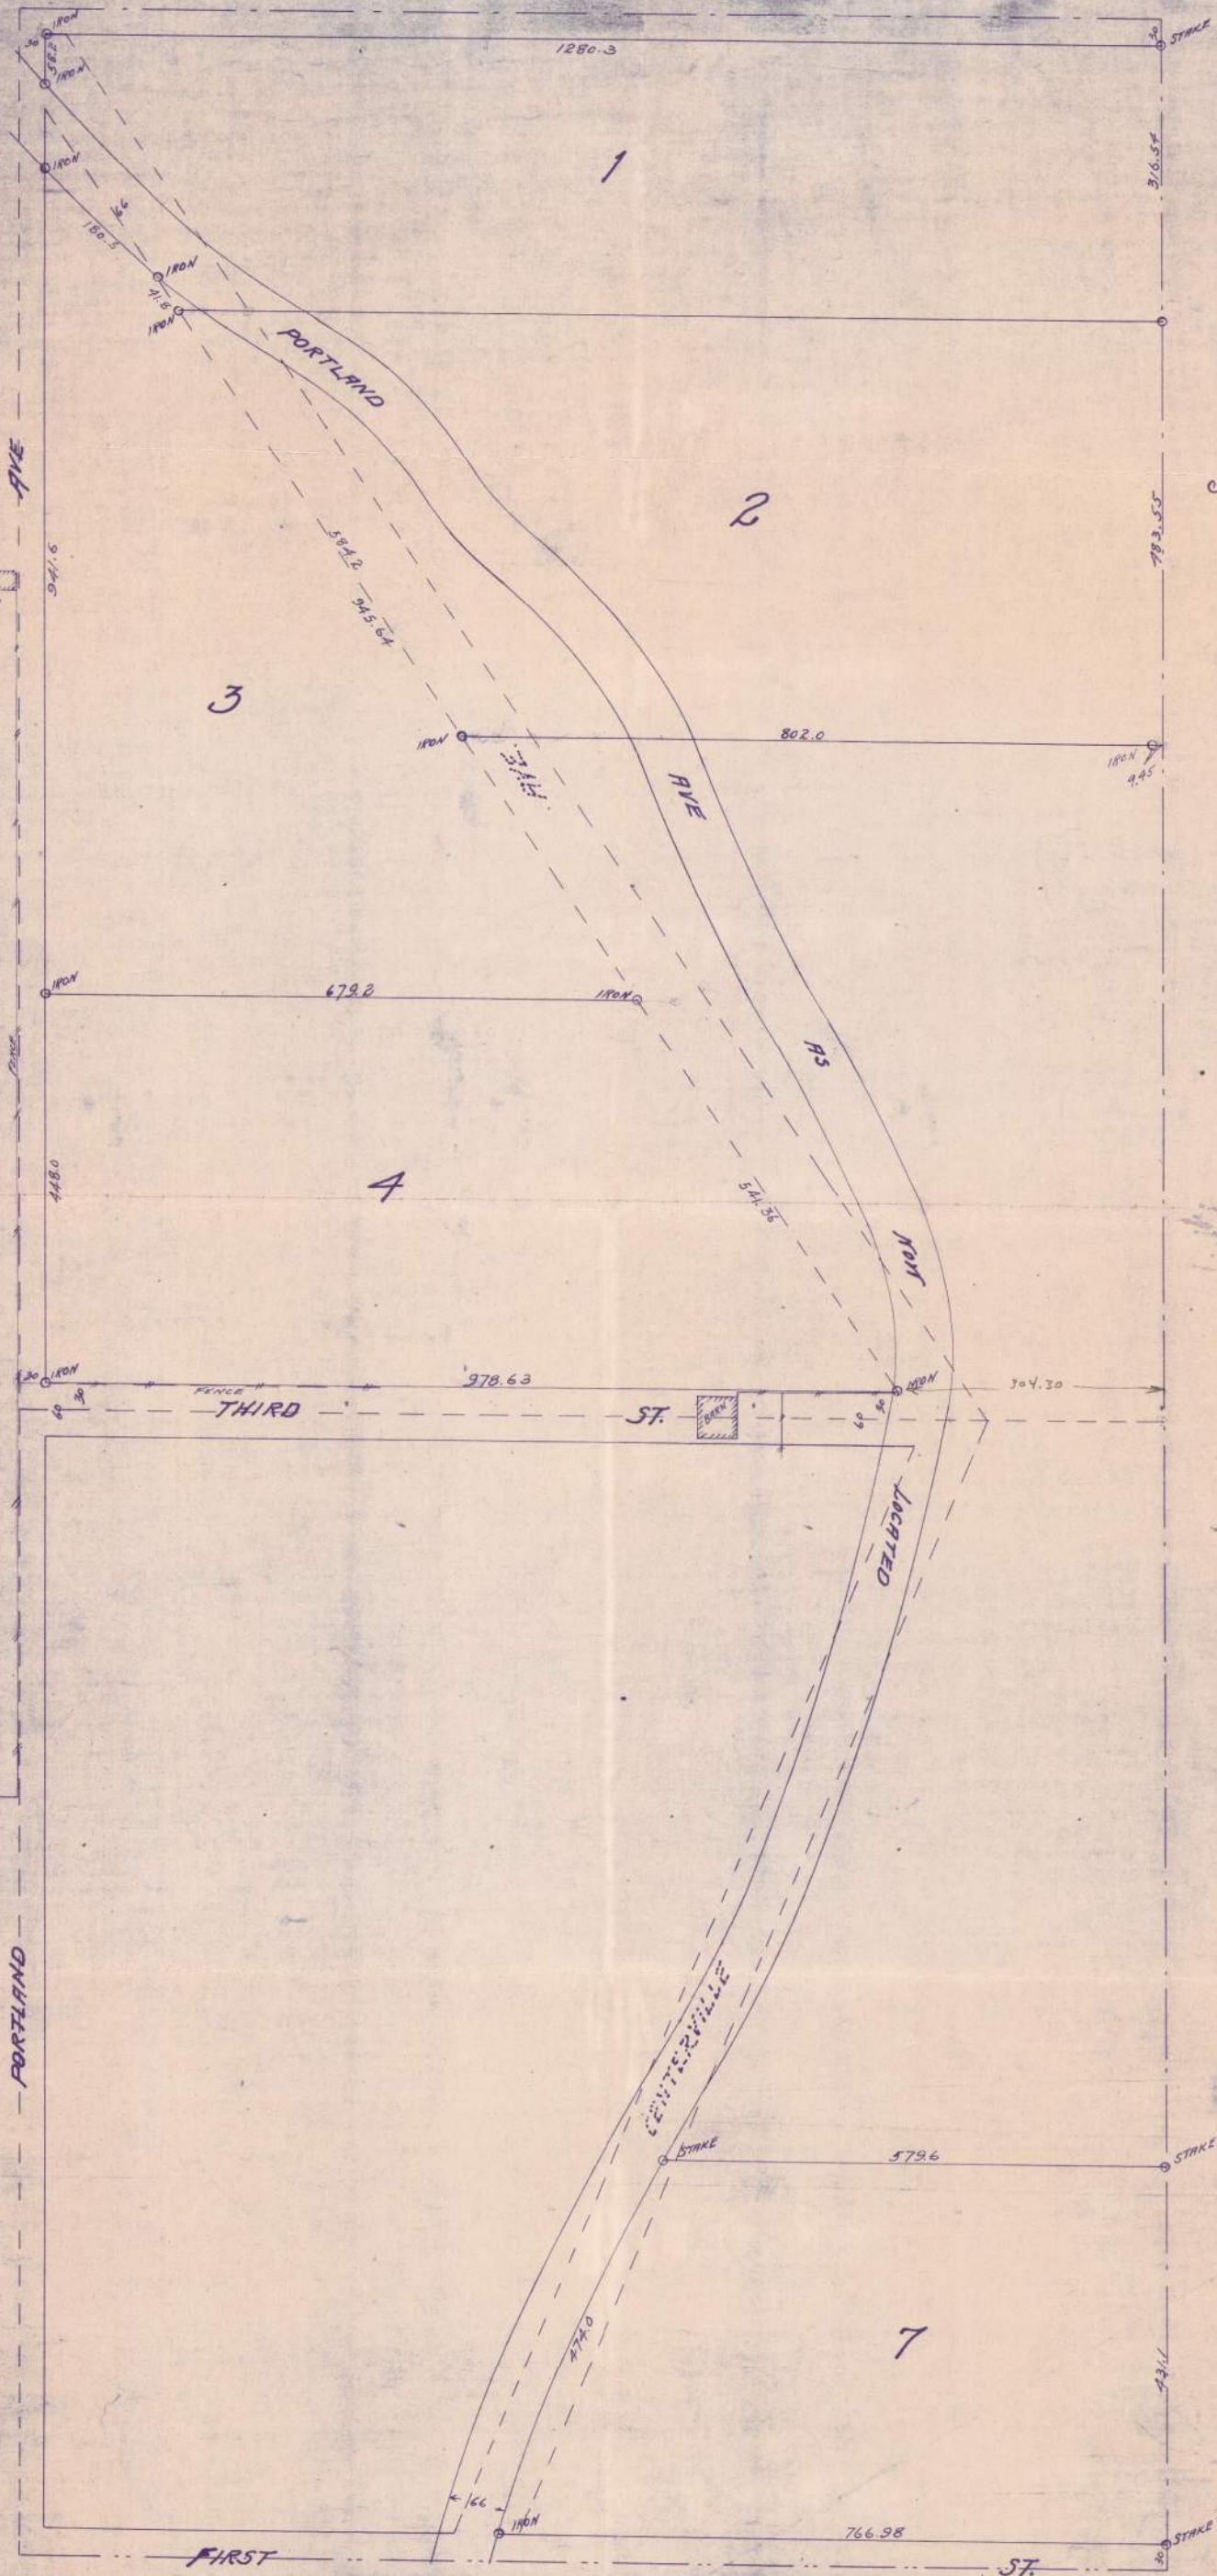

7-470

7-710