WEST 1/2 N.E. 1/4 N.W. 1/4 SECTION 12. T. 30. R. 22.
Lying on the east side of the center line of a certain
old Railroad bed running diagonally through said N.E. 1/4

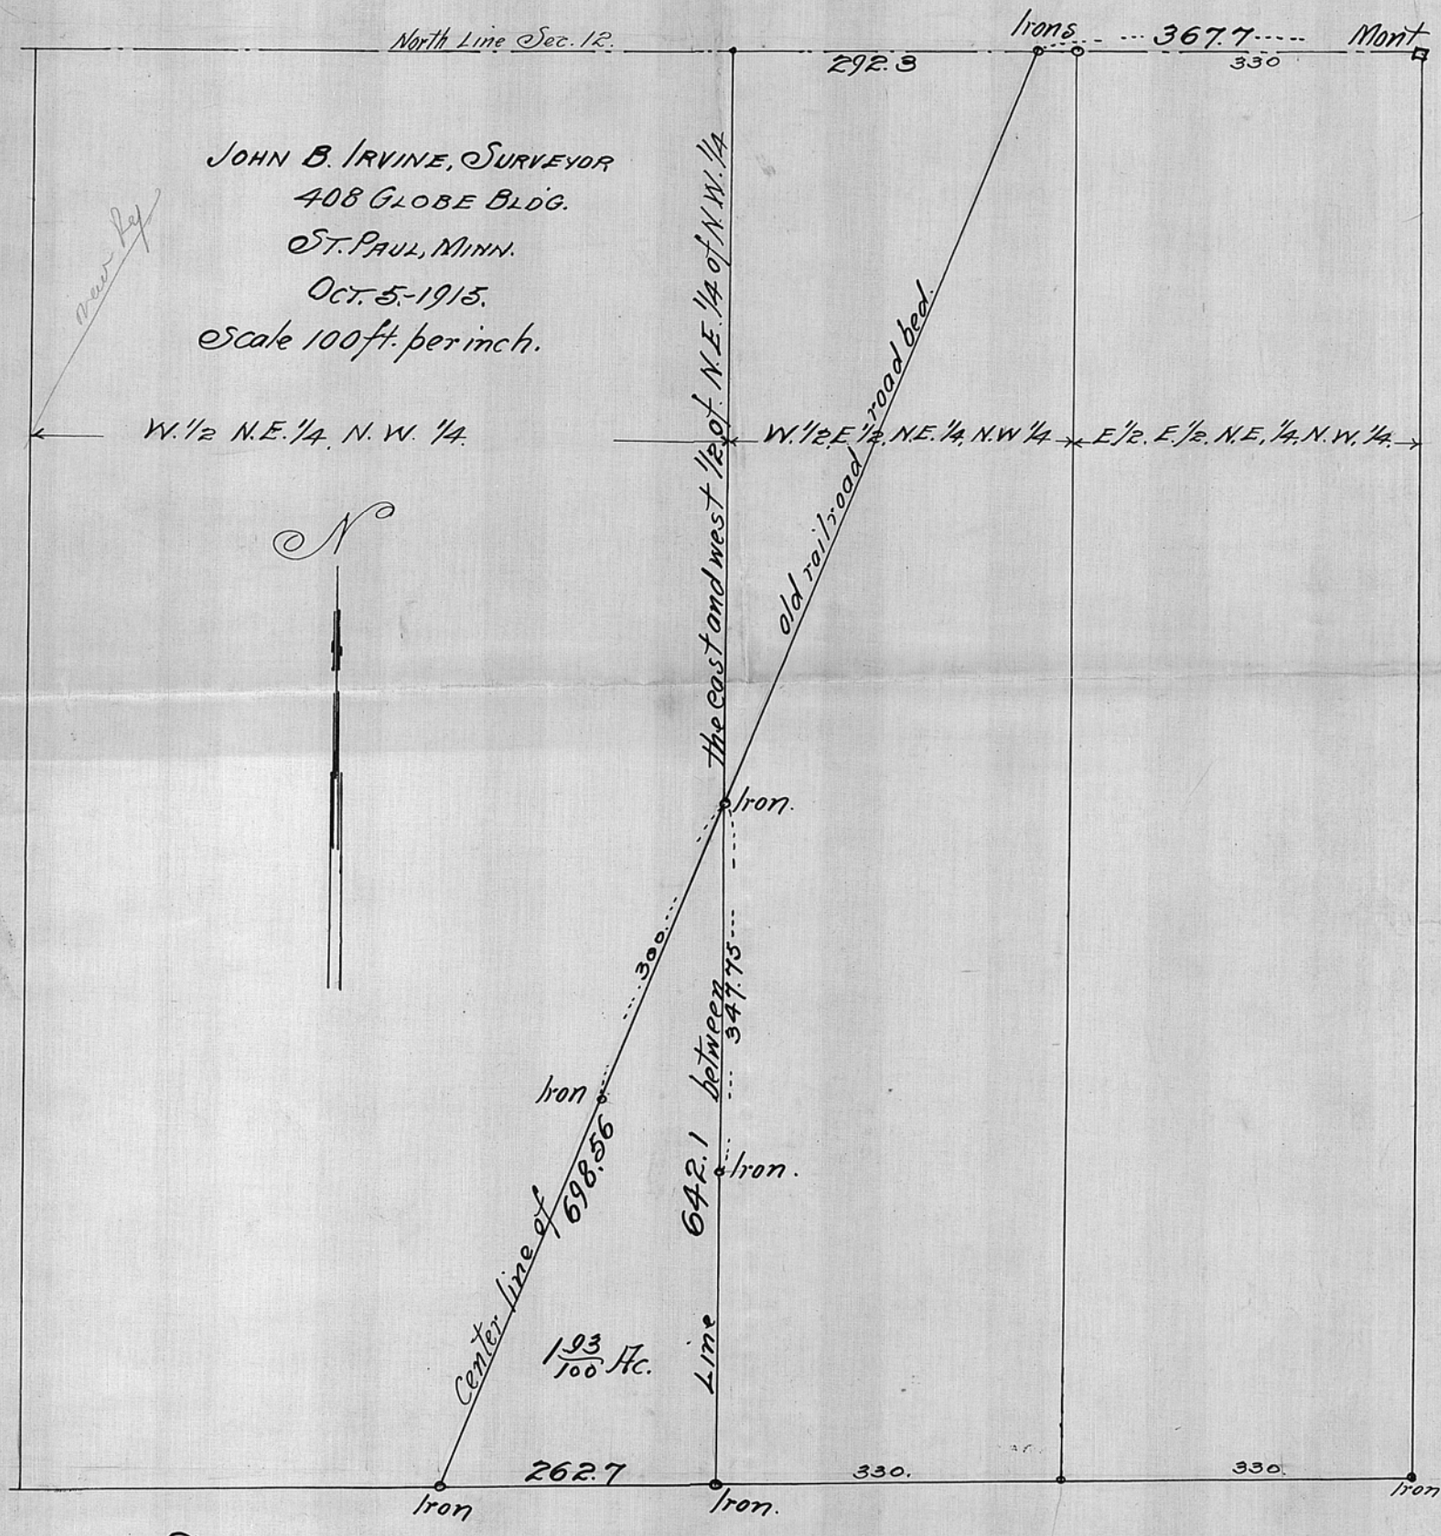

BUFFALO ST.