

LOTS 12, 13, 14, 15 & 16.

AUDITORS SUB NO 17.

SCALE 20 FT PER INCH

MARCH 6-1915

J. B. IRVINE.
SURVEYOR.
BY E. P. SCHAFER.

LOTS 7, 8 & 9 BLOCK 2. DORE'S ADD.


SCALE 20 FT PER INCH.

MARCH 6-1915

J. B. IRVINE.
SURVEYOR.
BY E. P. SCHAFER.

ST.

RICE

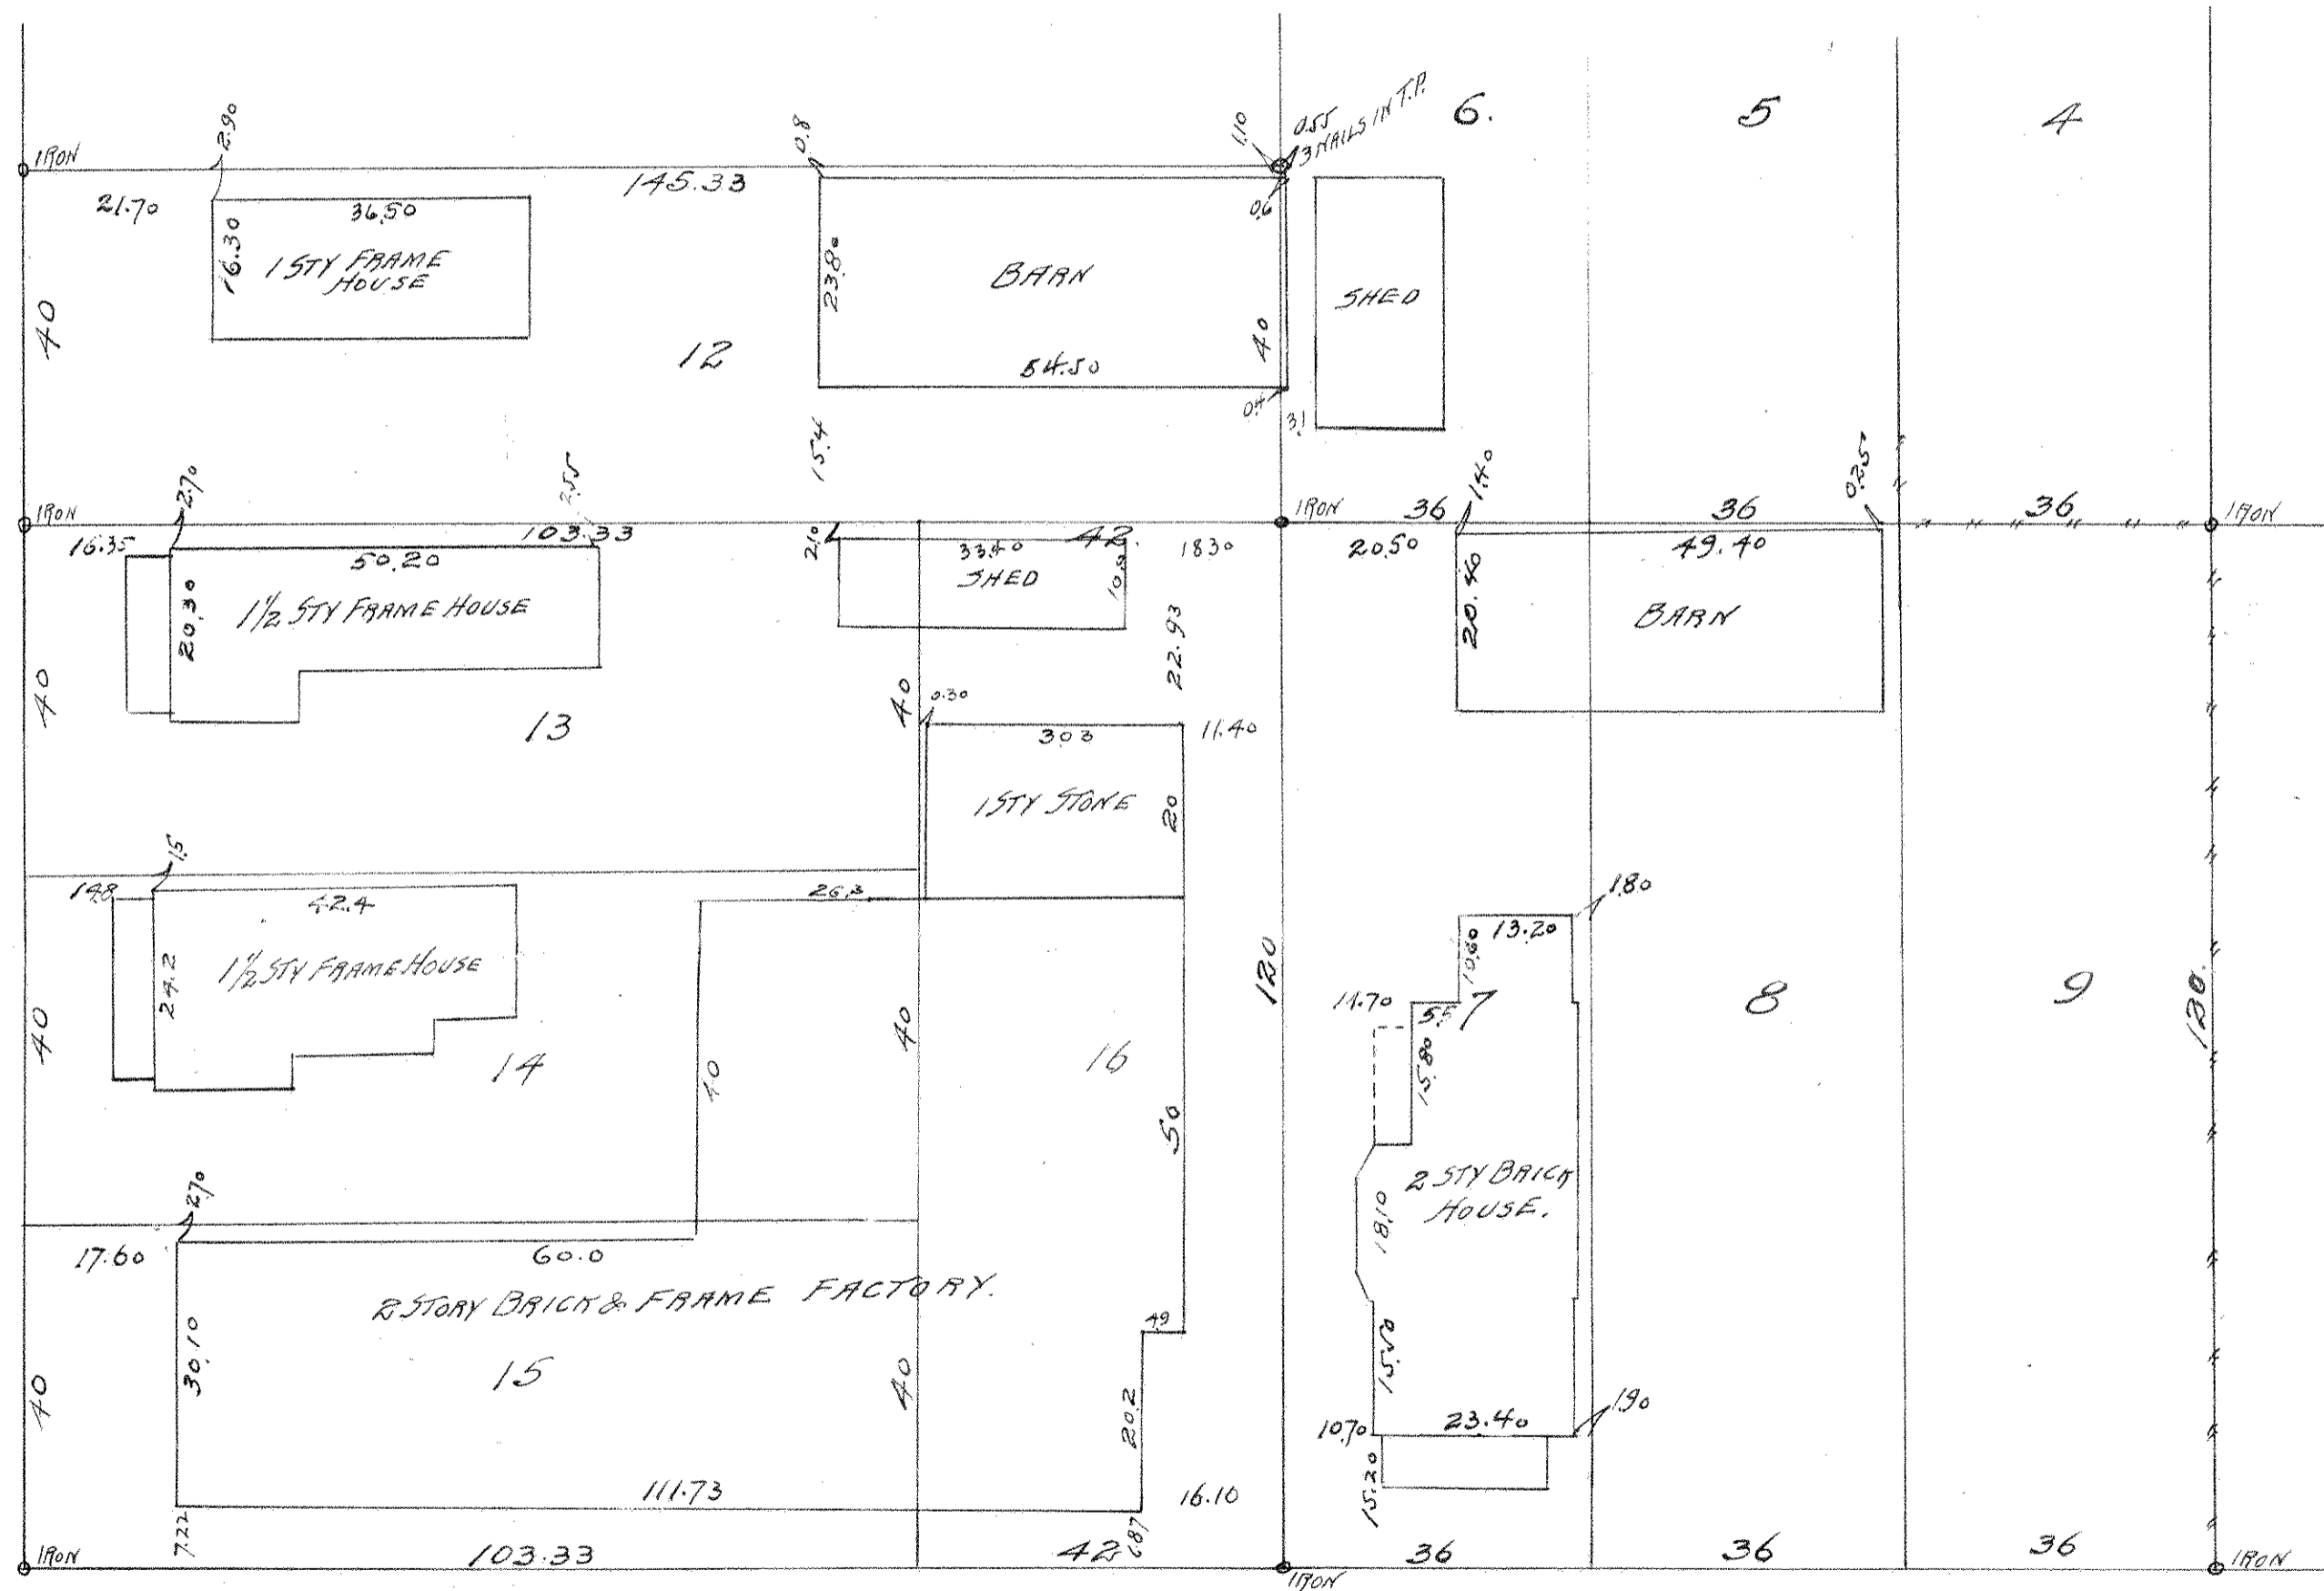

FRONT

ST.