


BENEDICTINE PLAT I.

JOHN B. IRVINE. SURVEYOR.

MAY 11, 1915

Scale 50 ft. per inch.

INDICATES IRONS.

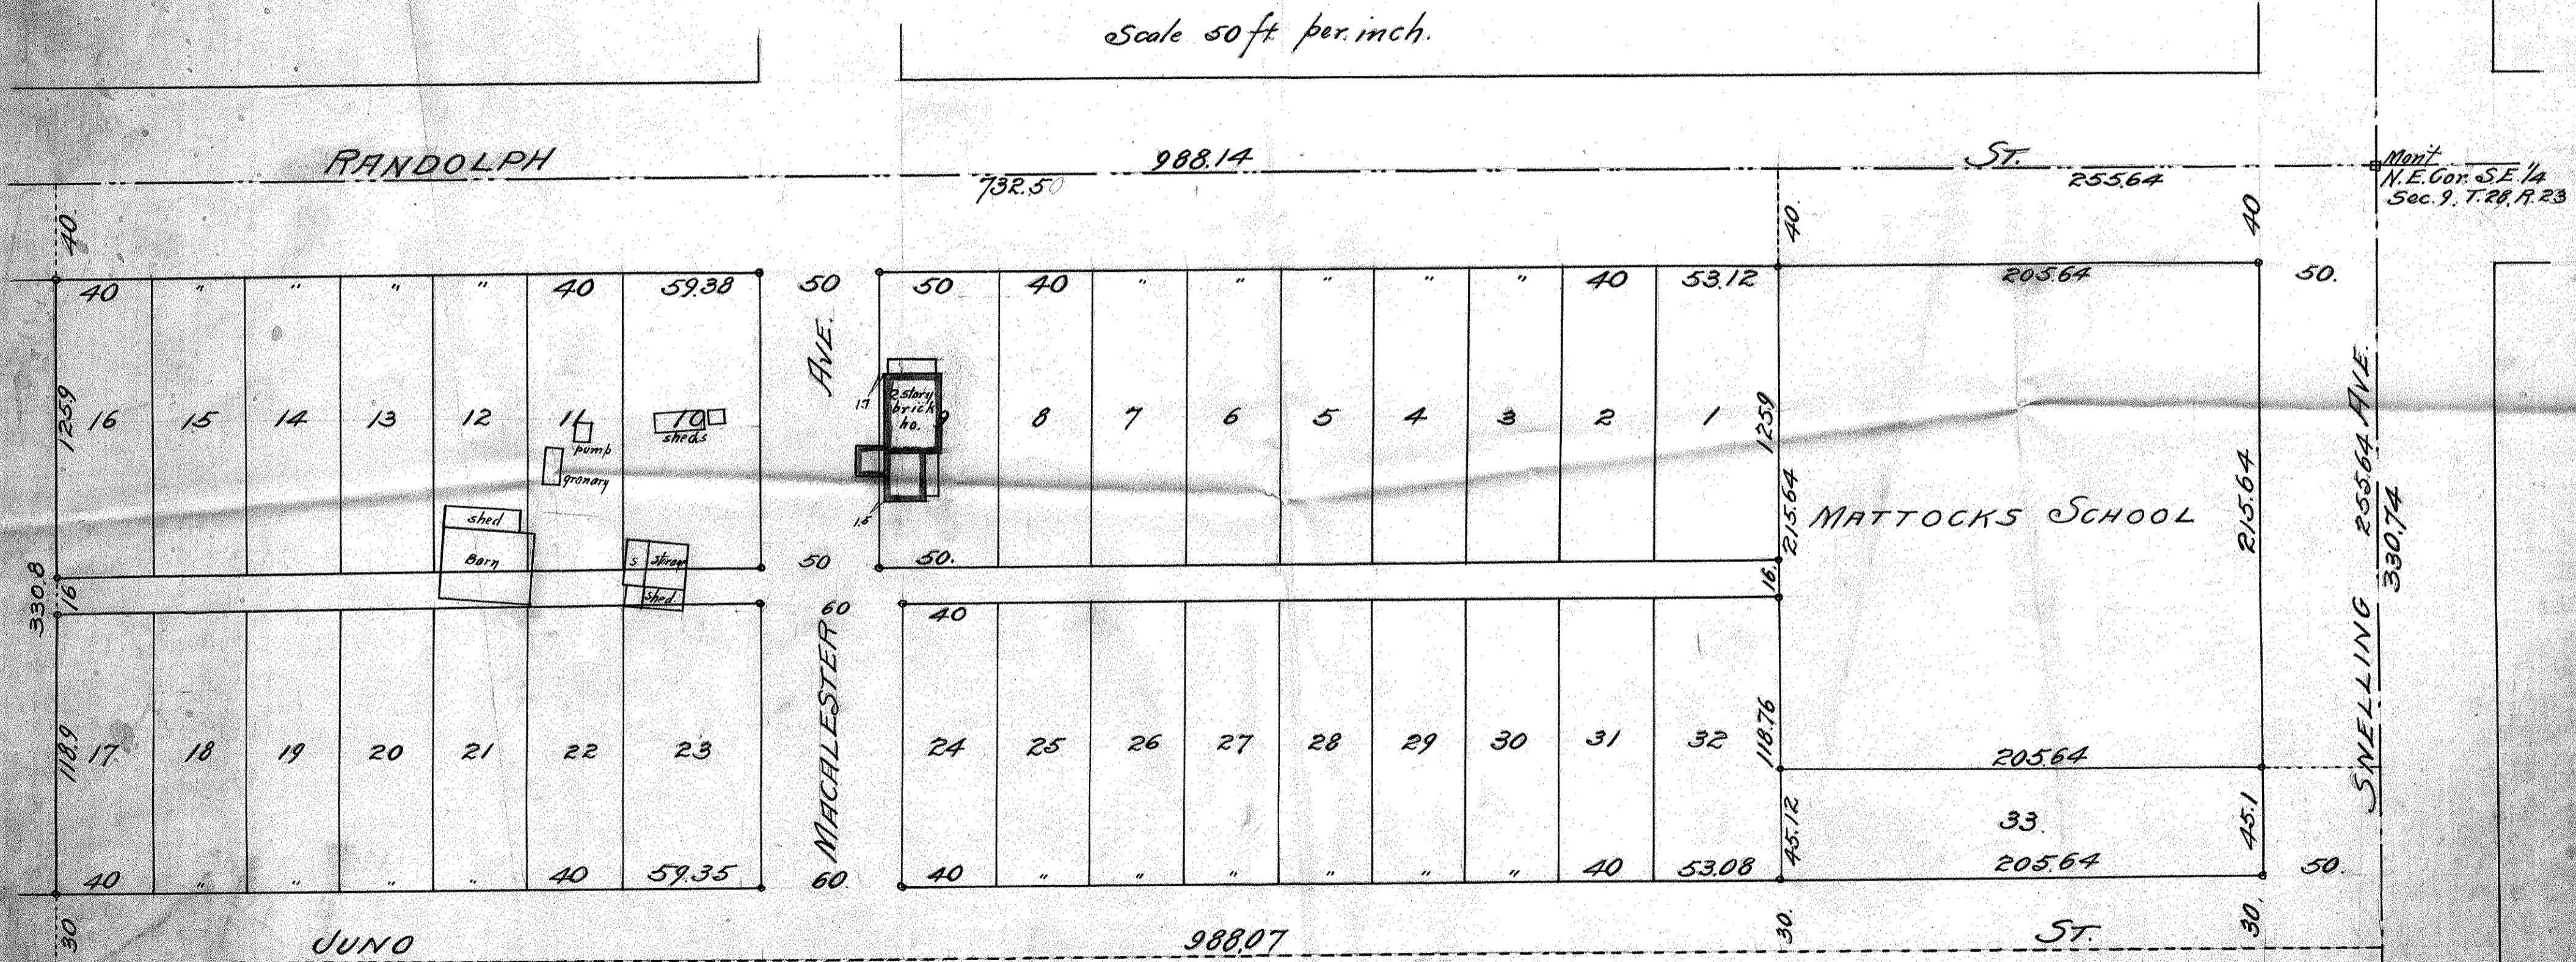

Mon't
N.E. Cor. S.E. 1/4
Sec. 9, T. 28, R. 23

MATTOCKS SCHOOL

SNELLING 255.64 AVE.
330.74