LOT 8 BLOCK 3

BERGHOLTZ'S RE-AR.

JOHN B. IRVINE. SURVEYOR.

JUNE-1-1916.
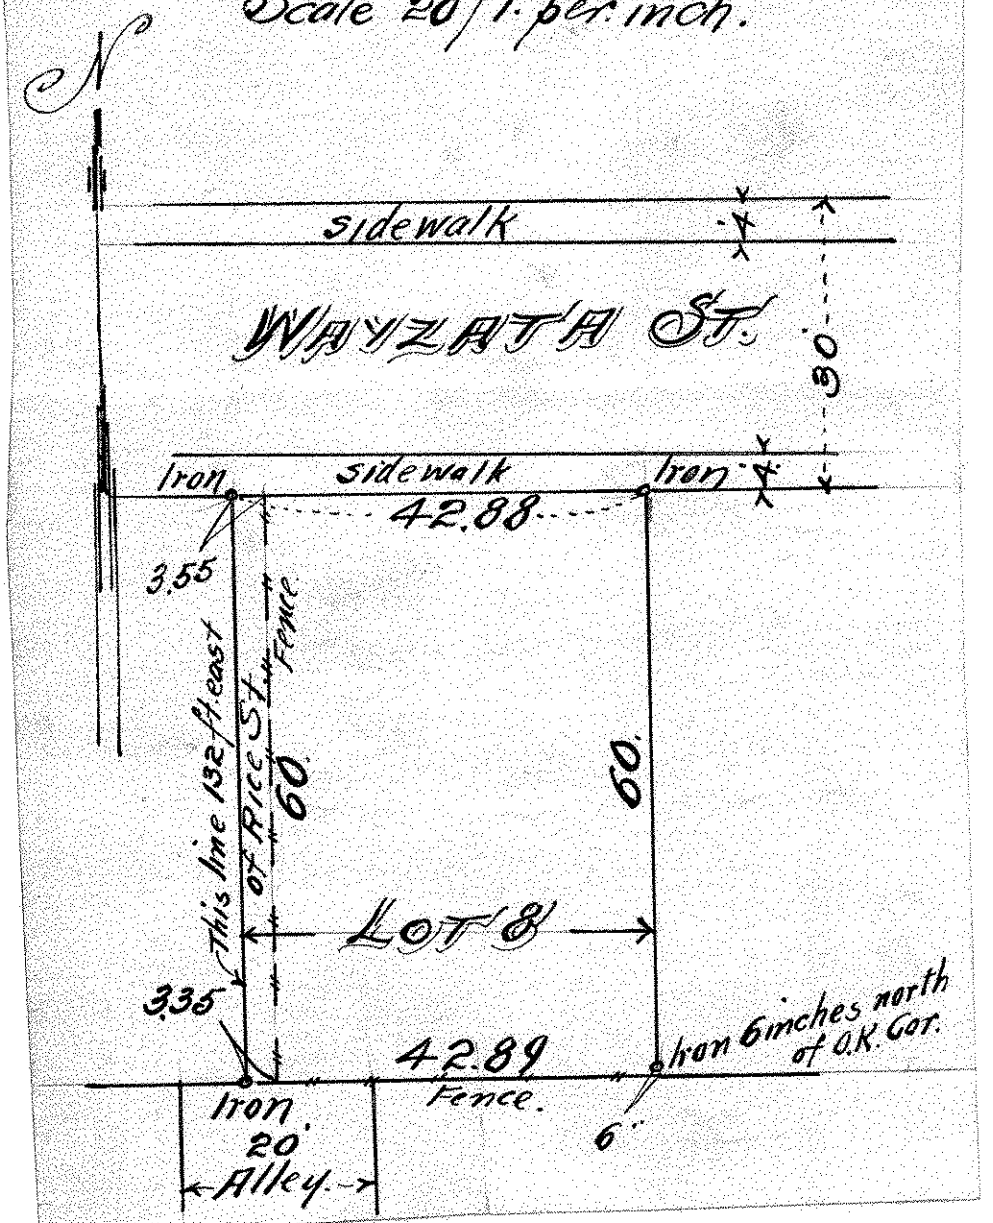
Scale 20 ft. per inch.