31 29 22

THE W'LY 79.04 ft. of E'LY 99.04 ft.
LOTS 3-11-12. BLOCK 14
ROBERT & RANDALL'S ADD.
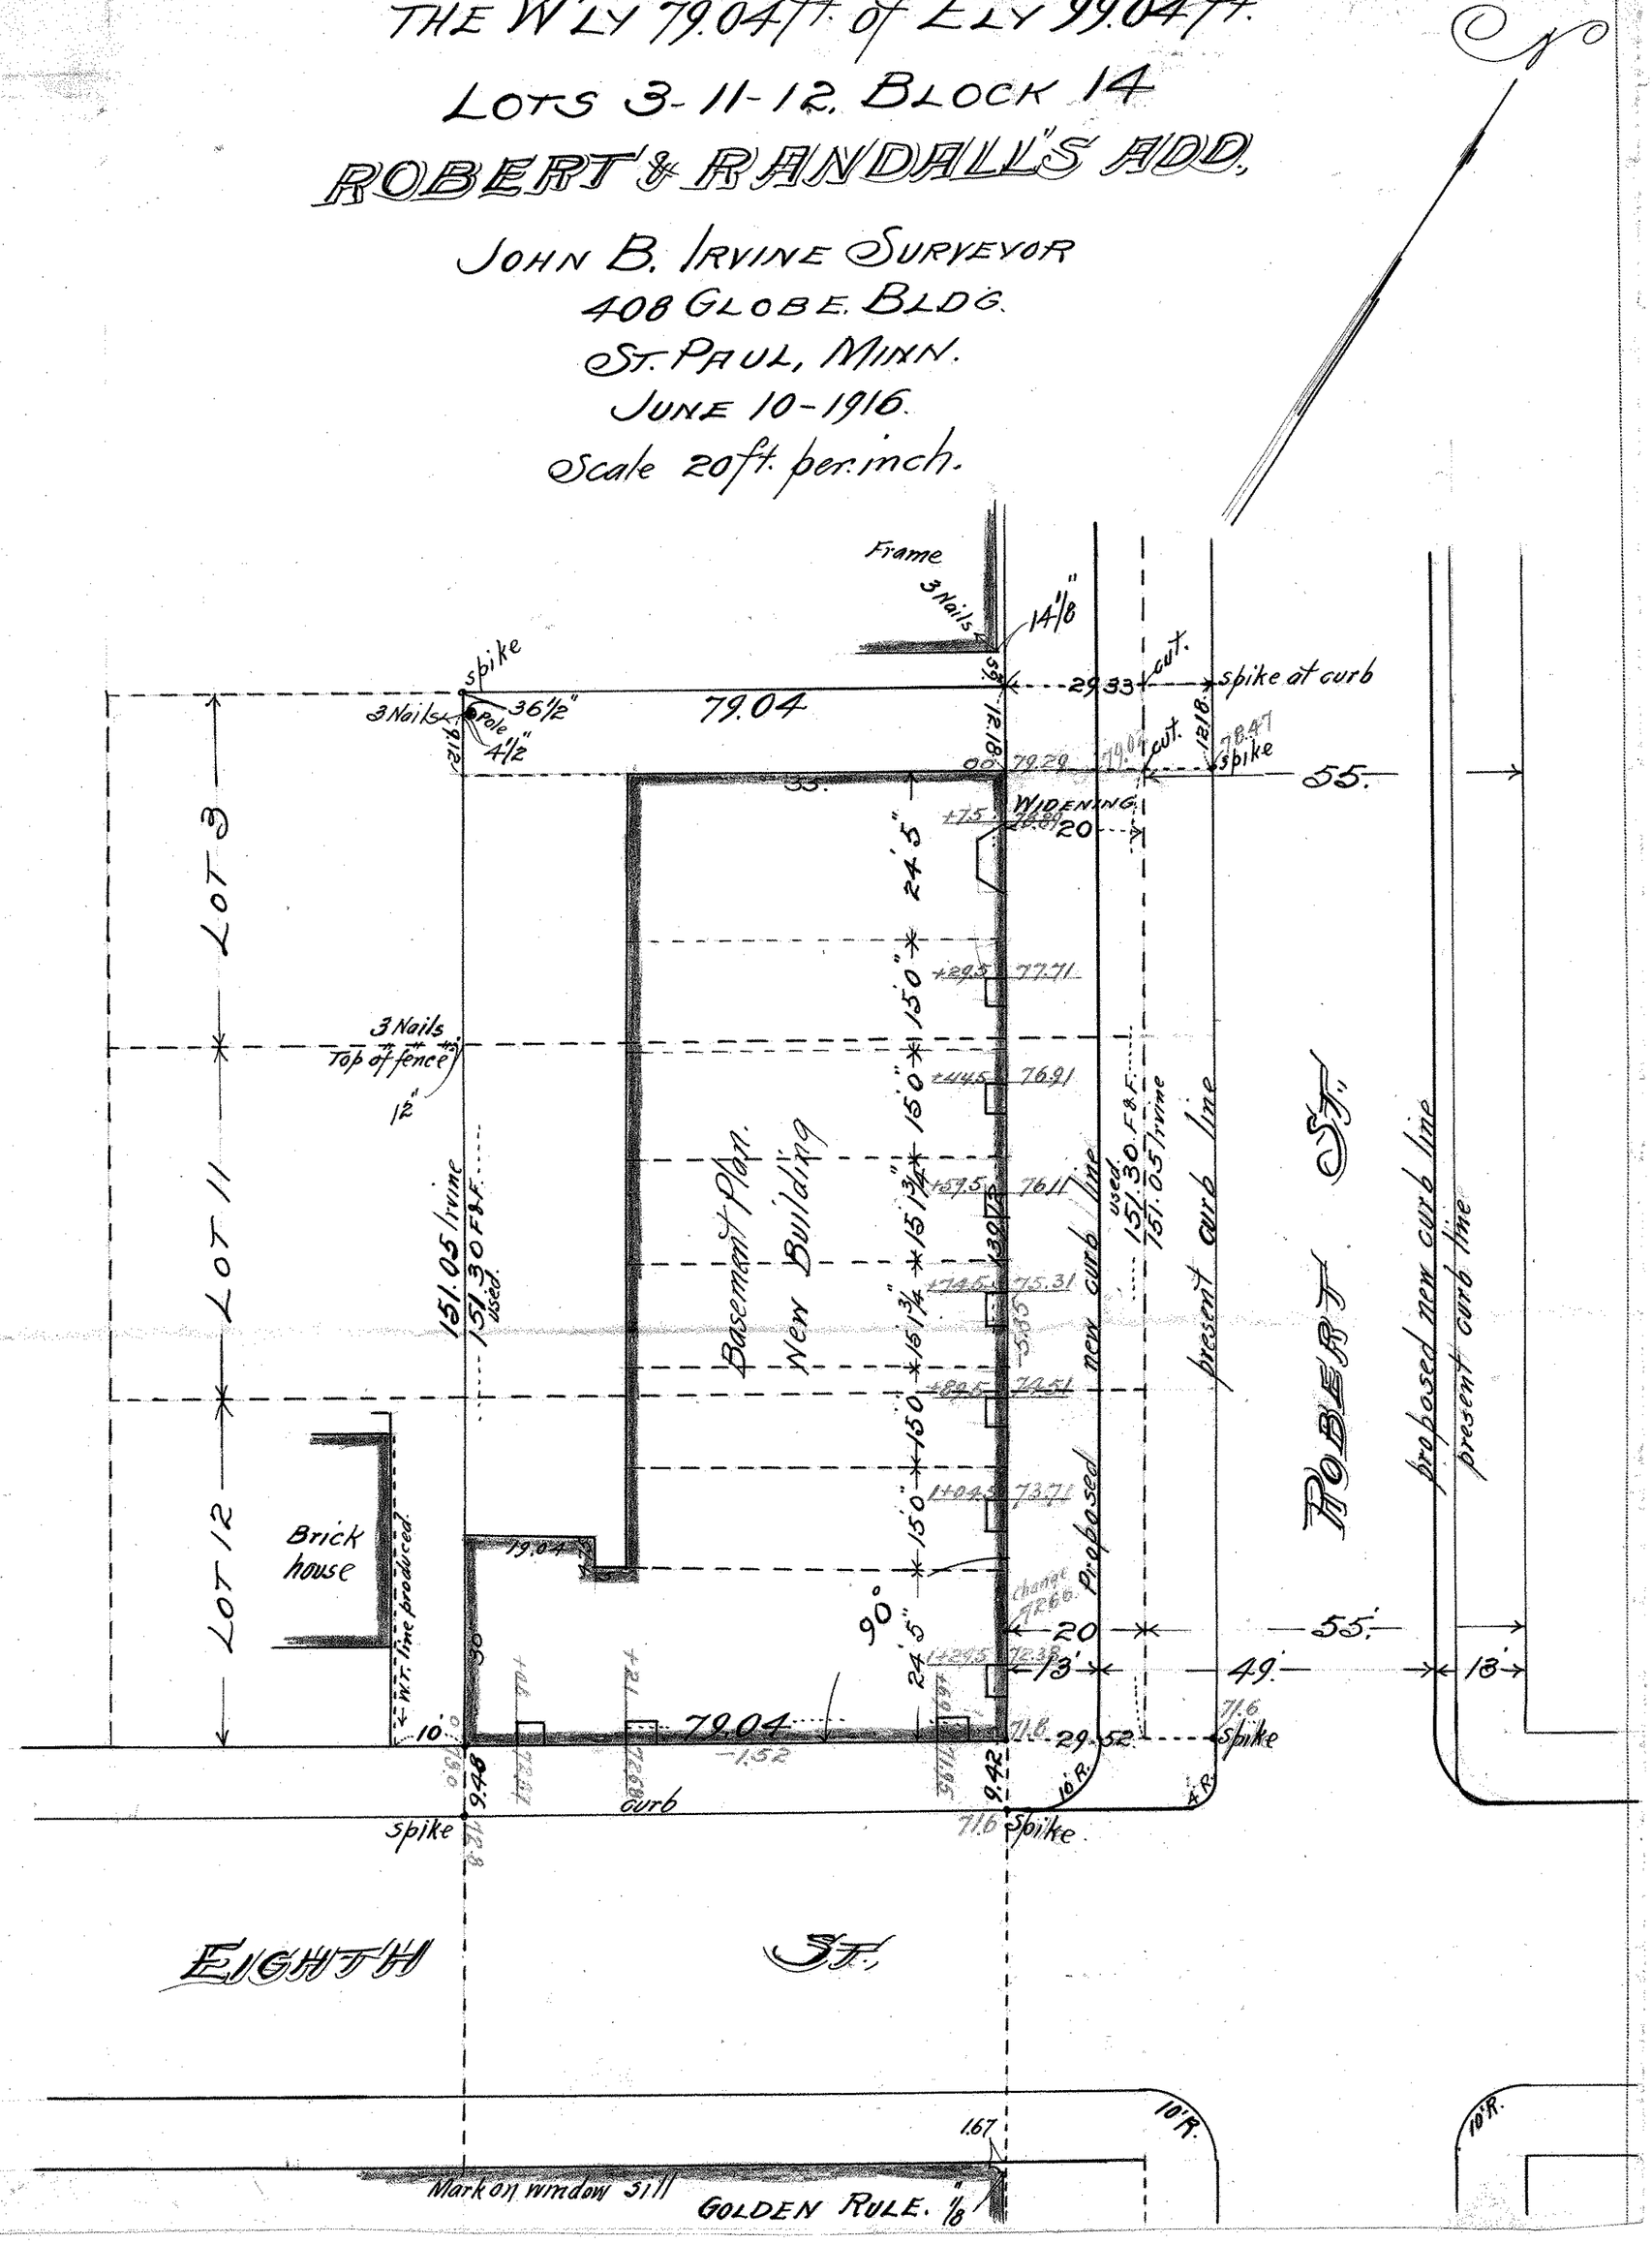
JOHN B. IRVINE SURVEYOR
408 GLOBE BLDG.
ST. PAUL, MINN.
JUNE 10-1916.
Scale 20 ft. per inch.