



EUGENE MARIEN
 N.E. 1/4 N.E. 1/4 SEC. 23. T. 28. R. 22.
 EXCEPT SOUTH 10 ACRES
 1301.43

B.K. FRANSON
 south 10 acres

SINA FRANSON
 S.E. 1/4 S.E. 1/4 SEC. 23. T. 28. R. 22.
 EXCEPT August Johnson's part

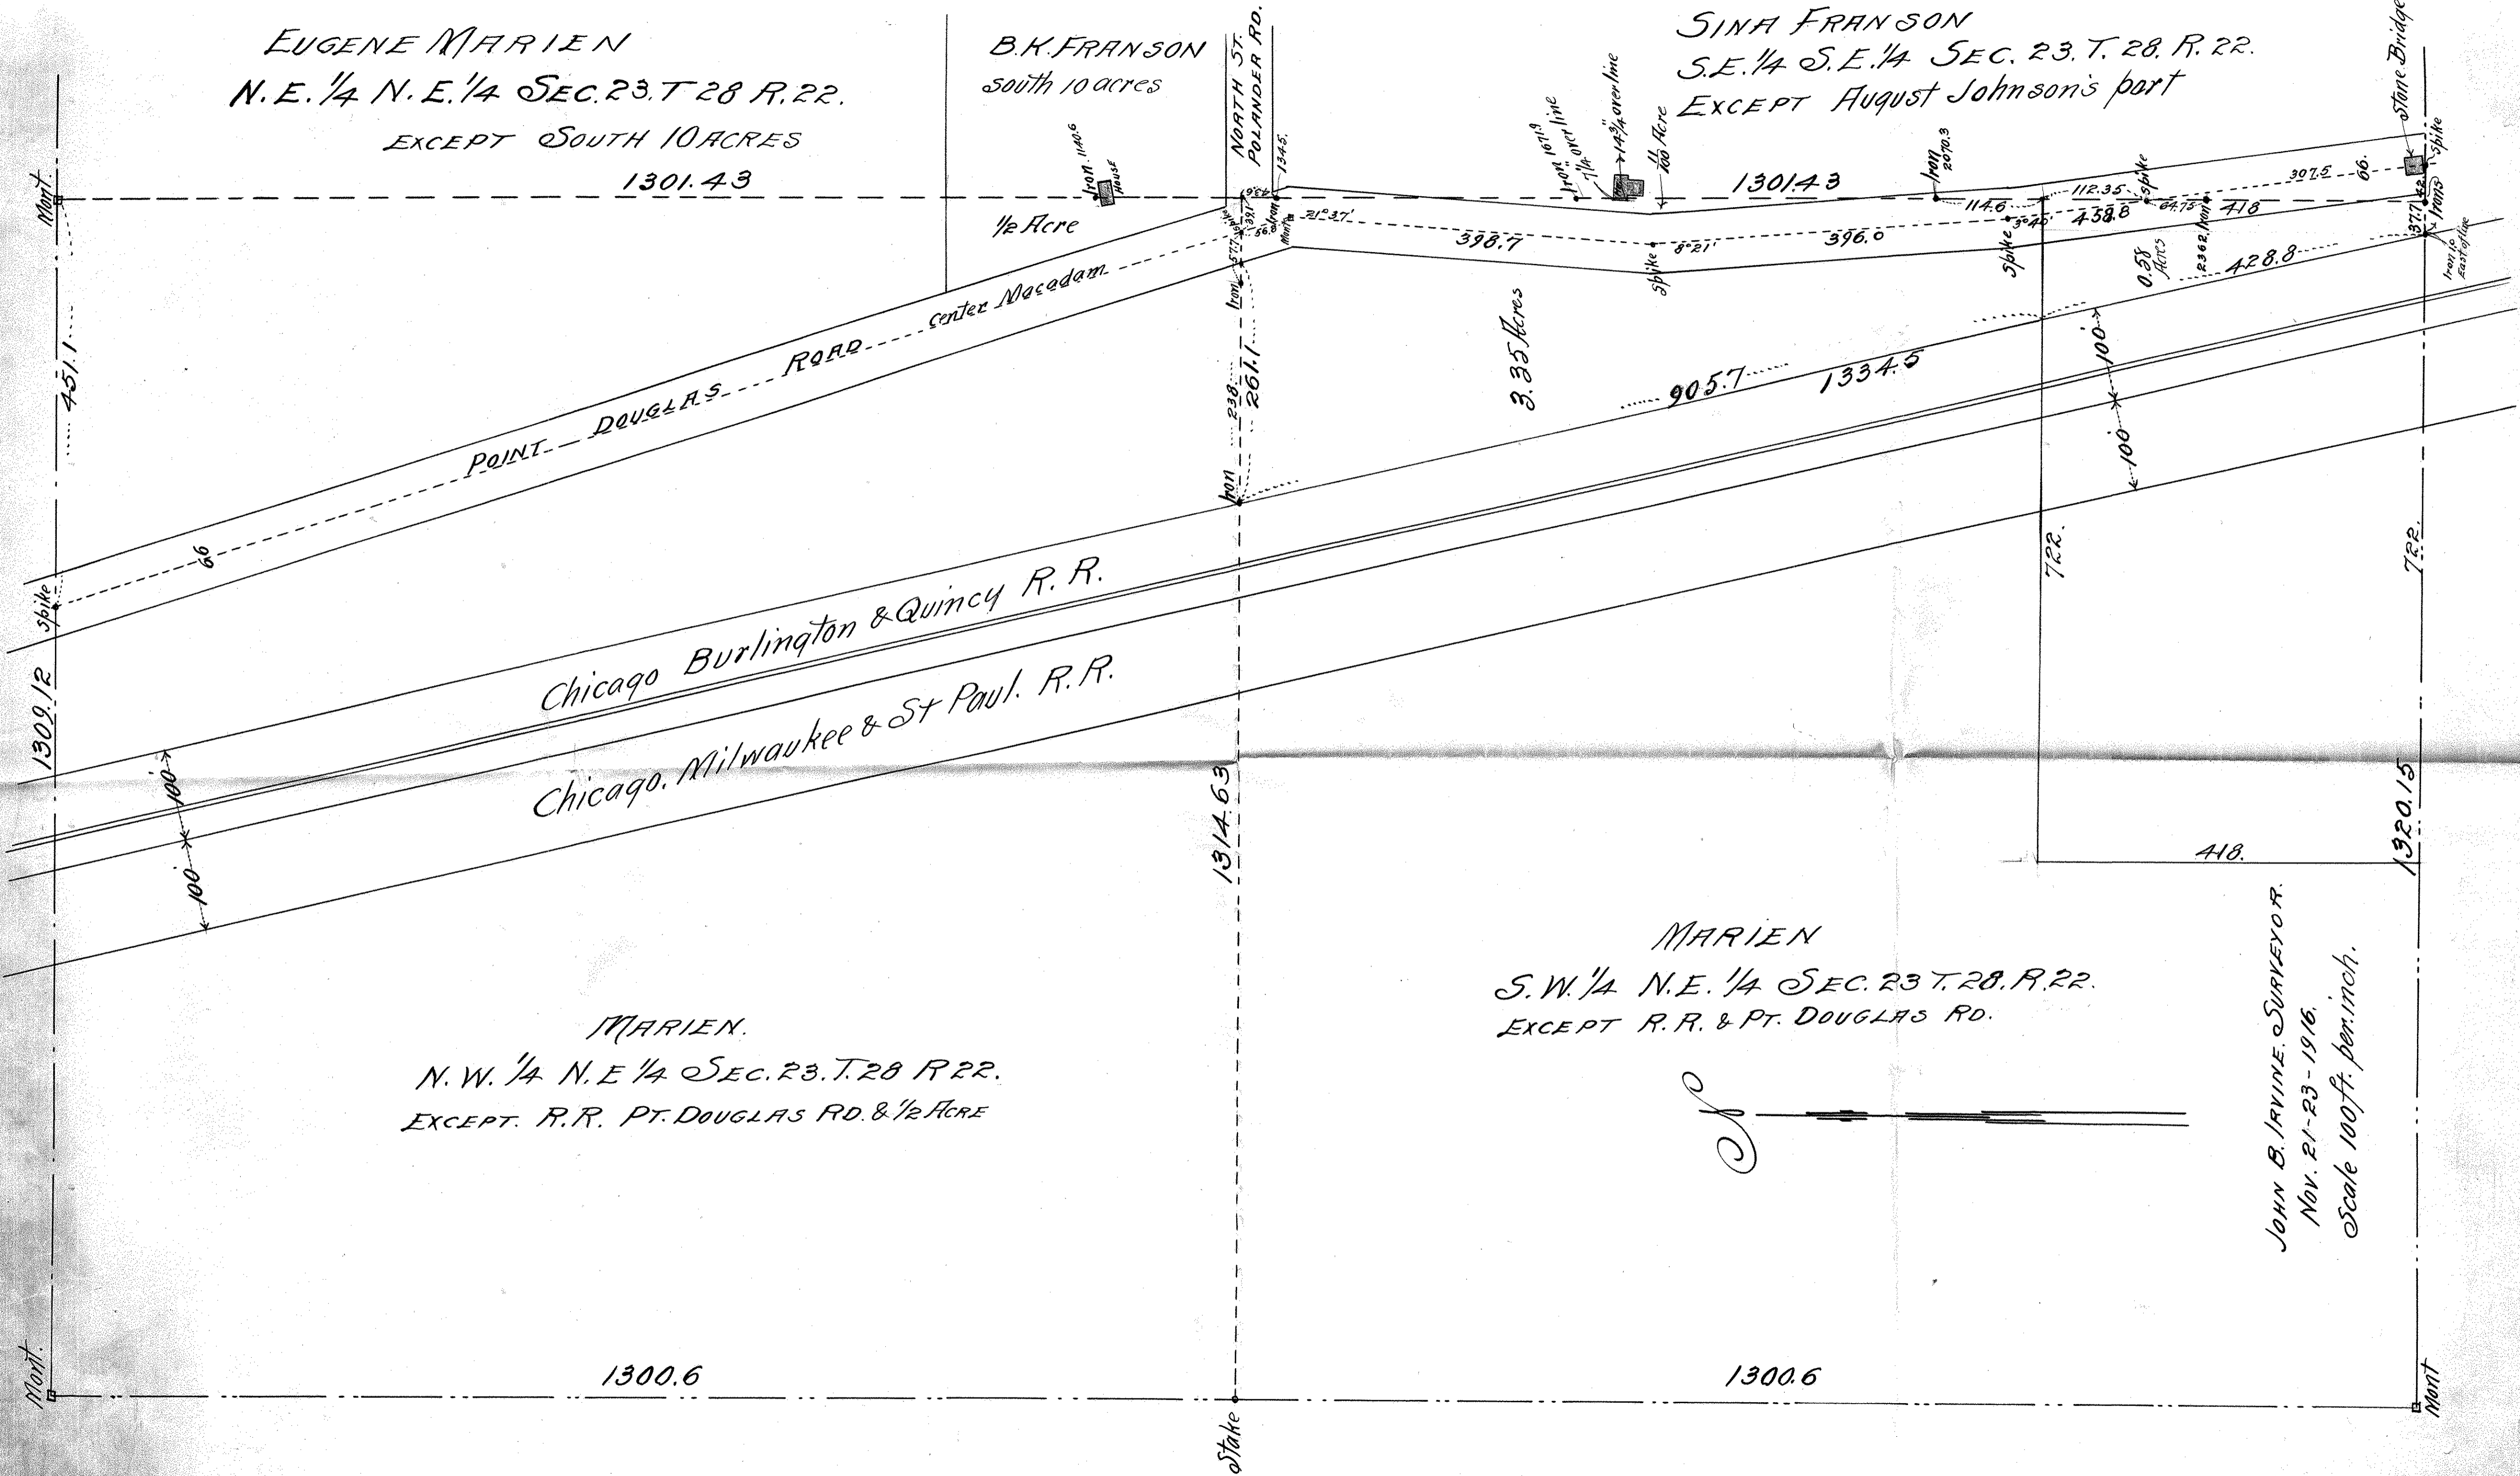

MARIEN
 S.W. 1/4 N.E. 1/4 SEC. 23 T. 28. R. 22.
 EXCEPT R.R. & PT. DOUGLAS RD.

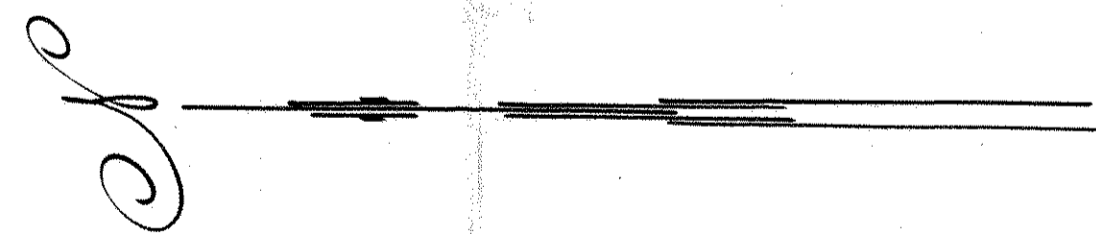

JOHN B. IRVINE, SURVEYOR
 Nov. 21-23 - 1916.
 Scale 100 ft. per inch.