

NORTH 1/2 S. 1/4 SECTION 11.


TOWN 29 RANGE 22.

JOHN B. IRVIN, SURVEYOR

ST. PAUL, MINN.

APRIL 7-1918.

Scale 200 ft. per inch.

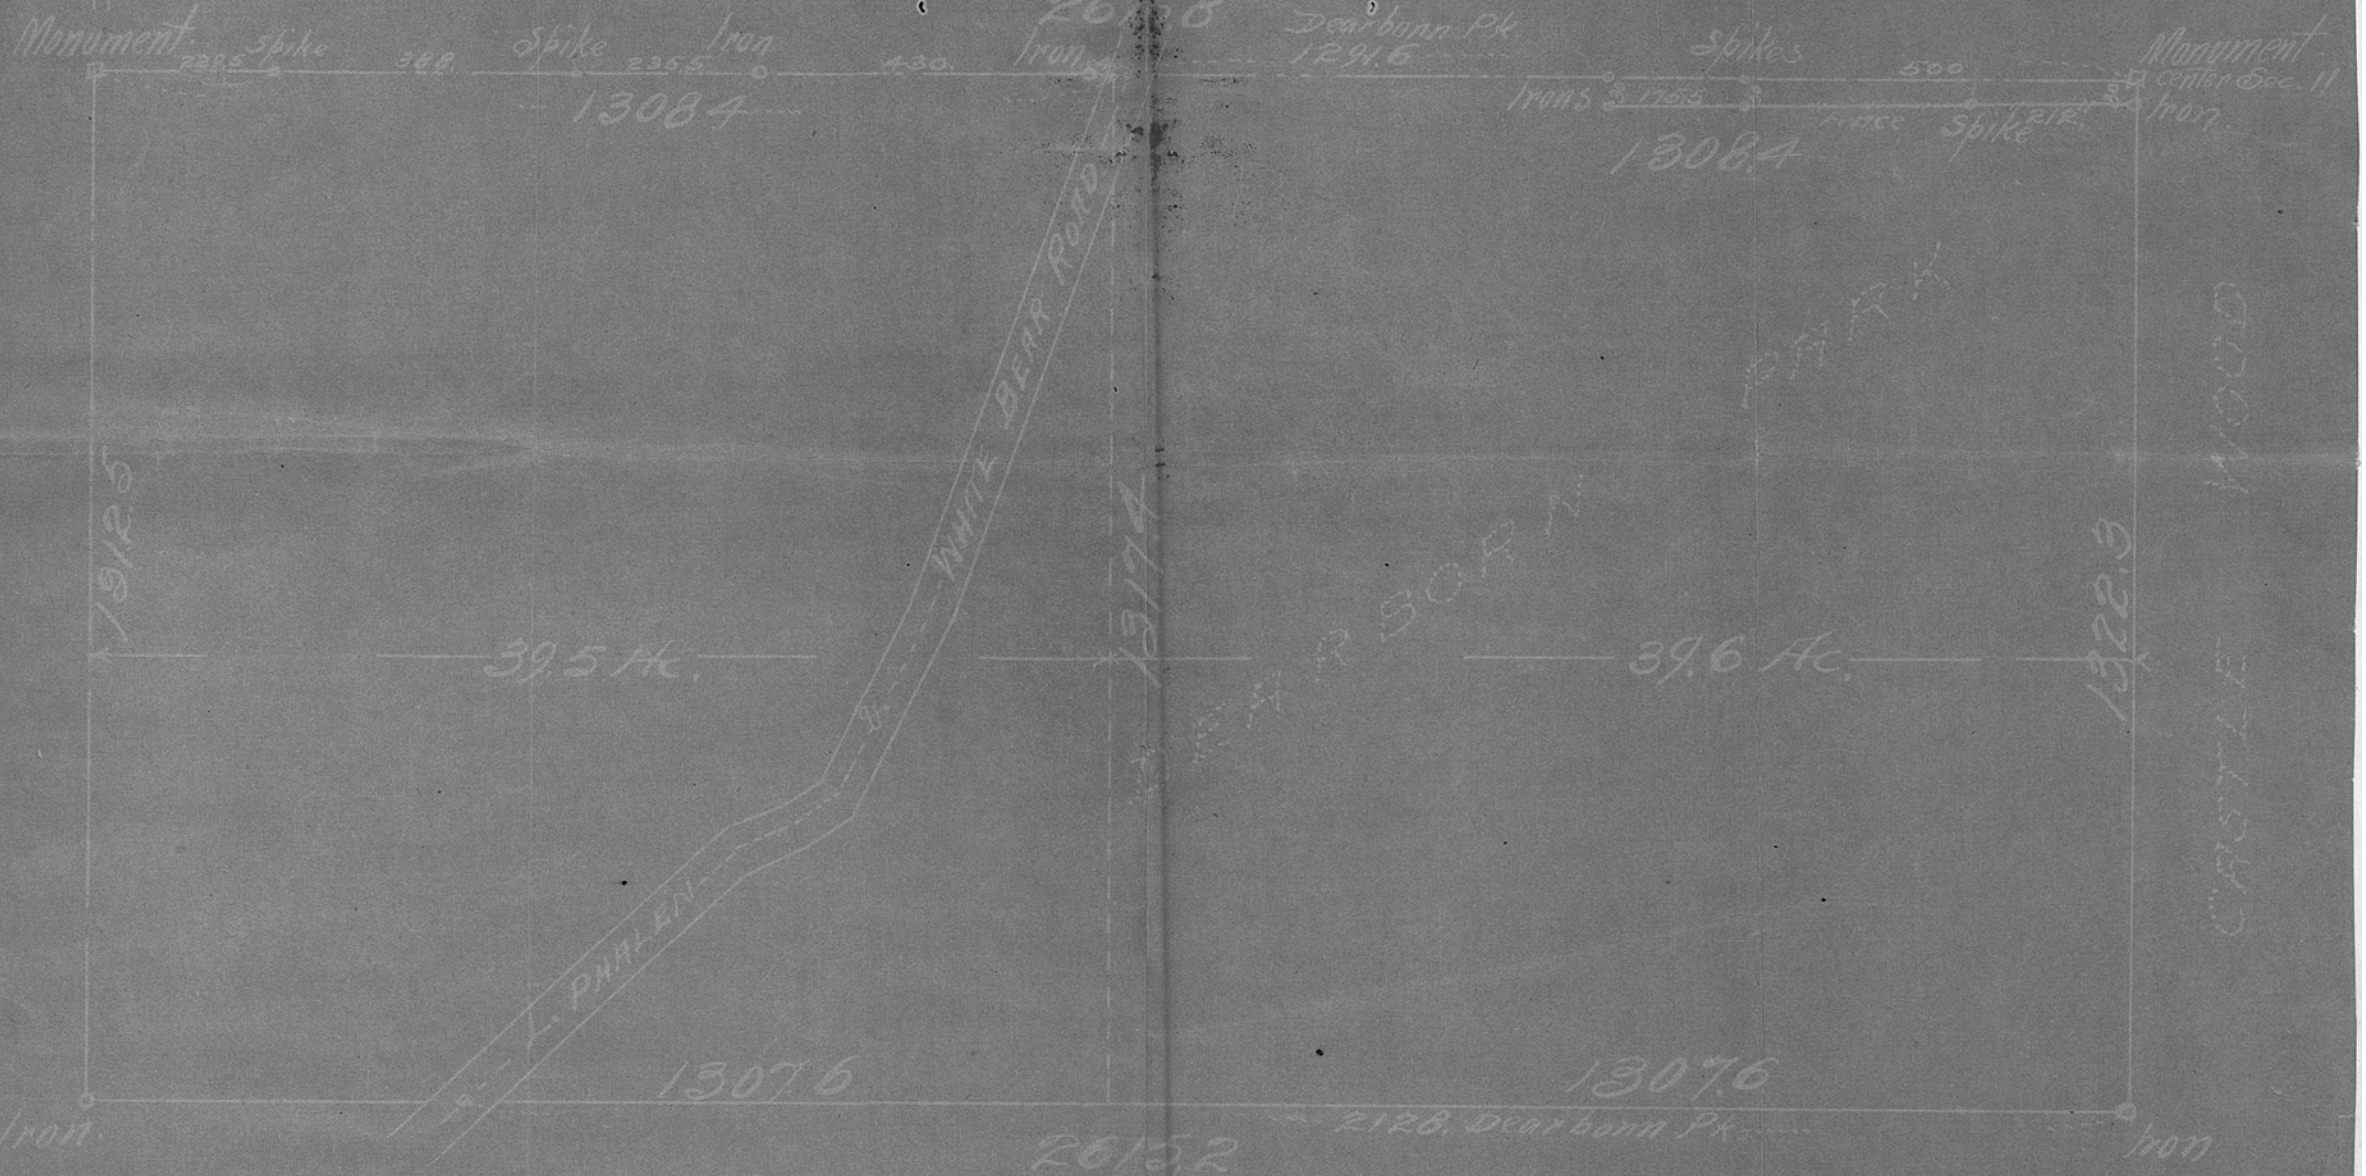

Monument

Spike


Spike

2355

Iron

430

2658 Iron

Dearborn Pk 1291.6

Spikes

500

Monument center Sec. 11 1107

13084

Trans

1765

500

Spike

212

13084

1912.5

39.5 Ac.

13174

39.6 Ac.

1322.9

L. PHALEN

WHITE BEAR ROAD


CASTLE WOOD

Iron

13076

2615.2

13076

2128, Dearborn Pk

Iron