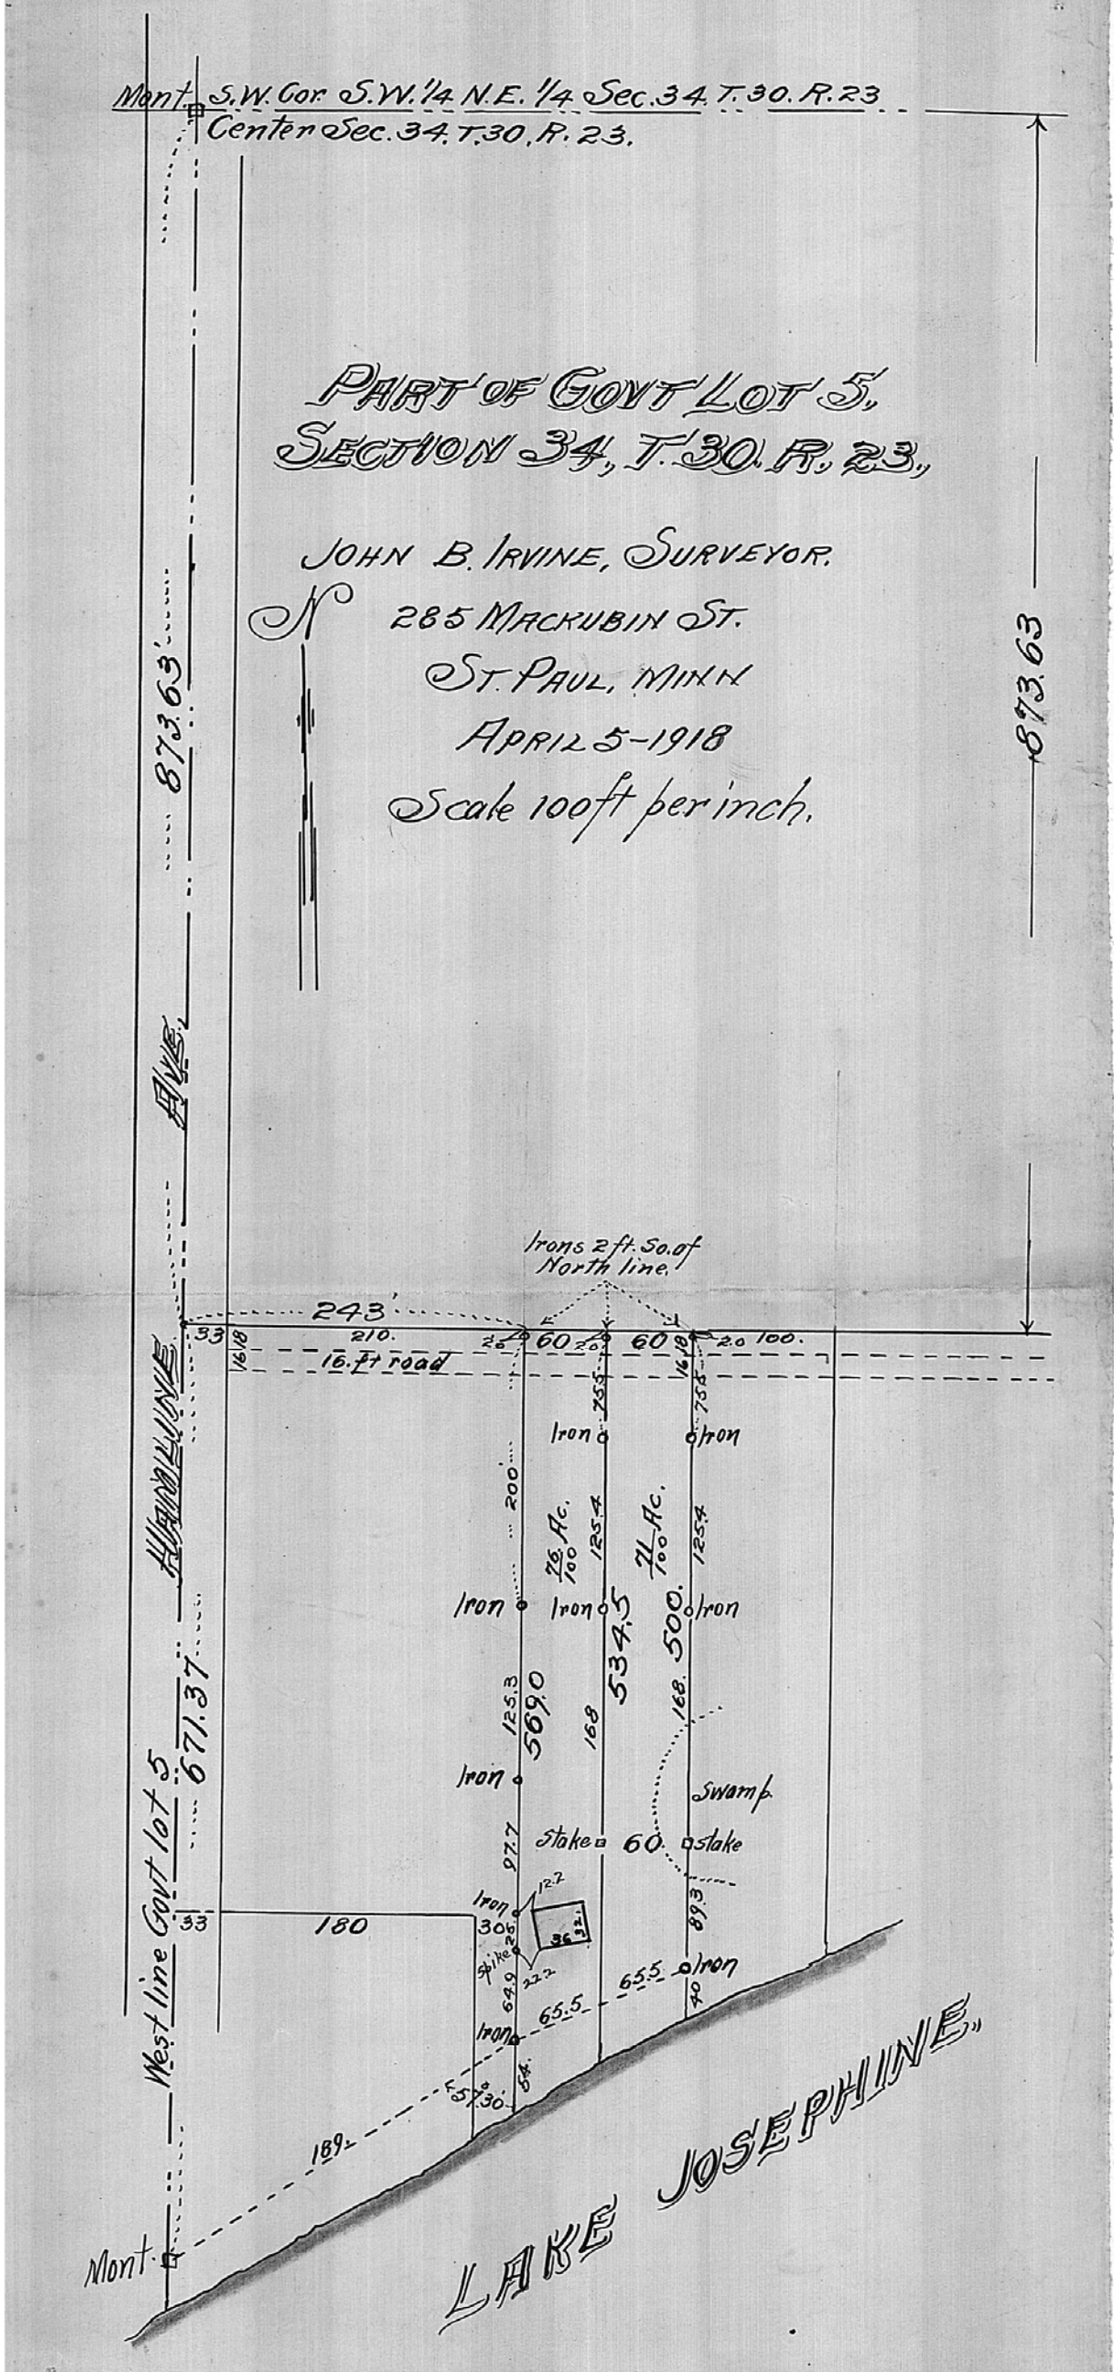
Mont. S.W. Cor. S.W. 1/4 N.E. 1/4 Sec. 34 T. 30. R. 23.
Center Sec. 34. T. 30. R. 23.
PART OF GOVT LOT 5,
SECTION 34, T. 30. R. 23,
JOHN B. IRVINE, SURVEYOR.
265 MACKUBIN ST.
ST. PAUL, MINN.
APRIL 5-1918
Scale 100 ft per inch.
N
873.63'
873.63
HAMLINE AVE.
West line Govt lot 5
671.37'
Irons 2 ft. So. of North line.
243'
33
210.
26
60
20
60
16.5
20
100.
16.5 ft road
Iron
Iron
Iron
200'
100
125.4
Iron
Iron
534.5
500.
Iron
125.3
569.0
168
168.
Iron
Swamp
97.7
Stake
60
Stake
Iron
127
89.3
33
180
30
Spike
26
36
32
64.9
222
65.5
65.5
Iron
40
Iron
54.
S 57° E
30.
189.
Mont.
LAKE JOSEPHINE