

Monument
1/4 Cor.
W. side Sec. 36.

E. & W. 1/4 line

Scale. 100 ft. per inch.

528'

N 62° E.

257 1/2° E

County Center line
A 29 Meander line

Shore line Lake
Owasso Dec. 1918

South line
25 3/4° E 462'

County center line
Chapman South line

70° 38'
70° 10'

Monument
Cent. Sec. 36

East line Govt. lot 2

LAKE OWASSO.

LAKE OWASSO BOULEVARD,
GOVT. LOT 2 SECTION 36 T. 30 R. 23.

JOHN B. IRVINE, SURVEYOR.
ST. PAUL, MINN.
DEC. 1918.

Scale. 50 ft. per inch.

West line Govt. lot 2

North side of road as graded
County Center line
South side of road as graded
Chapman South line
Established Level line of Lake Owasso

Present Shore line Lake Owasso

North side of road as graded

County Center line
Chapman South line

South side of road as graded

Hill

North side of road as graded
County Center line
Chapman South line

70° 38'
70° 10'

Monument
Cent. Sec. 36
T. 30 R. 23.

East line Govt. lot 2

West line Sec. 36
1799.5

N 22 1/2° E 2310'

N 22 1/2° E 1519'

Meander Corner No. 2
Monument.

M.V. Book
P. 106

LAKE OWASSO BOULEVARD,
 PROPOSED CHANGE OF ROAD IN
 GOVT LOT 2, SECTION 36, T. 30, R. 23.

JOHN B. IRVINE, SURVEYOR
 ST. PAUL, MINN.
 OCT. 24, 1918.
 Scale 100 ft. per inch.


180.65
 54.91
 149.79

 384.85
 62.50

 322.05


101.97
 97.1

 4.87

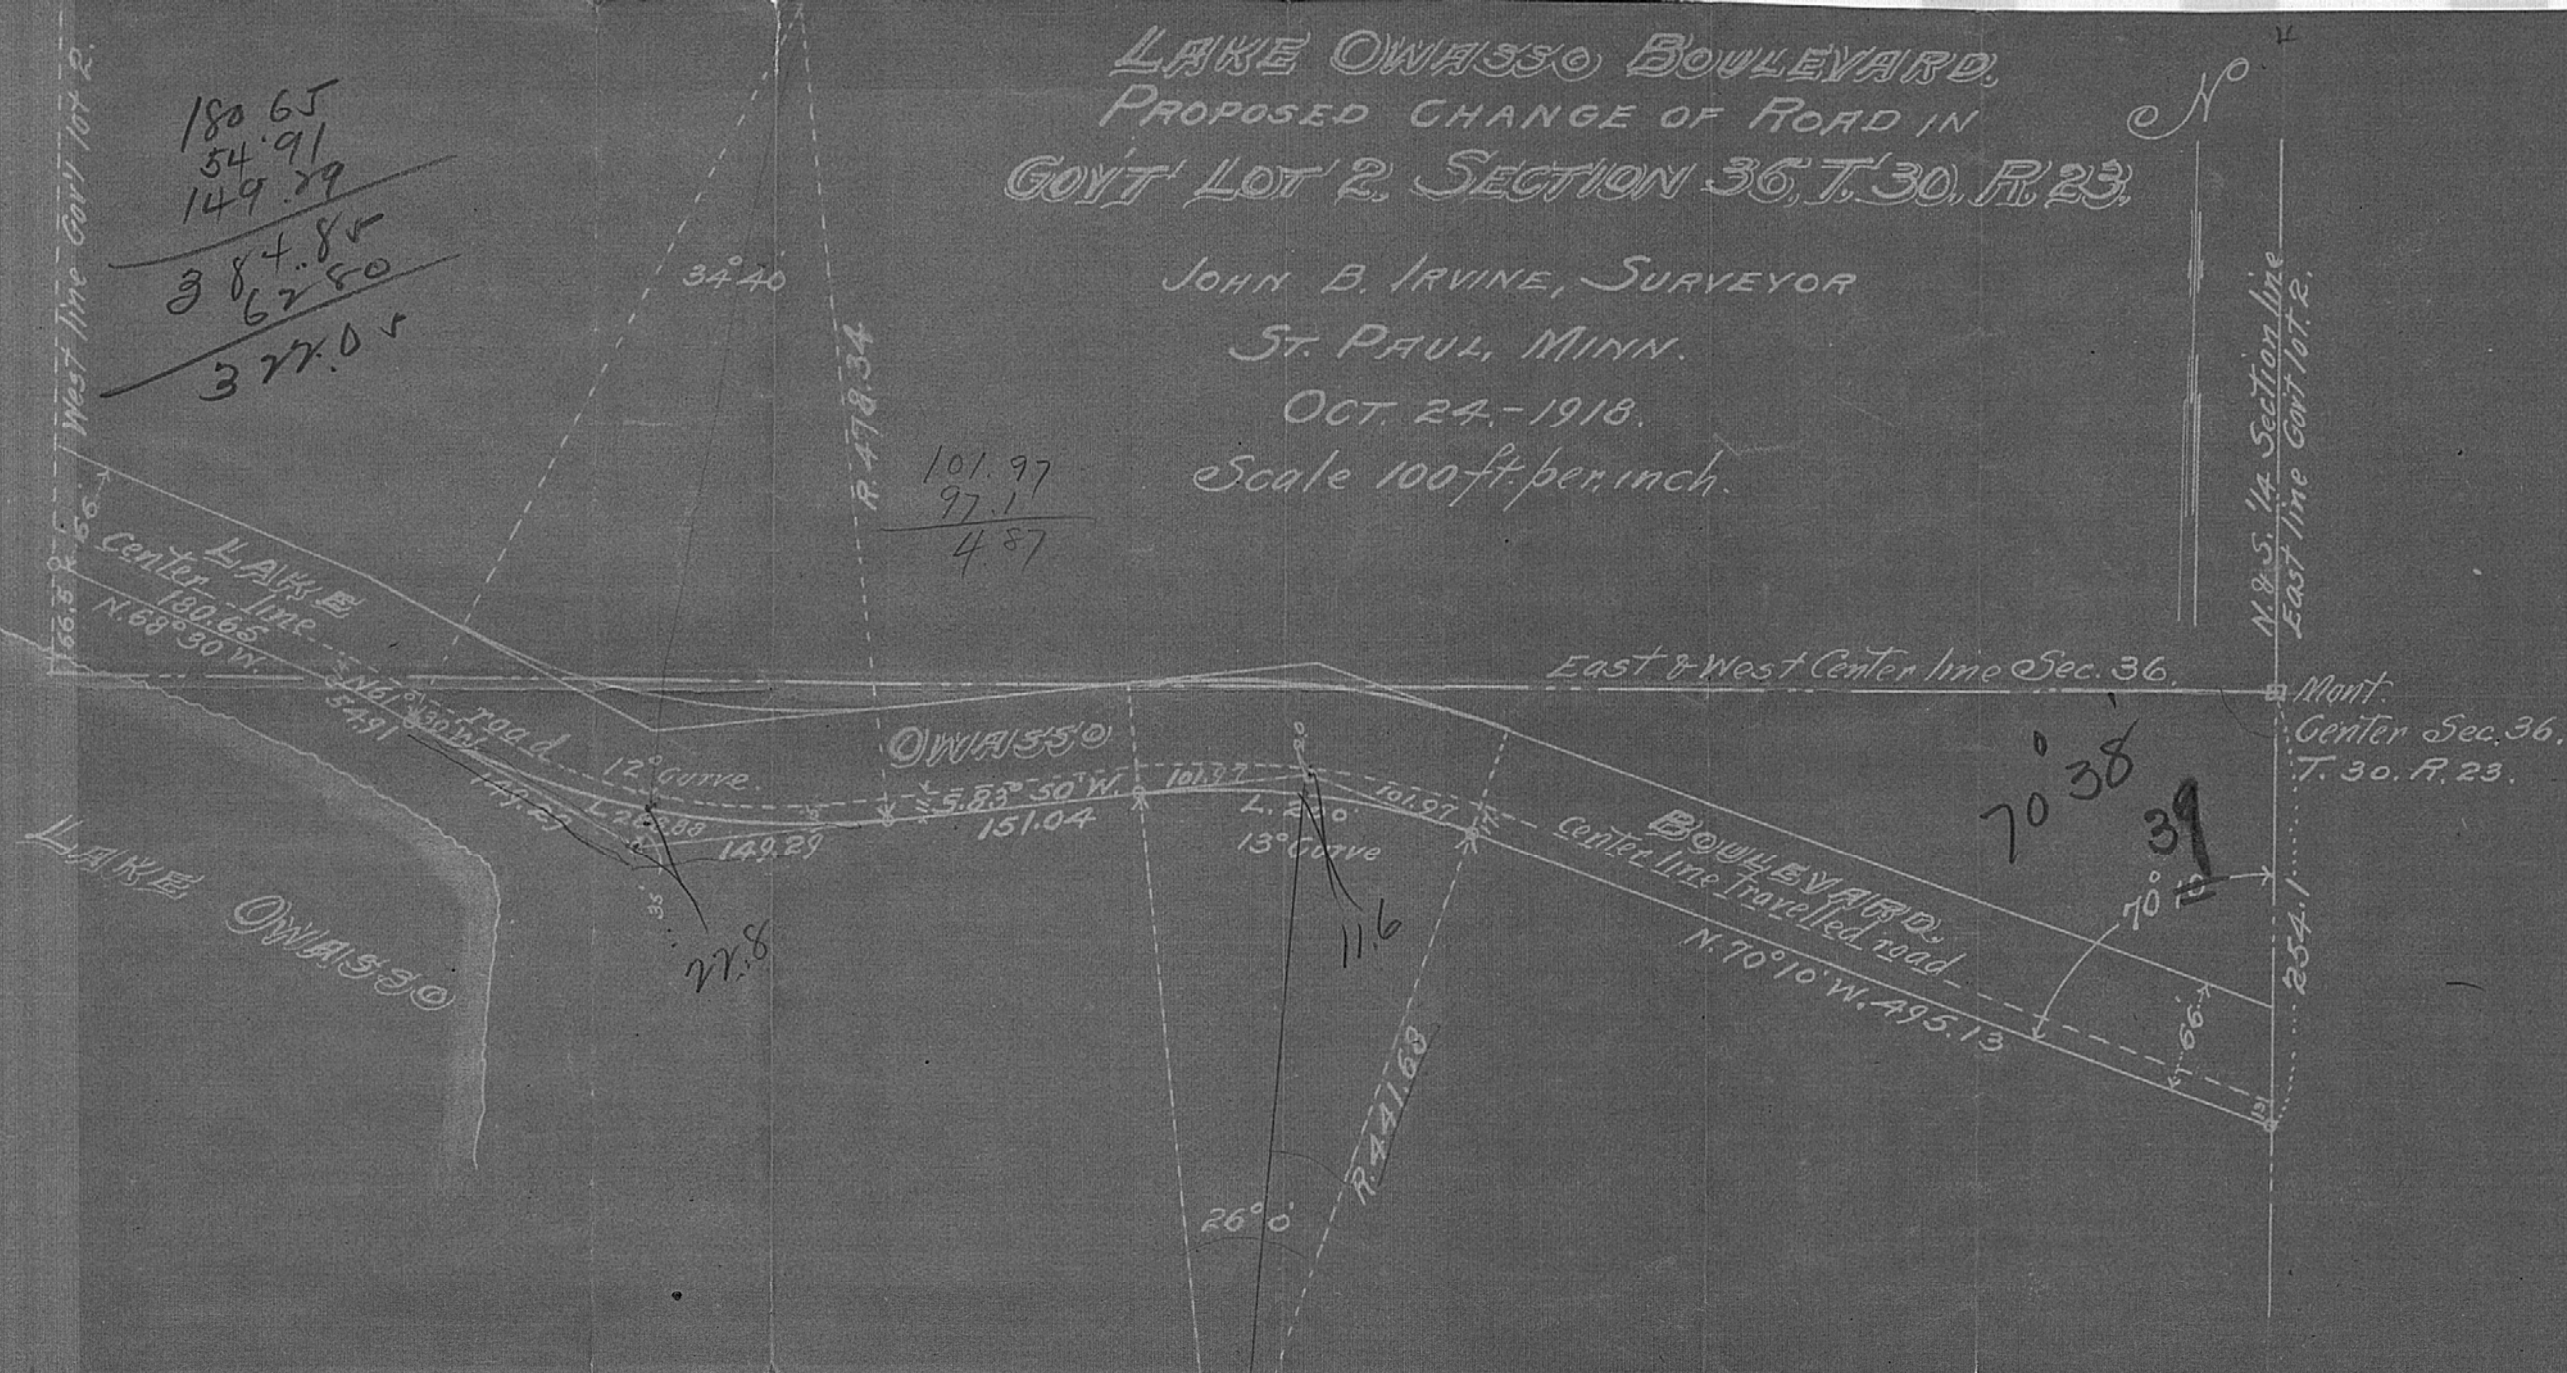


LAKE OWASSO BOULEVARD,
 DEED OF HARRY CHAPMAN & WIFE TO RAMSEY COUNTY
 GOV'T LOT 2, SECTION 36, T. 30 R. 23.


JOHN B. IRVINE, SURVEYOR.
 ST. PAUL, MINN.
 OCT 24, 1918.
 Scale 100 ft. per inch.

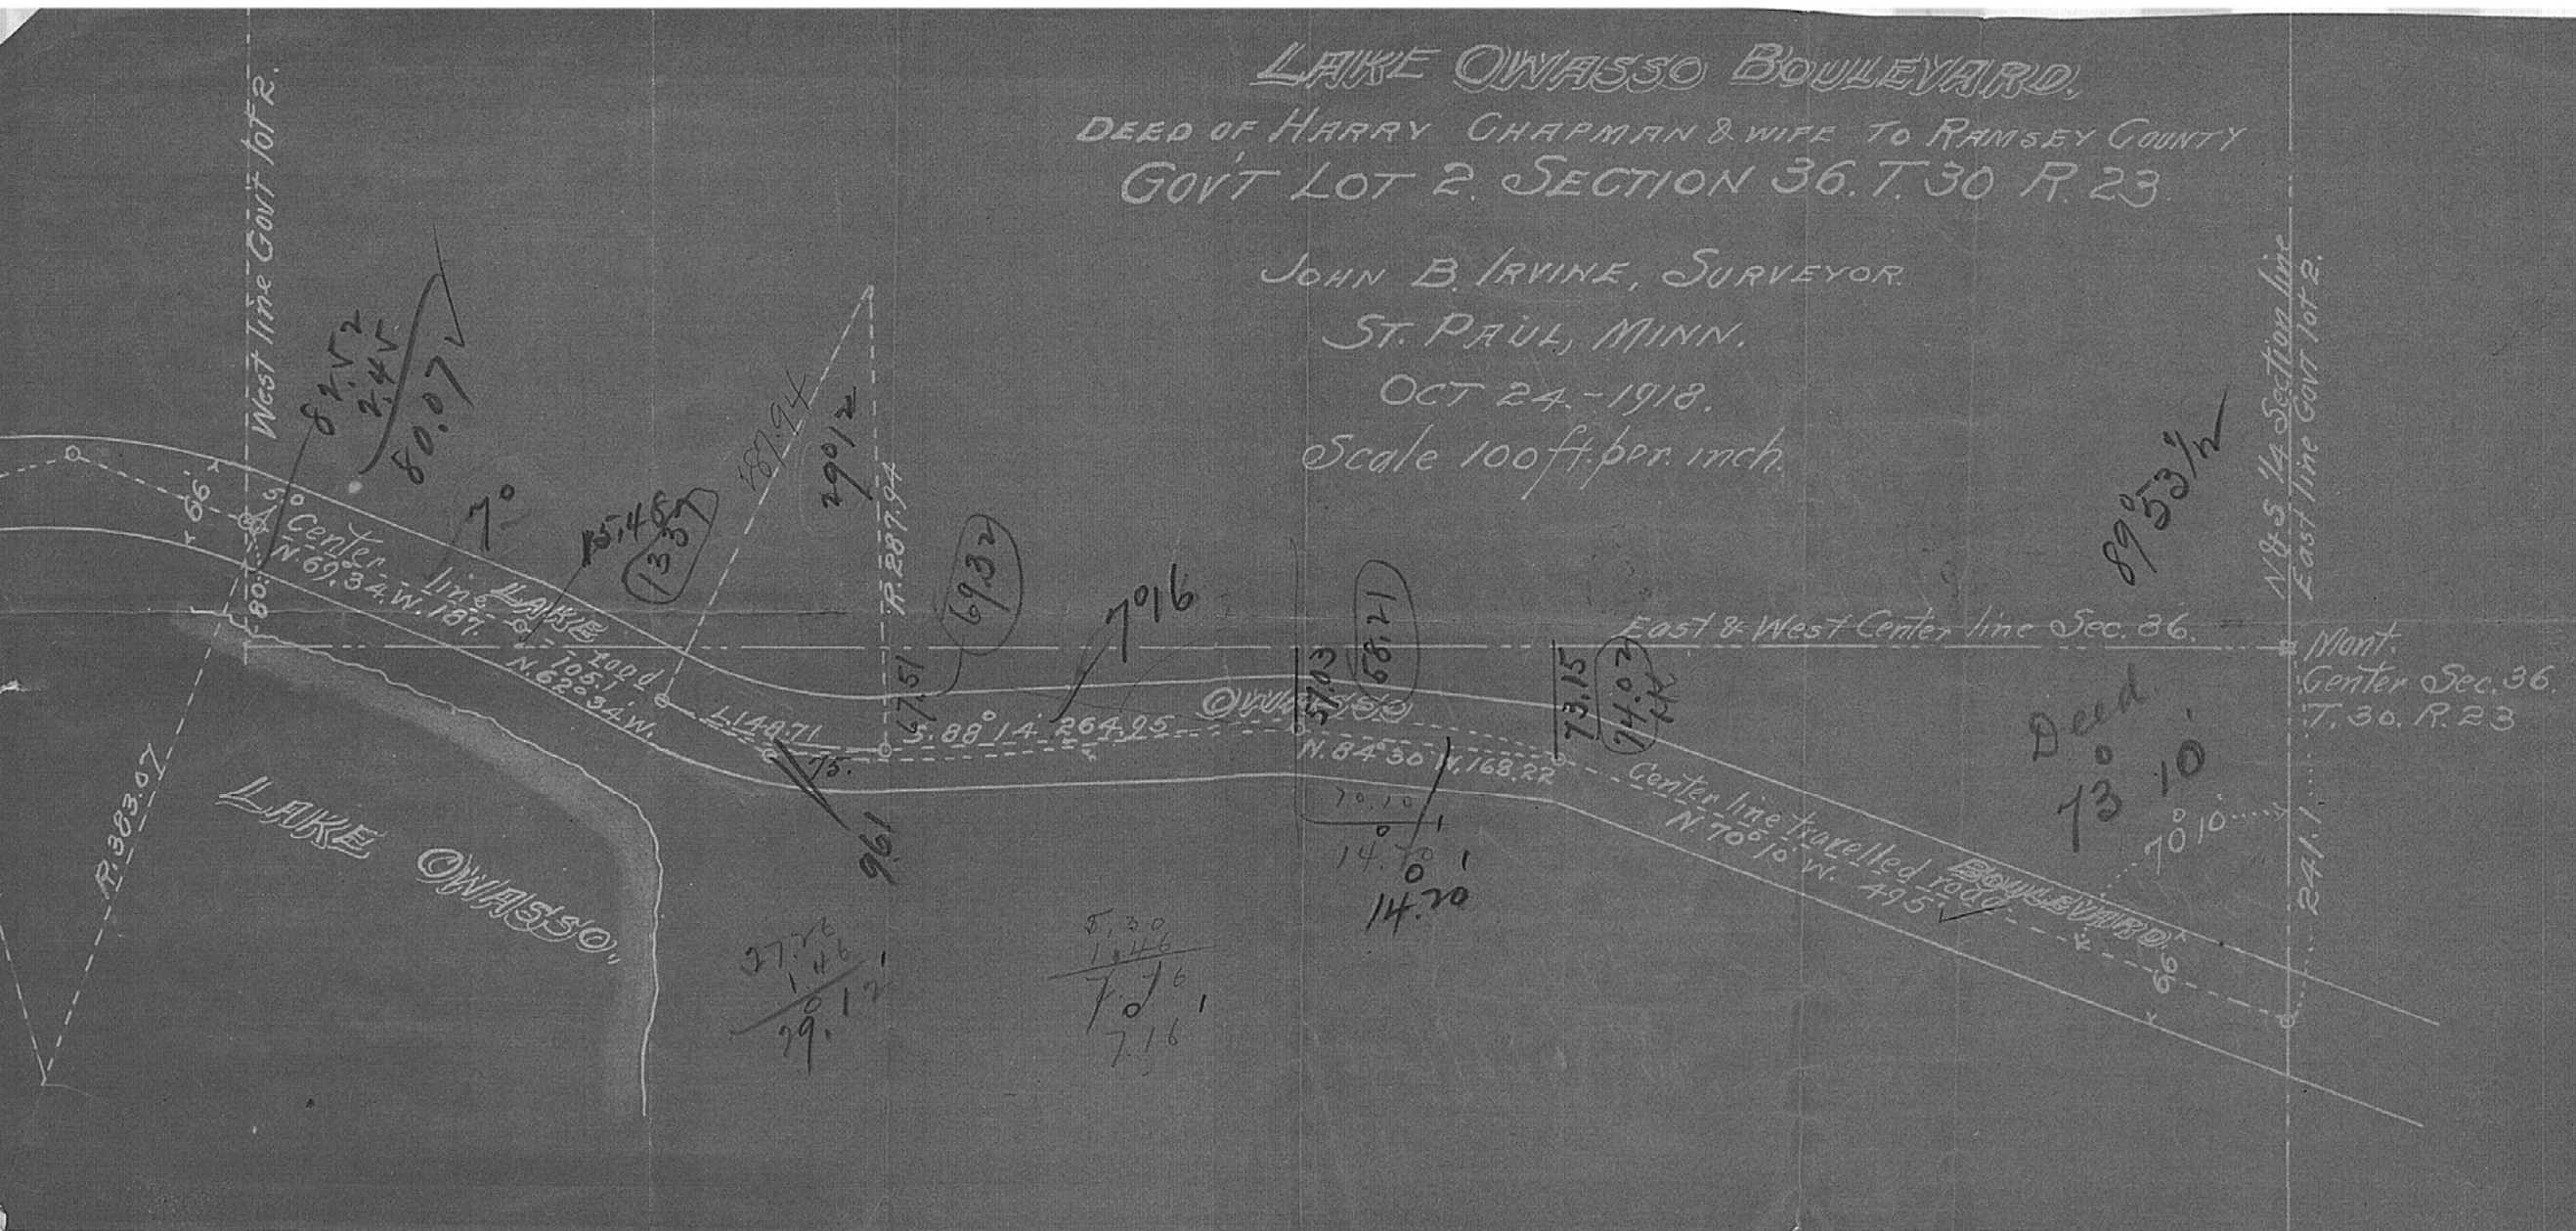

LAKE OWASSO BOULEVARD,
 PROPOSED CHANGE OF ROAD IN
 GOVT LOT 2, SECTION 36, T. 30, R. 23.

JOHN B. IRVINE, SURVEYOR
 ST. PAUL, MINN.
 OCT. 24, 1918.
 Scale 100 ft. per inch.

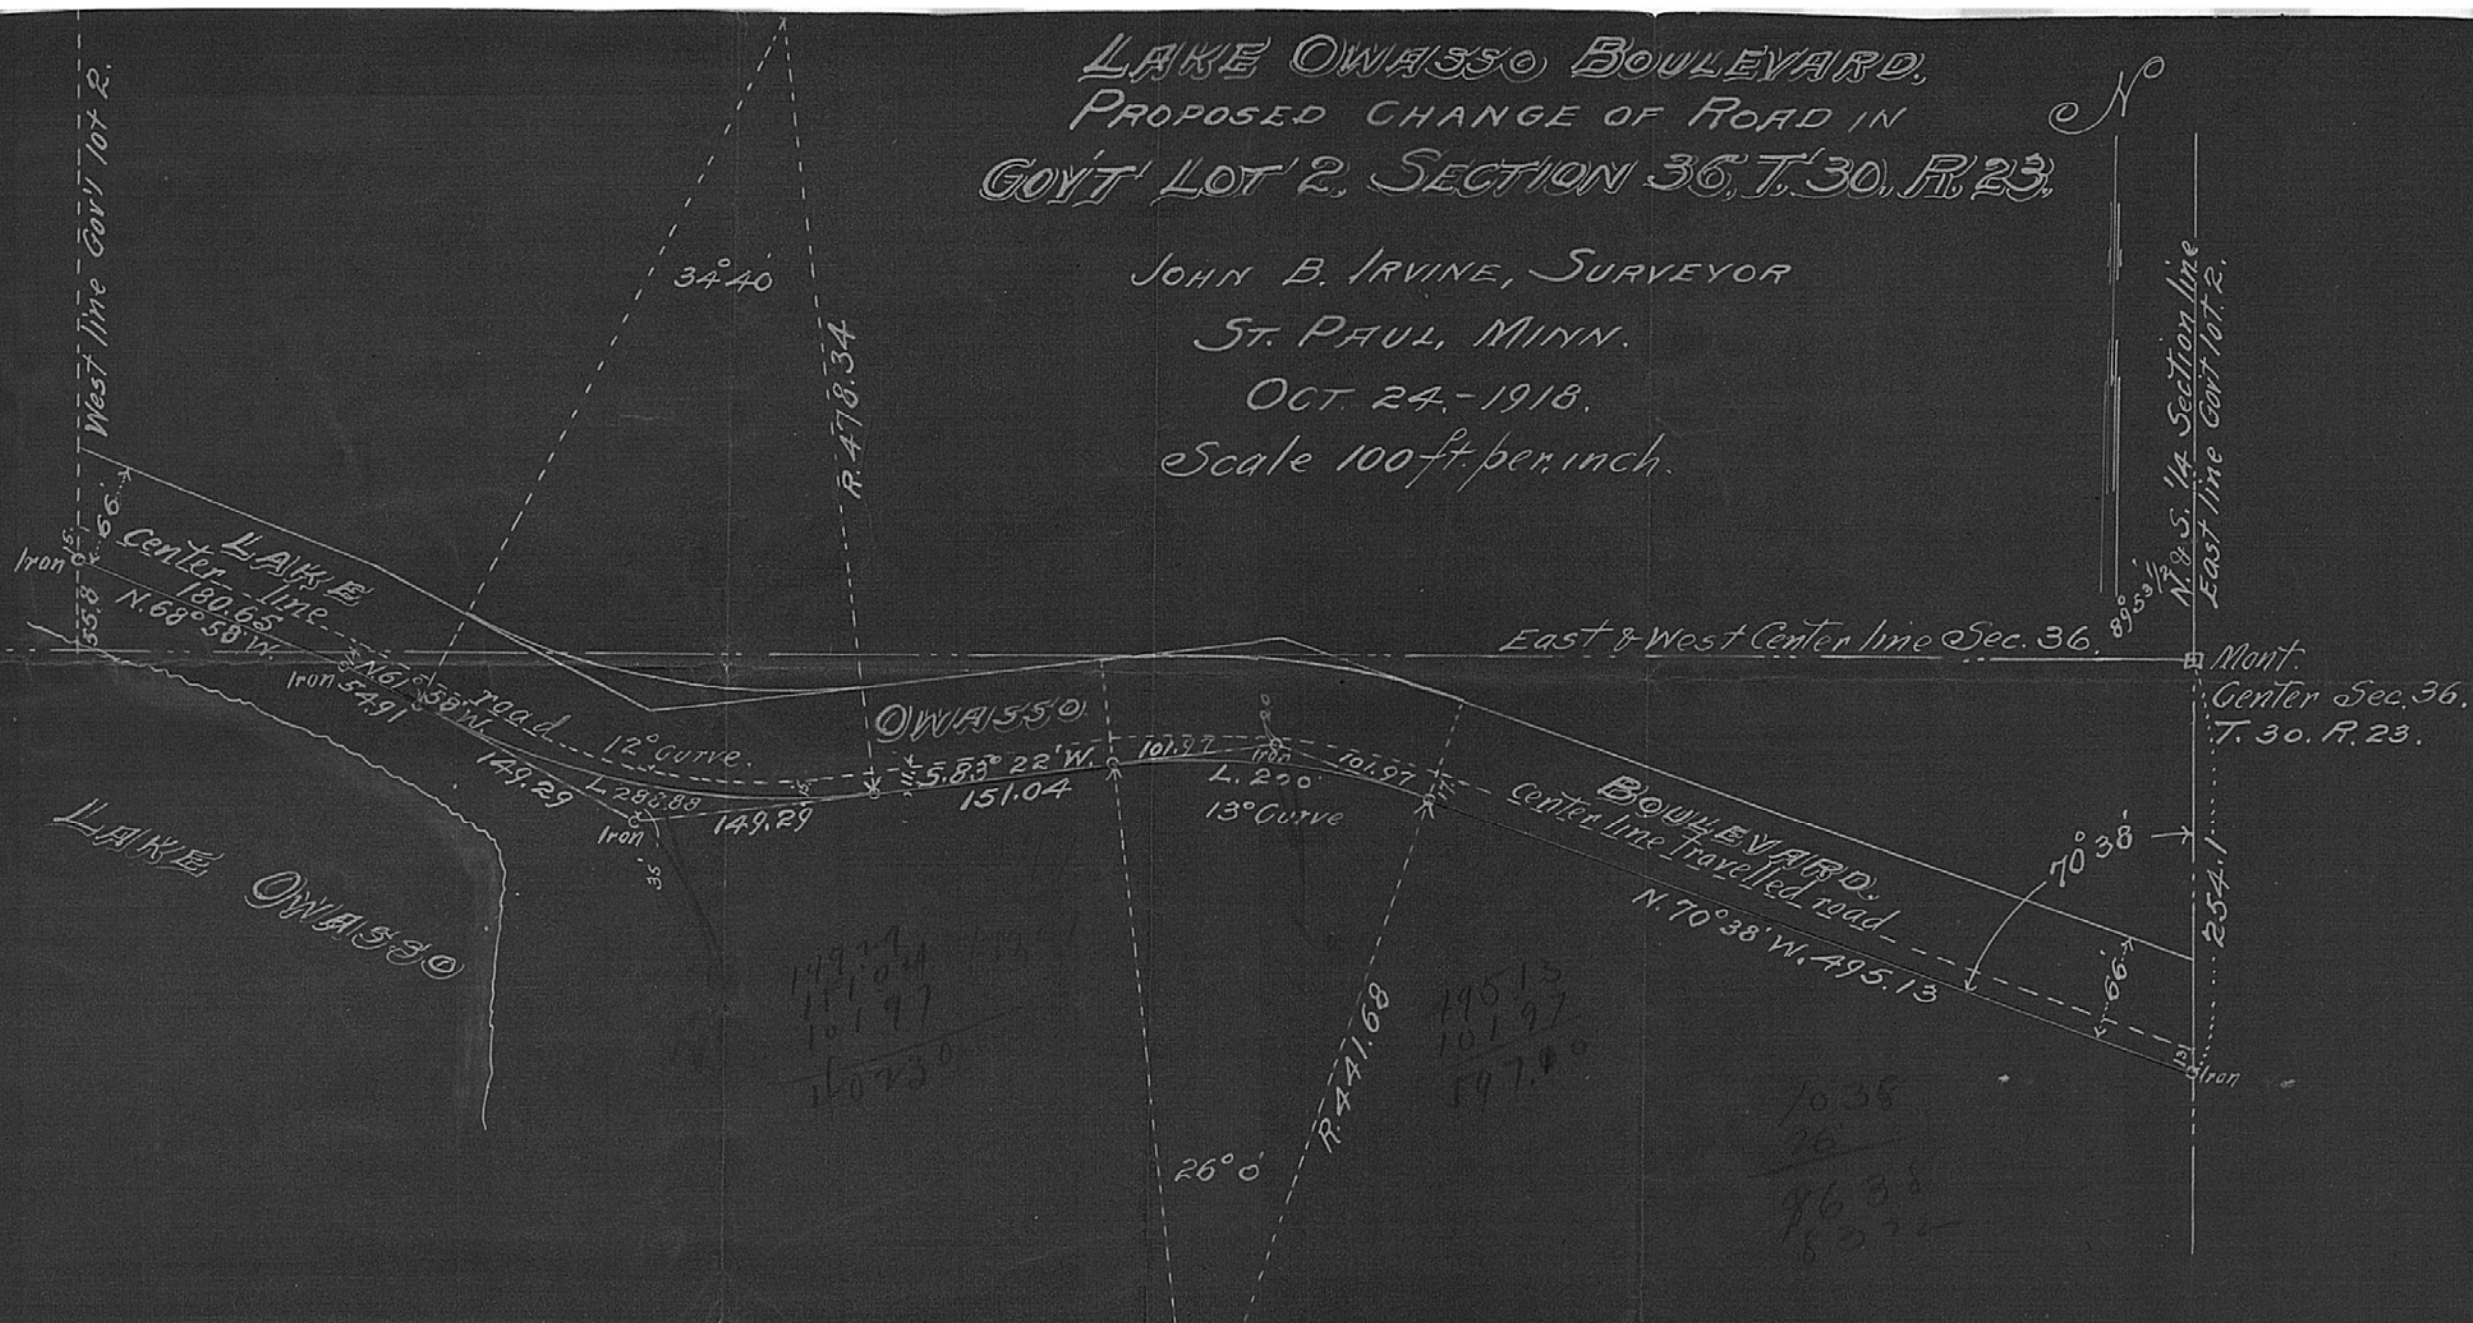

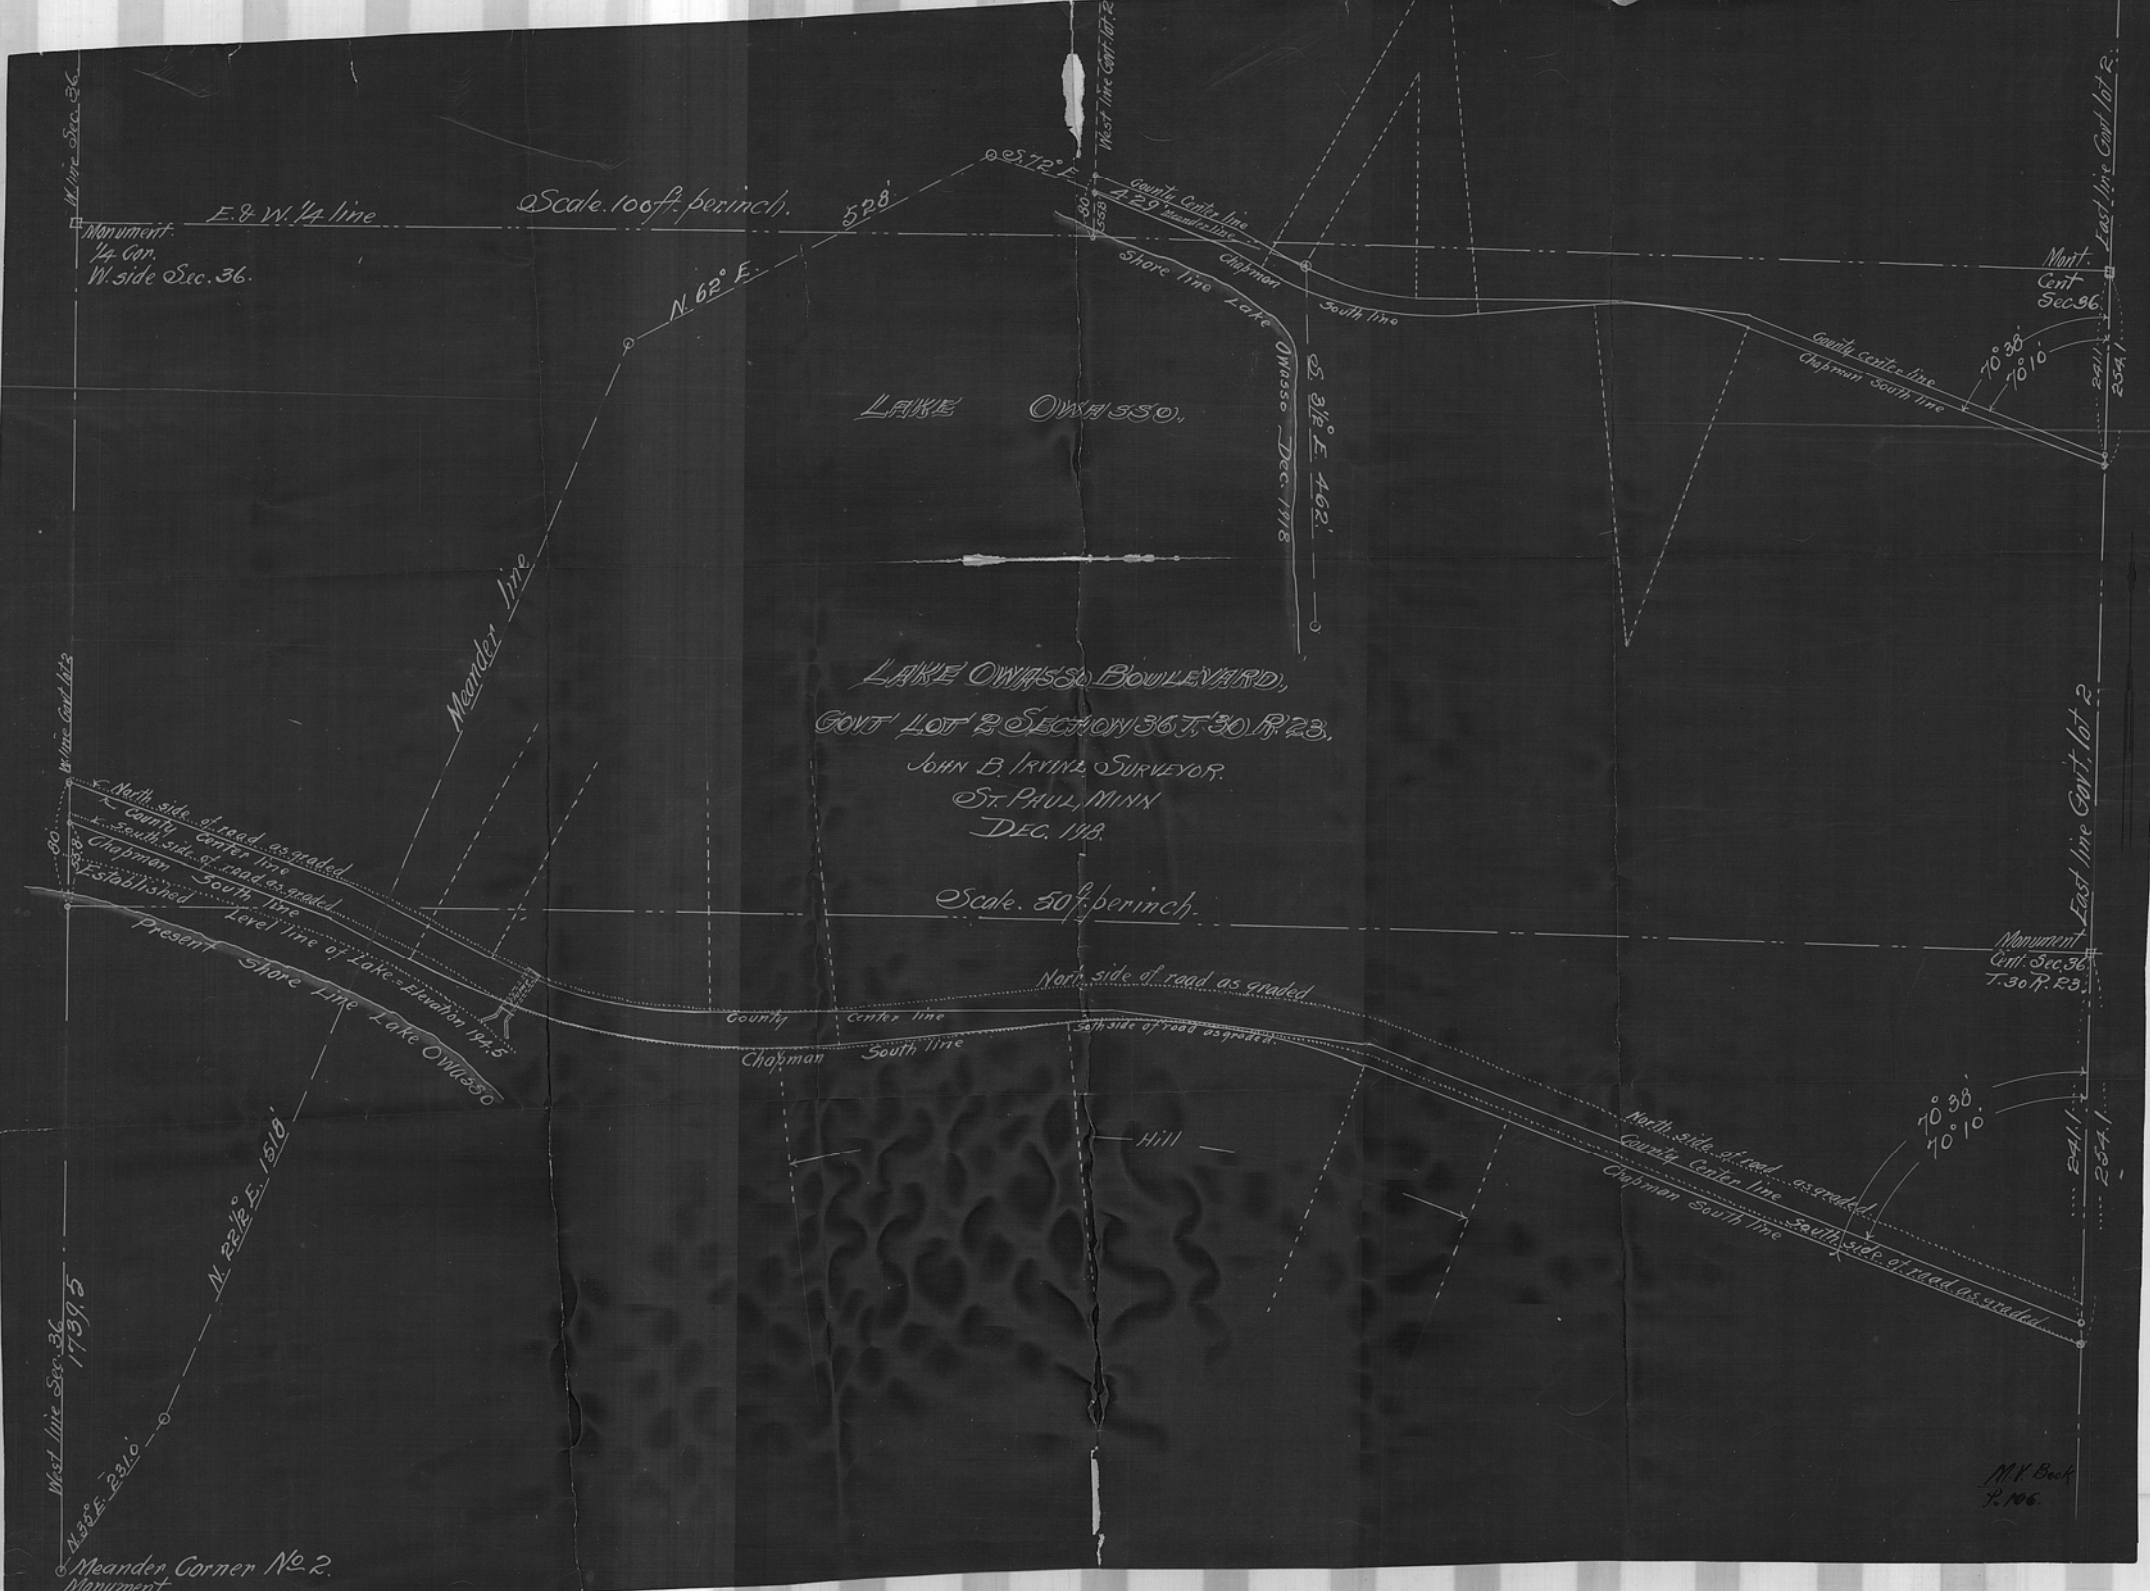

Monument
1/4 Cor.
W. side Sec. 36.

E. & W. 1/4 line

Scale. 100 ft. per inch.

528'

N. 62° E.

S. 72° E.

County Center line
429'

Shore line Lake

Chapman

South line

S. 31 1/2° E. 462'

Owasso Dec. 118

County center line

Chapman south line

70° 38'

70° 10'

Monument
Cent. Sec. 36

East line Govt. lot 2

LAKE OWASSO BOULEVARD,
GOVT LOT 2 SECTION 36 T. 30 R. 23,
JOHN B. IRVING SURVEYOR,
ST. PAUL, MINN
DEC. 118.

Scale. 50 ft. per inch.

North side of road as graded
County Center line
South side of road as graded
Chapman South line
Established Level line

Present Shore Line Lake Owasso
Level line of Lake - Elevation 194.5

North side of road as graded

County Center line

South side of road as graded

Chapman South line

Hill

North side of road as graded

County Center line

Chapman South line

70° 38'

70° 10'

Monument
Cent. Sec. 36
T. 30 R. 23

East line Govt. lot 2

West line Sec. 36
1739.5

N. 22 1/2° E. 1510'

Meander Corner No. 2
Monument.

M.V. Book
P. 106