PART OF LOT 5, SECTION 36. TOWN 30. RANGE 23.

BOOK 79 ASSIGNMENTS PAGE. 165.
REGISTER OF DEEDS.
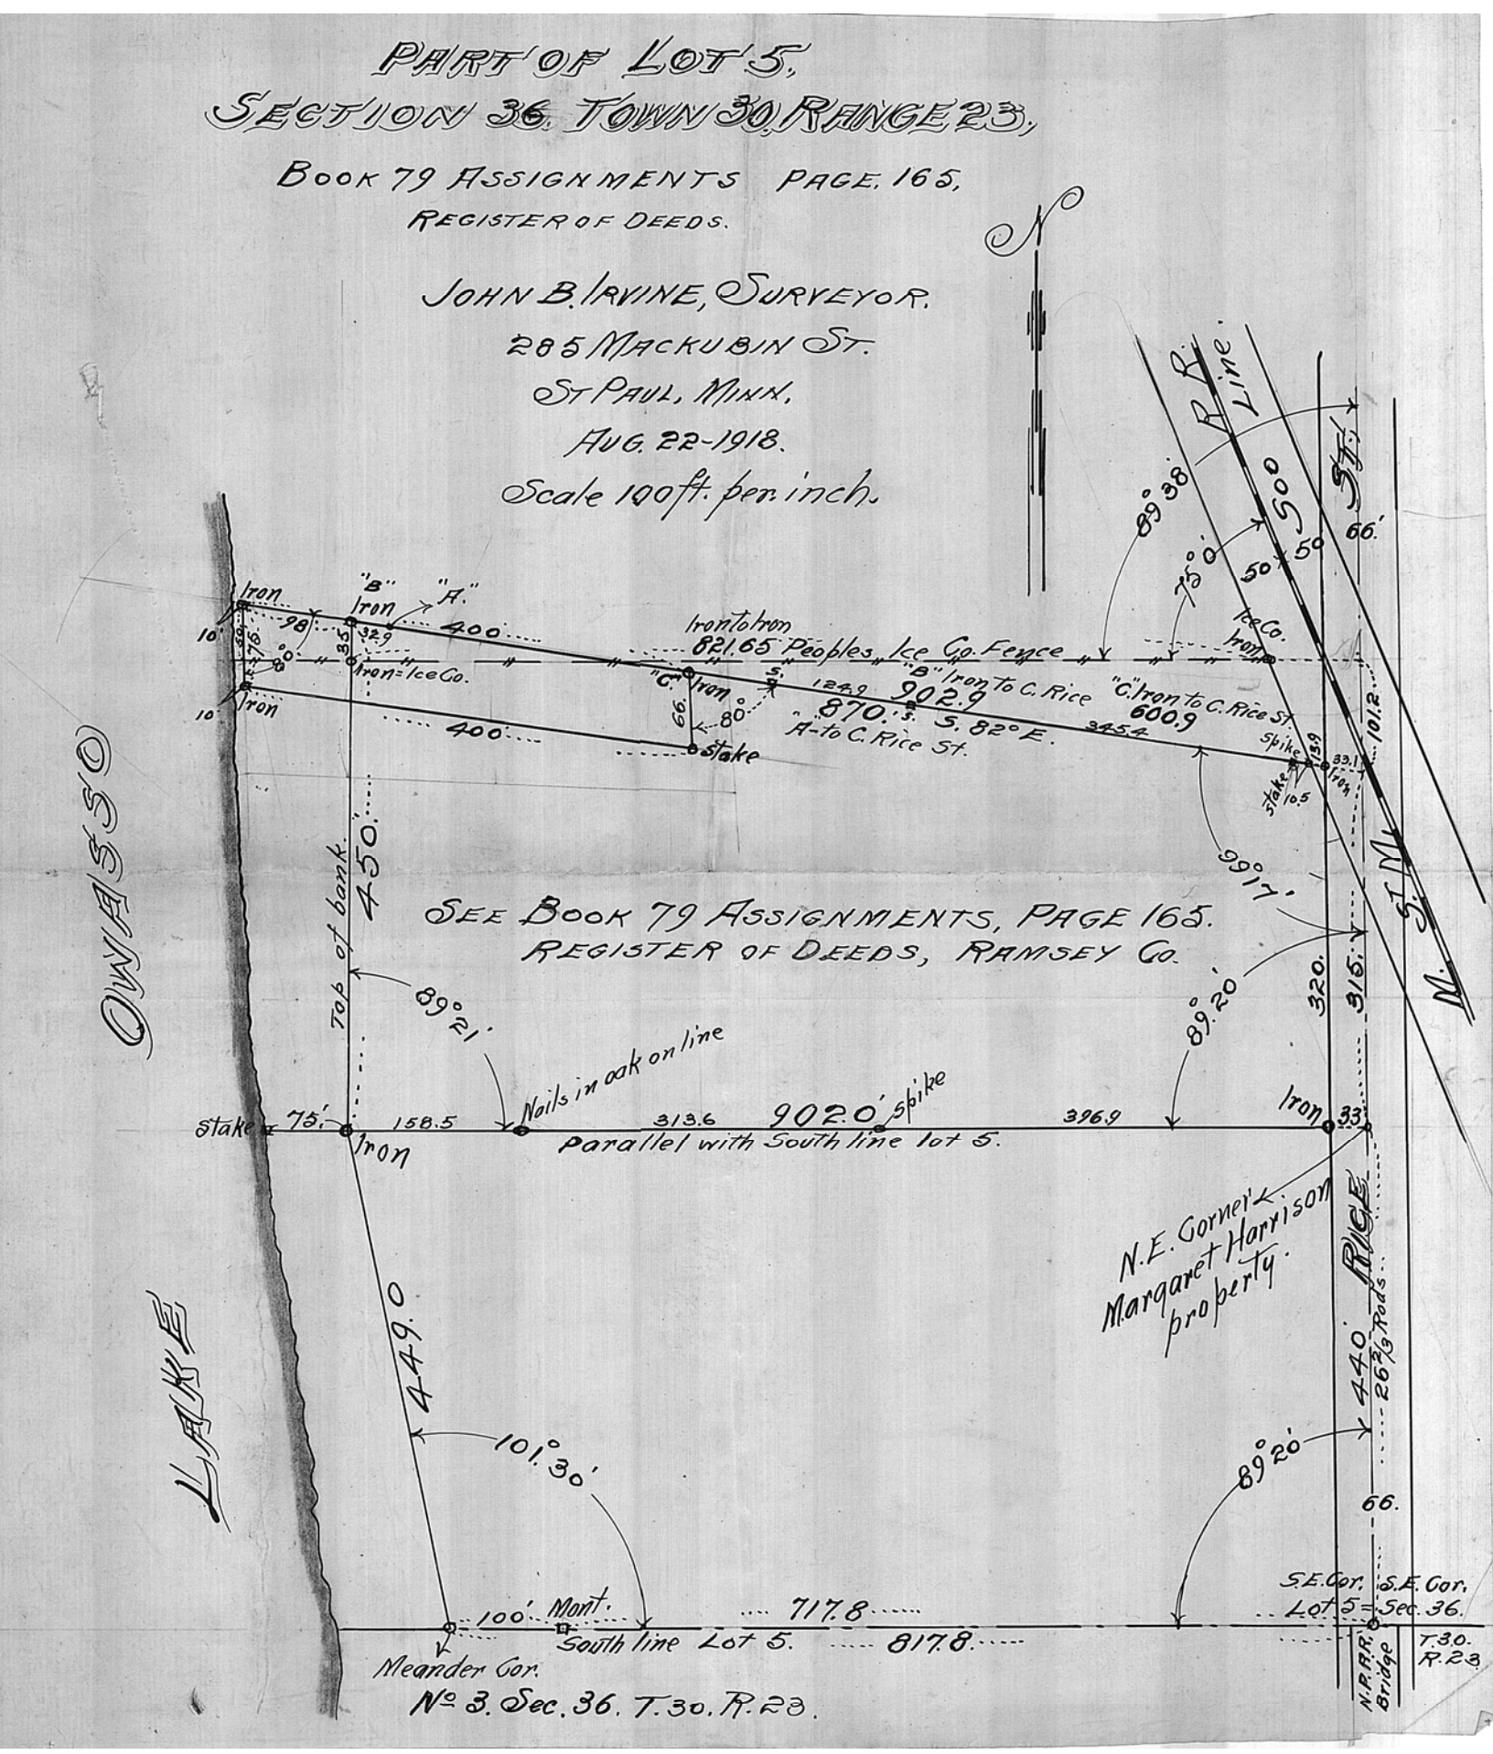
JOHN B. IRVINE, SURVEYOR.
285 MACKUBIN ST.
ST PAUL, MINN.
AUG. 22-1918.
Scale 100 ft. per inch.