1 ACRE.

THE EAST 147.22 ft. of the WEST 327.44 ft. OF THE SOUTH 295.88 ft. of the NORTH 328.88 ft of the N.W. ¼ of the N.W. ¼ OF SEC. 26. TOWN 29. RANGE 22.

John B. Irvine Surveyor.
285 Mackubin St.
St. Paul. Minn.
Oct. 11-1919.
Scale 200 ft. per inch.

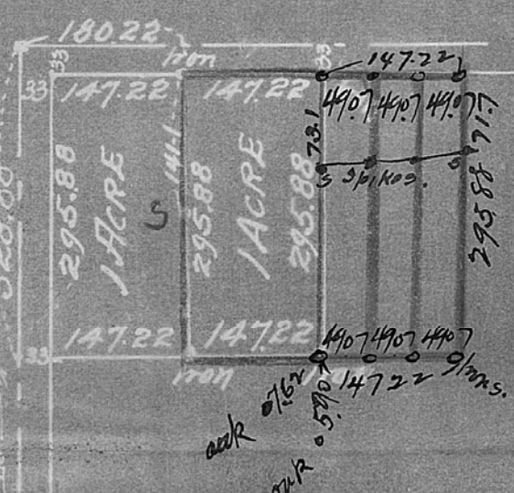

N. W. ¼, N. W. ¼.
SEC. 26. TOWN. 29. RANGE 22

1312.9 MARYLAND AVE.

WHITE BEAR 1315.53 AVE.

1314.45

1310.65