GREAT NORTHERN R.R.
RICE STREET YARDS.
JOHN MARTIN LUMBER CO.
R.R. SIDINGS.
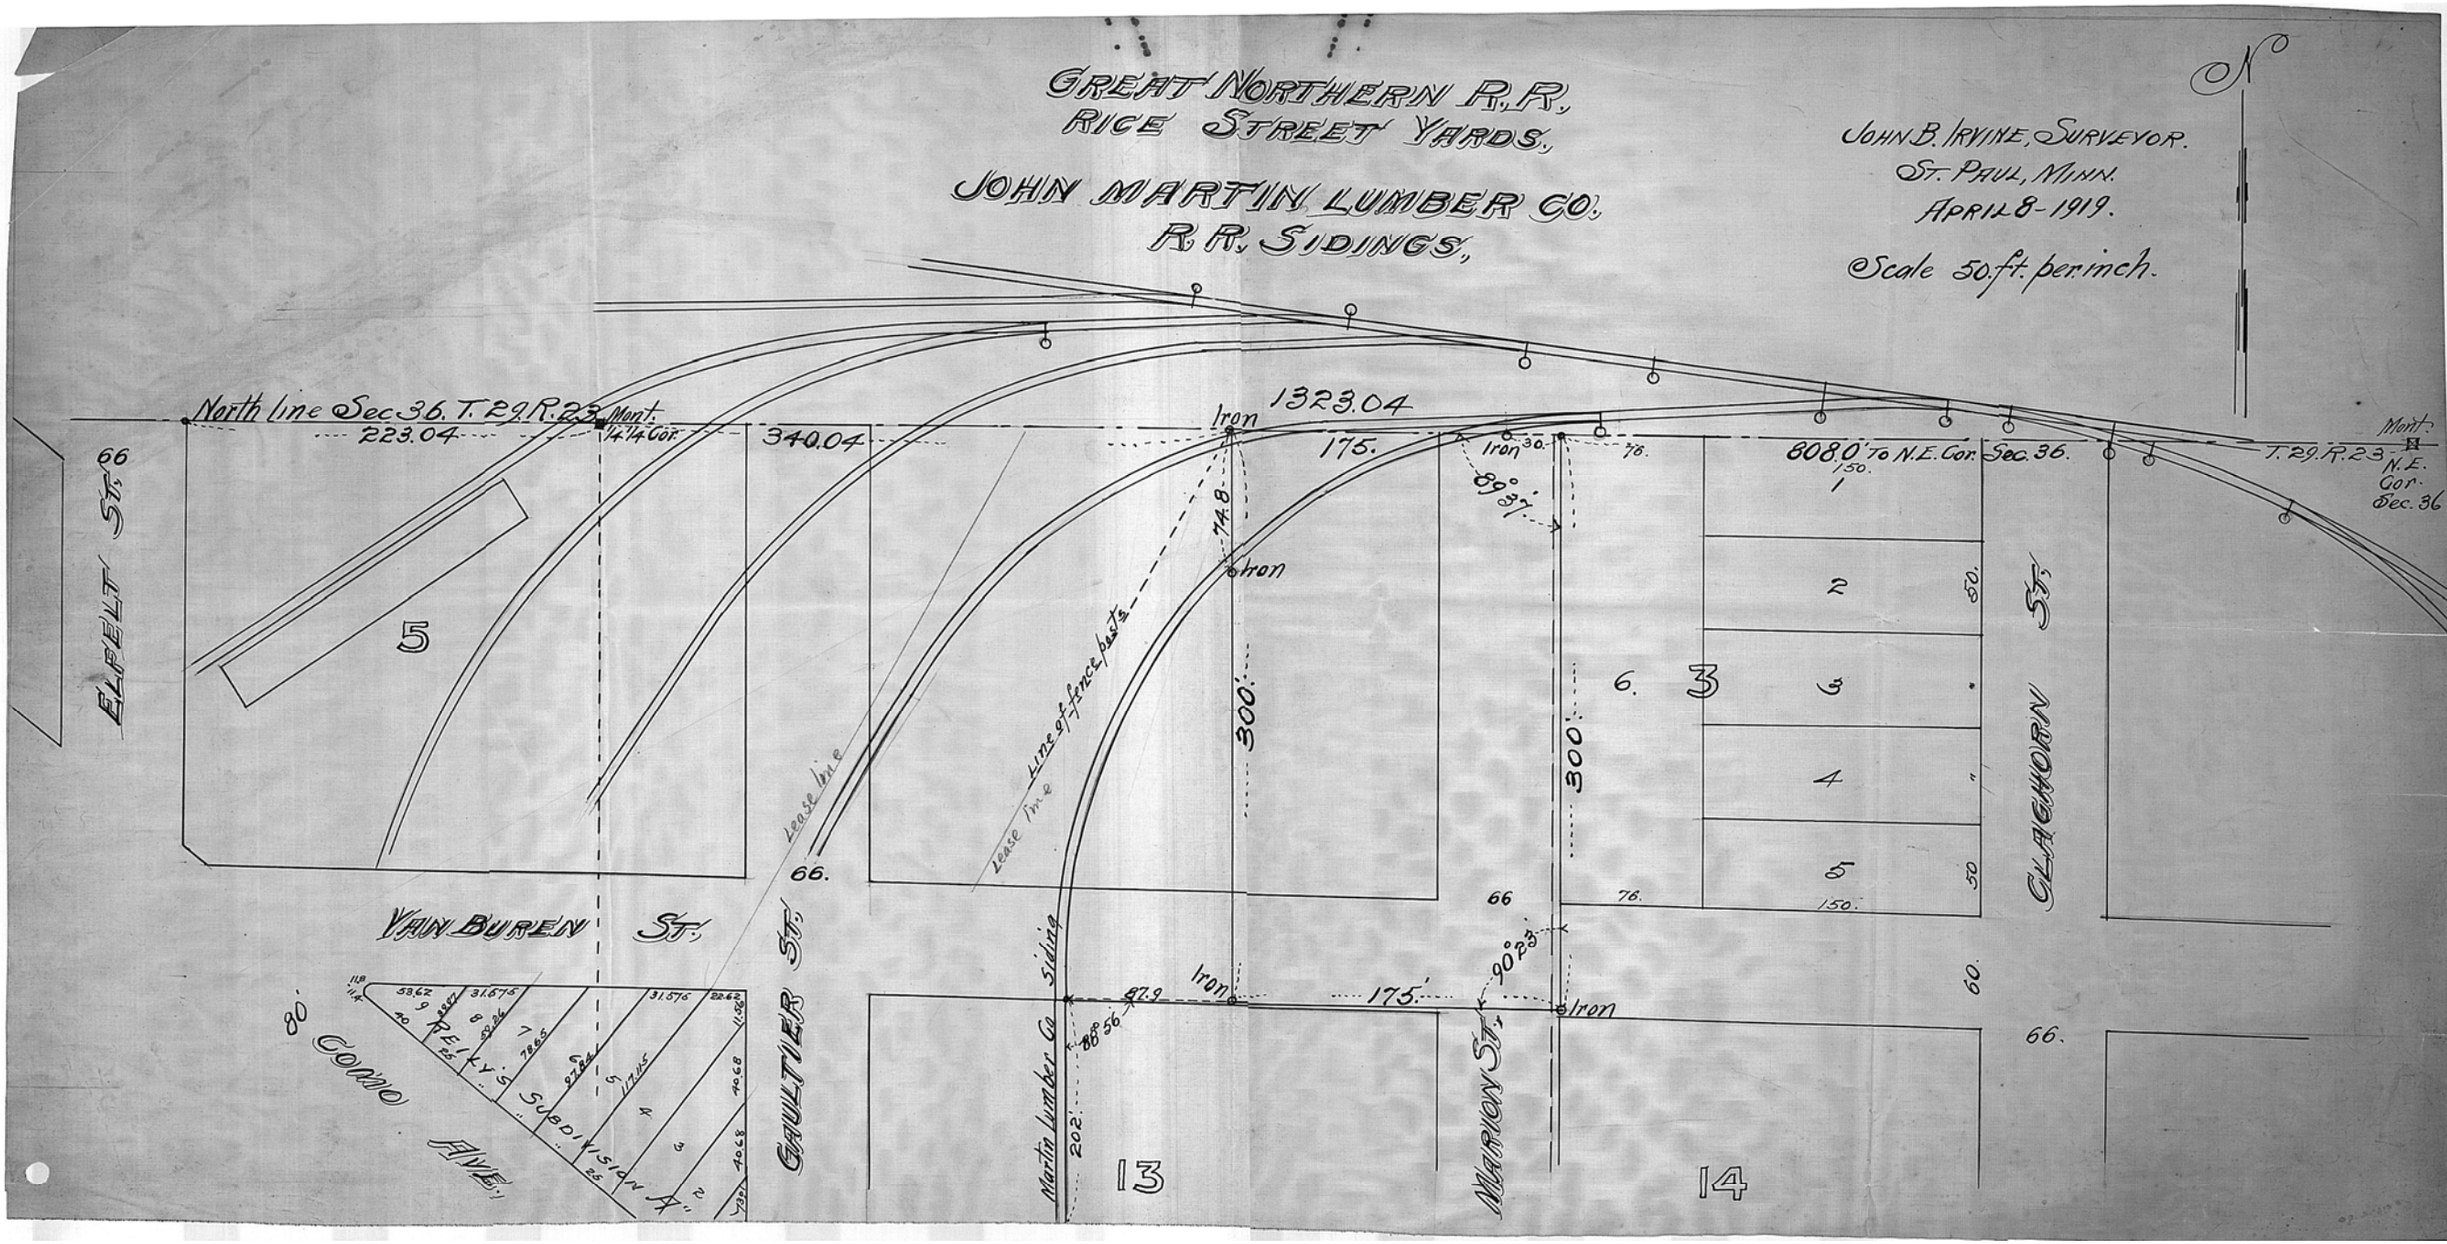
JOHN B. IRVINE, SURVEYOR.
ST. PAUL, MINN.
APRIL 8-1919.
Scale 50 ft. per inch.