34 29 23

LOT 11 BLOCK 5

HAMLINE SYNDICATE,

No 1.

John B. Irvine, Surveyor.

St. Paul, Minn.

July 19-1919
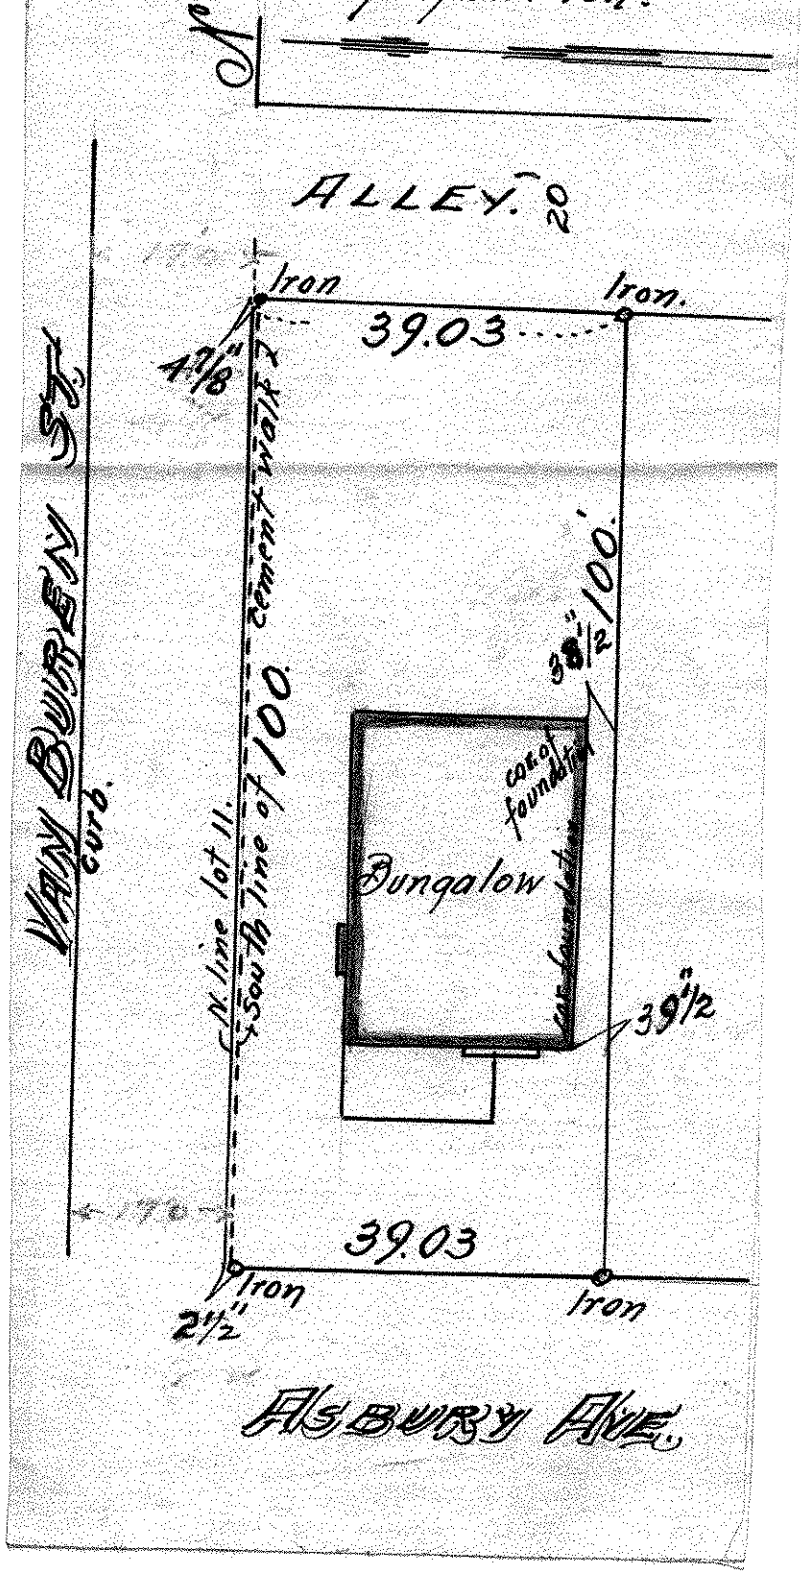
Scale 20 ft. per inch.