

LOTS 1, 2, 3, 4 & 5 BLOCK 13,

BAZILLE & ROBERTS ADD.

NO LOT 2 BLOCK 172

ROBERTSON'S ADD.

PART OF GOVT. LOT 7

SEC. 5, T. 28, R. 22.

JOHN B. IRVINE, SURVEYOR.

ST. PAUL, MINN.

JAN 30-1919

Scale 20 ft. per inch.


INDIANA AVE.

ST.

STARKEY

ST.

CUSTER

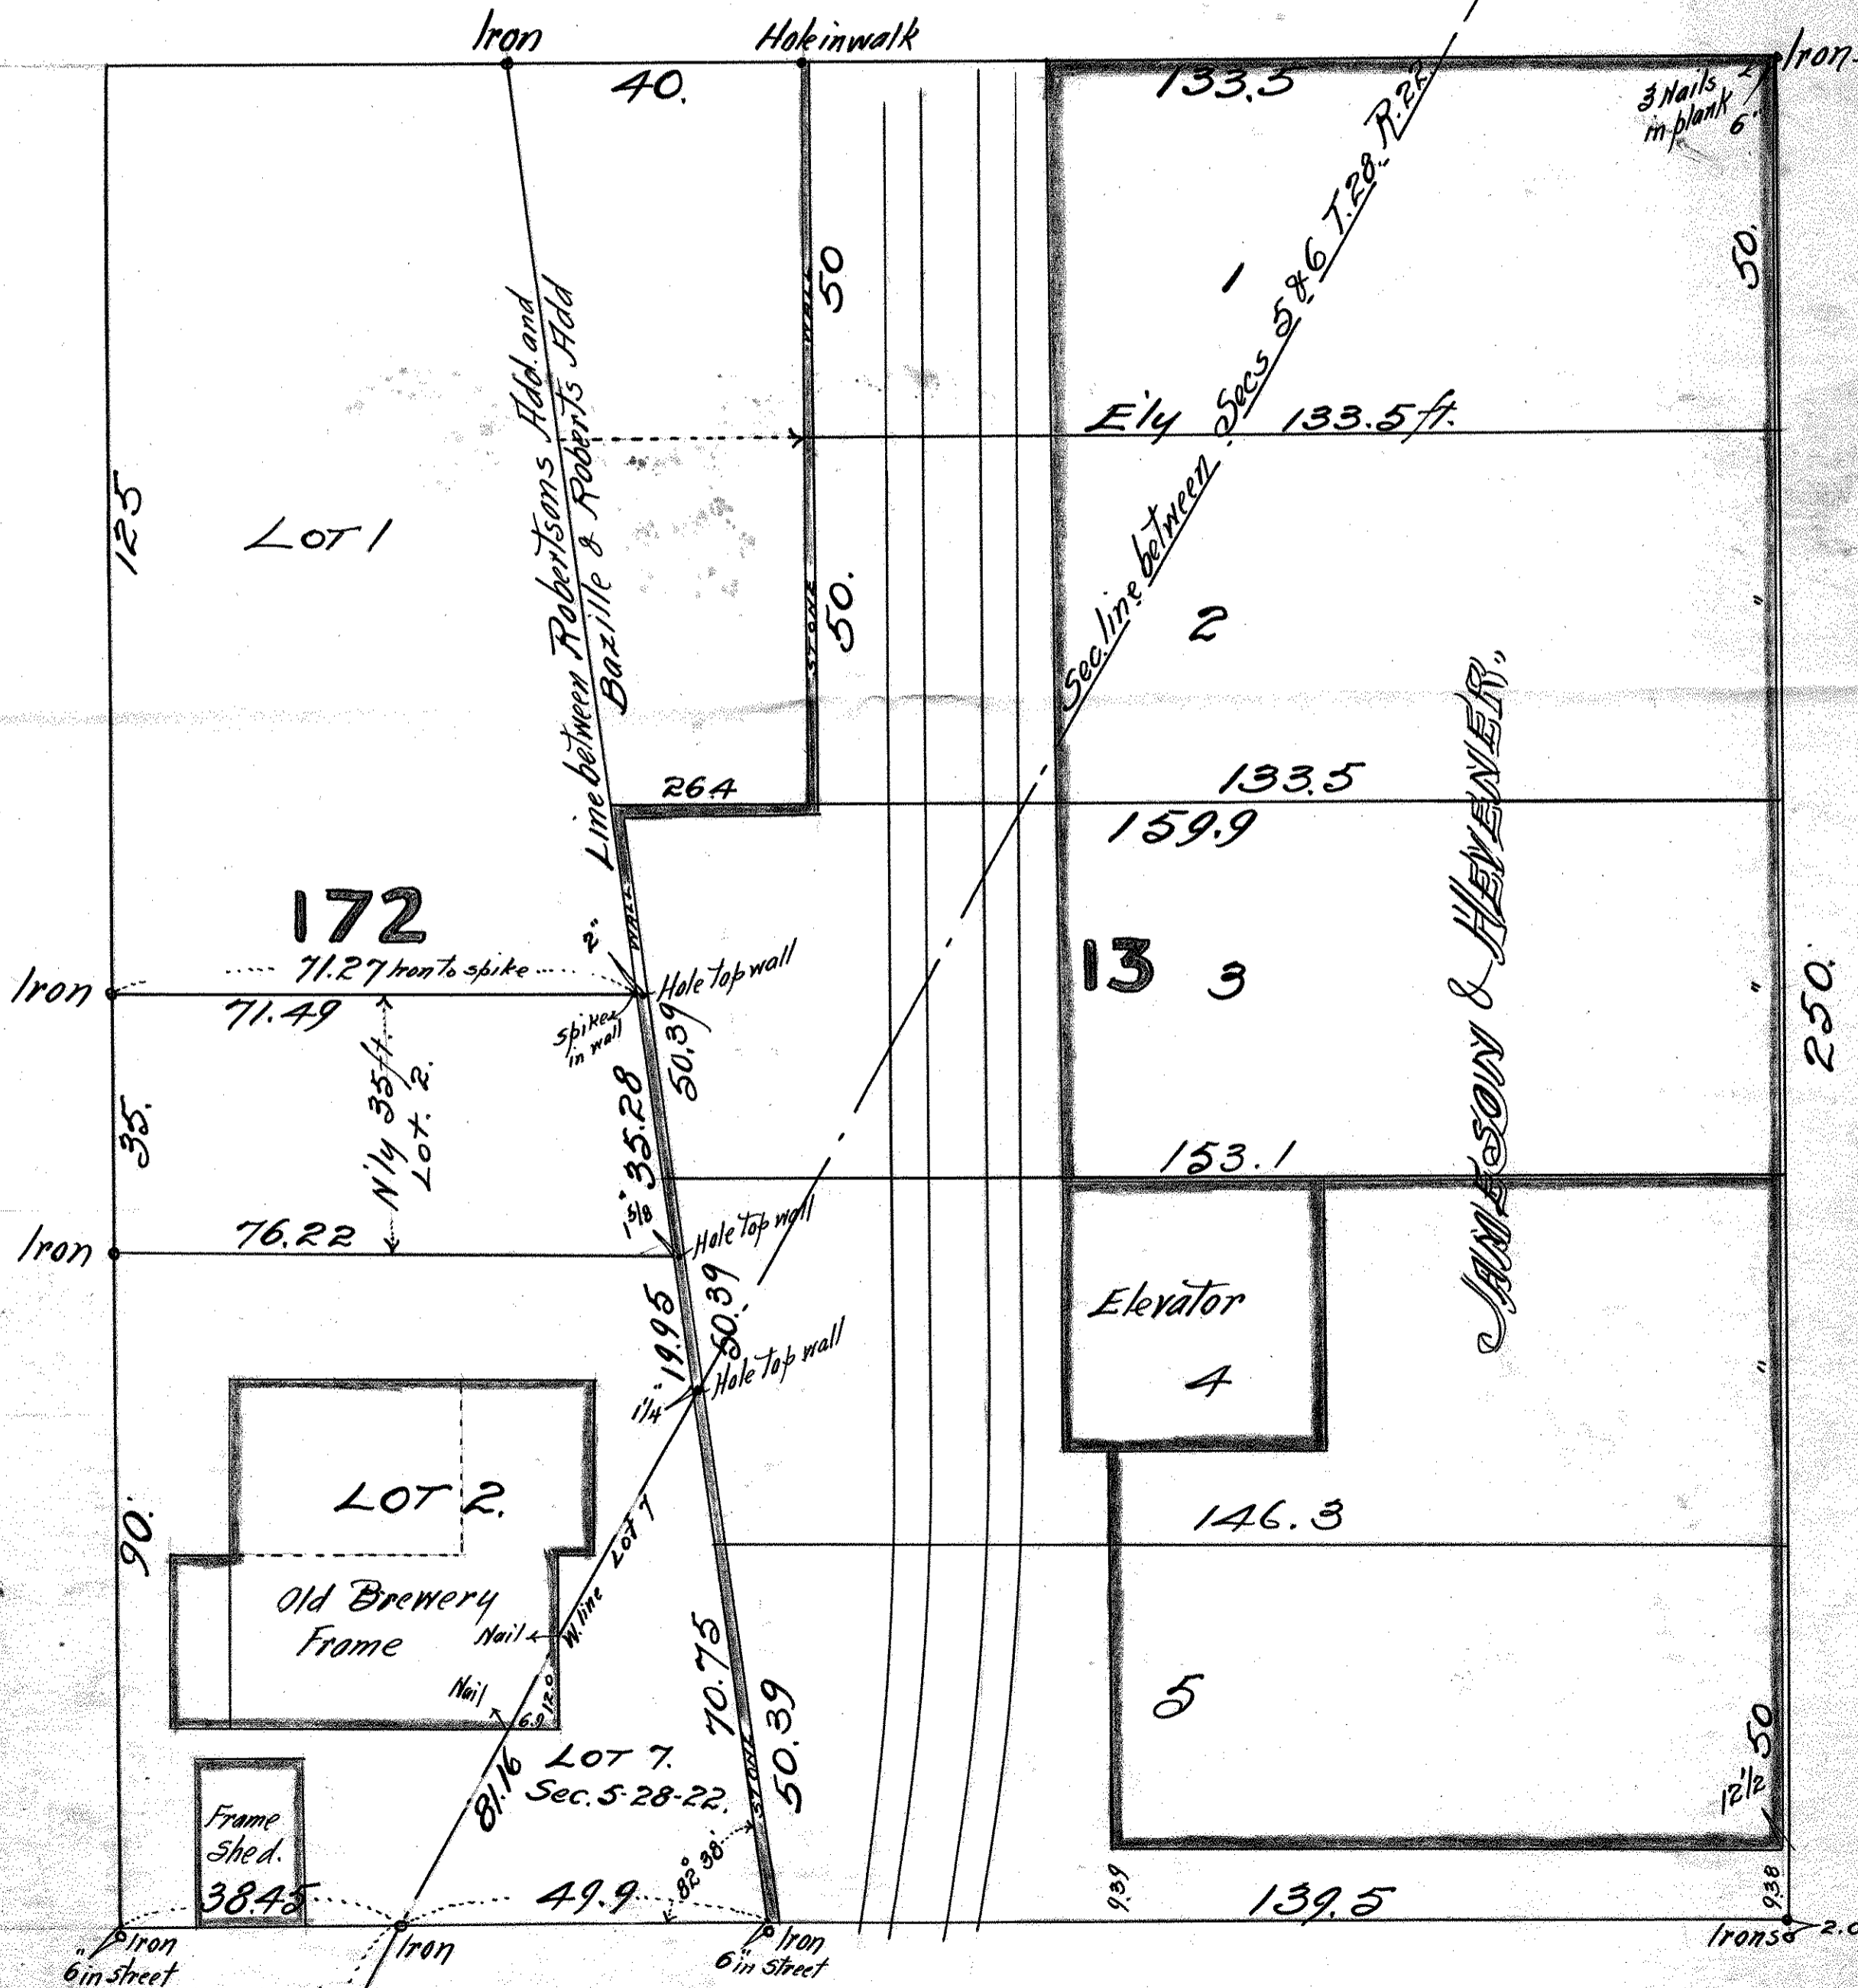

Mont S.W. Cor. Lot 7, Sec. 5, T. 28, R. 22.

CHICAGO AVE.