


E. $\frac{1}{2}$, E. $\frac{1}{2}$, SW. $\frac{1}{4}$ & $\frac{1}{2}$
 W. $\frac{1}{2}$ SW. $\frac{1}{4}$ SW. $\frac{1}{4}$.
 SECTION 21, T. 29, R. 23.
 John B. Irvine, Surveyor.
 Nov. 1920.
 Scale 200 ft. per inch.

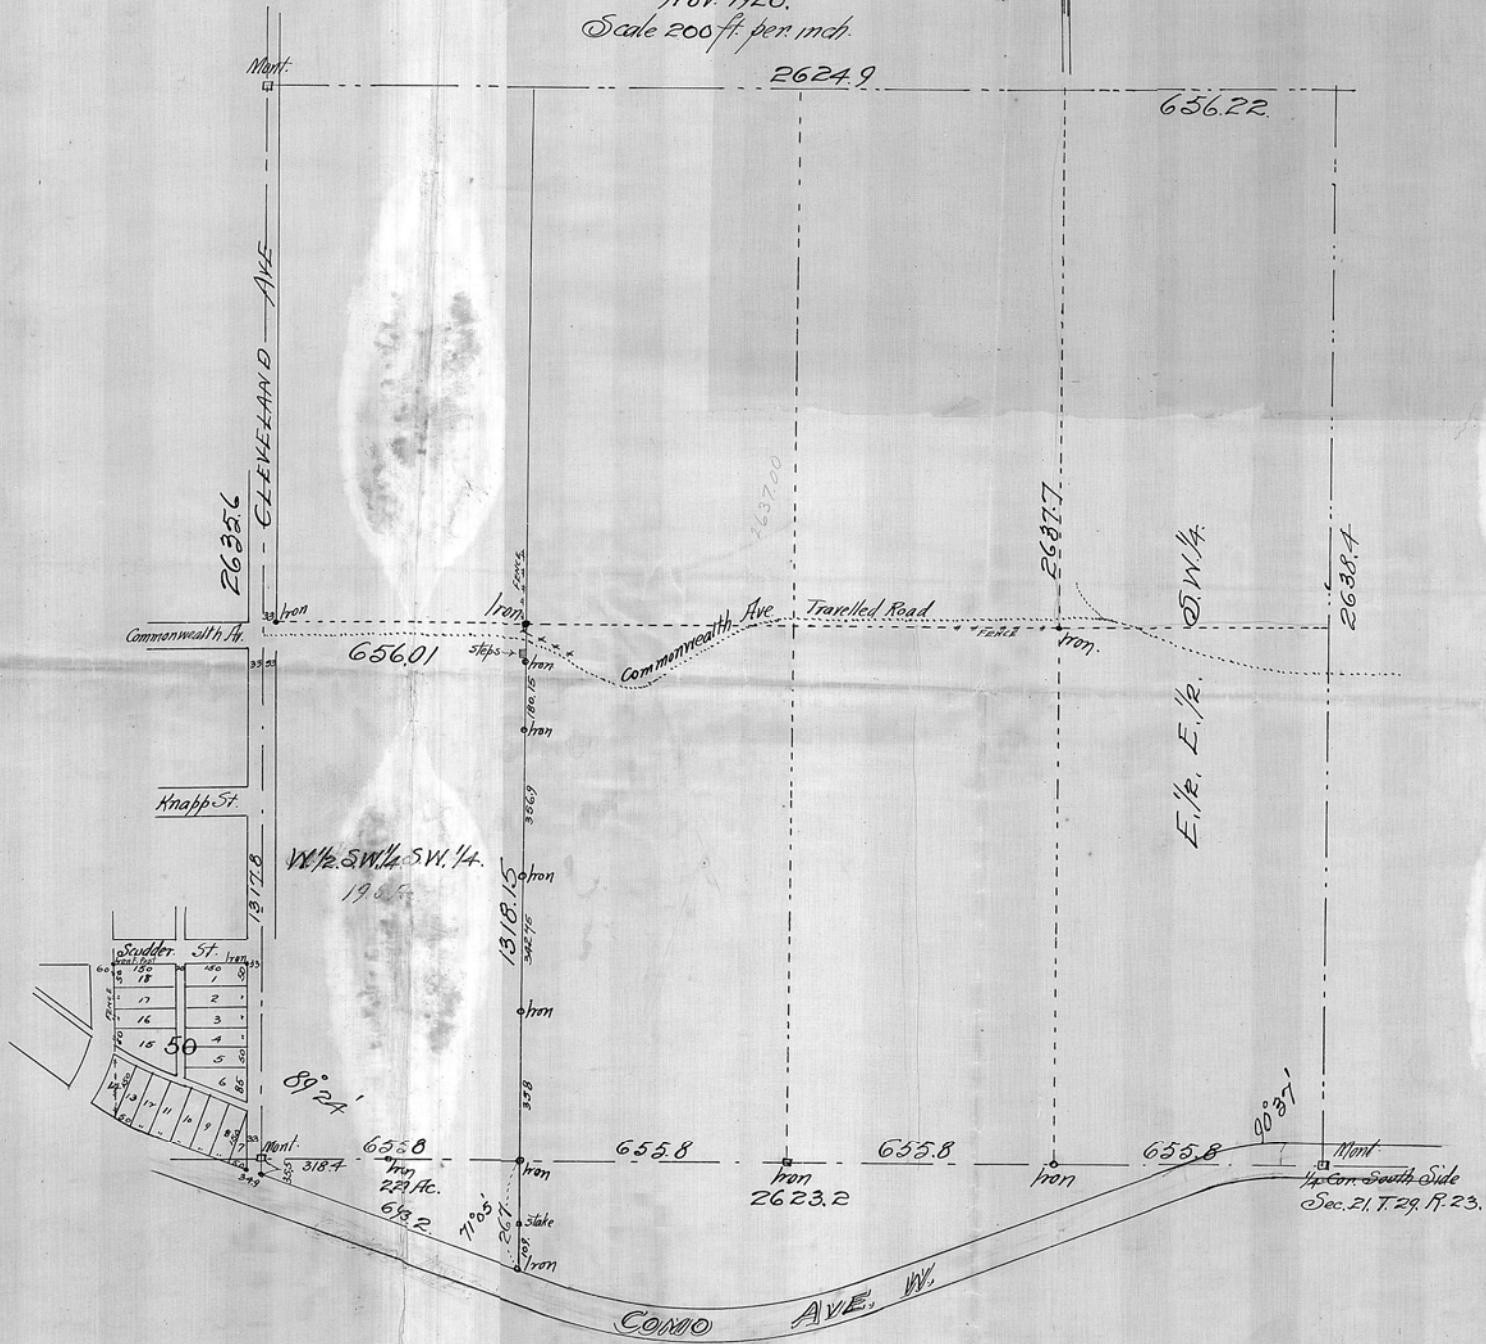

Sudder St.

18	1
17	2
16	3
15	4
14	5
13	6
12	7
11	8
10	9

50