

LOT 25 BLOCK 3  
BIRMINGHAM'S PARK.

John B. Irvine, Surveyor


285 Mackubin St.

St Paul, Minn.

Oct. 16-1920.

Scale 20ft. per. inch.

ALLEY

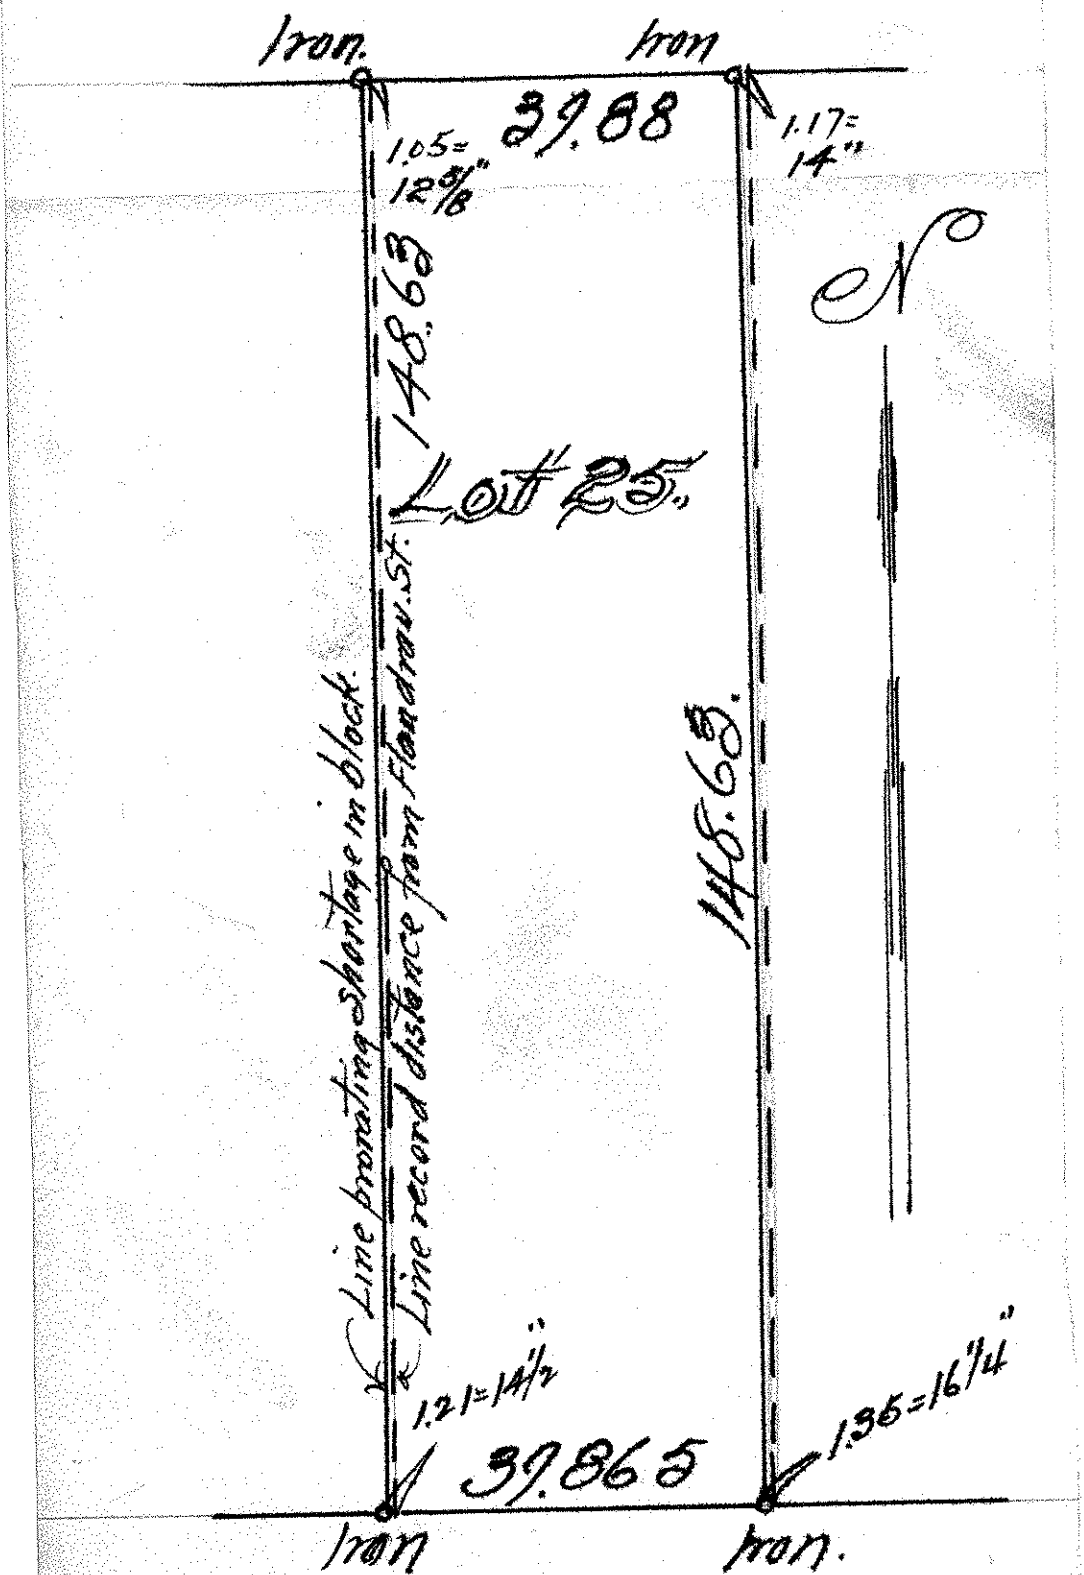

KERVIN. ST.