

LOT 20 BLOCK 3
BURMINGHAM'S PARK,


John B. Irvine, Surveyor.

285 Mackubin St.

St. Paul, Minn.

Oct. 16, 1920.

Scale 20 ft. per inch.

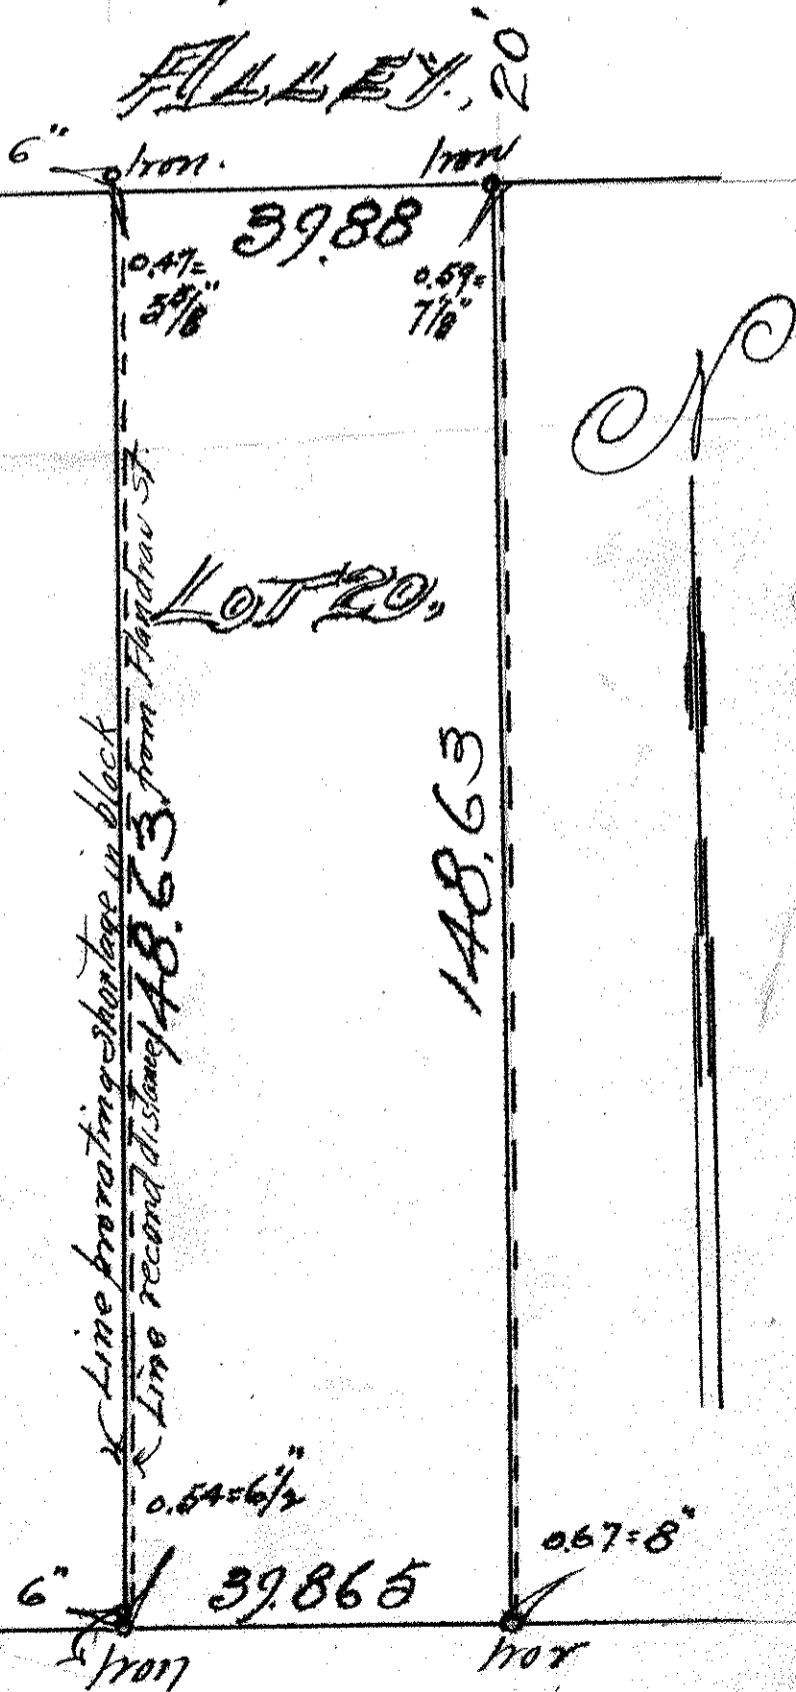

KERWIN ST.