


# LOT 4 BLOCK 98

## BANNING & OLIVER'S ADD.

John B. Irvine, Surveyor.

May 18th 1920.

Scale 20ft. per. inch.

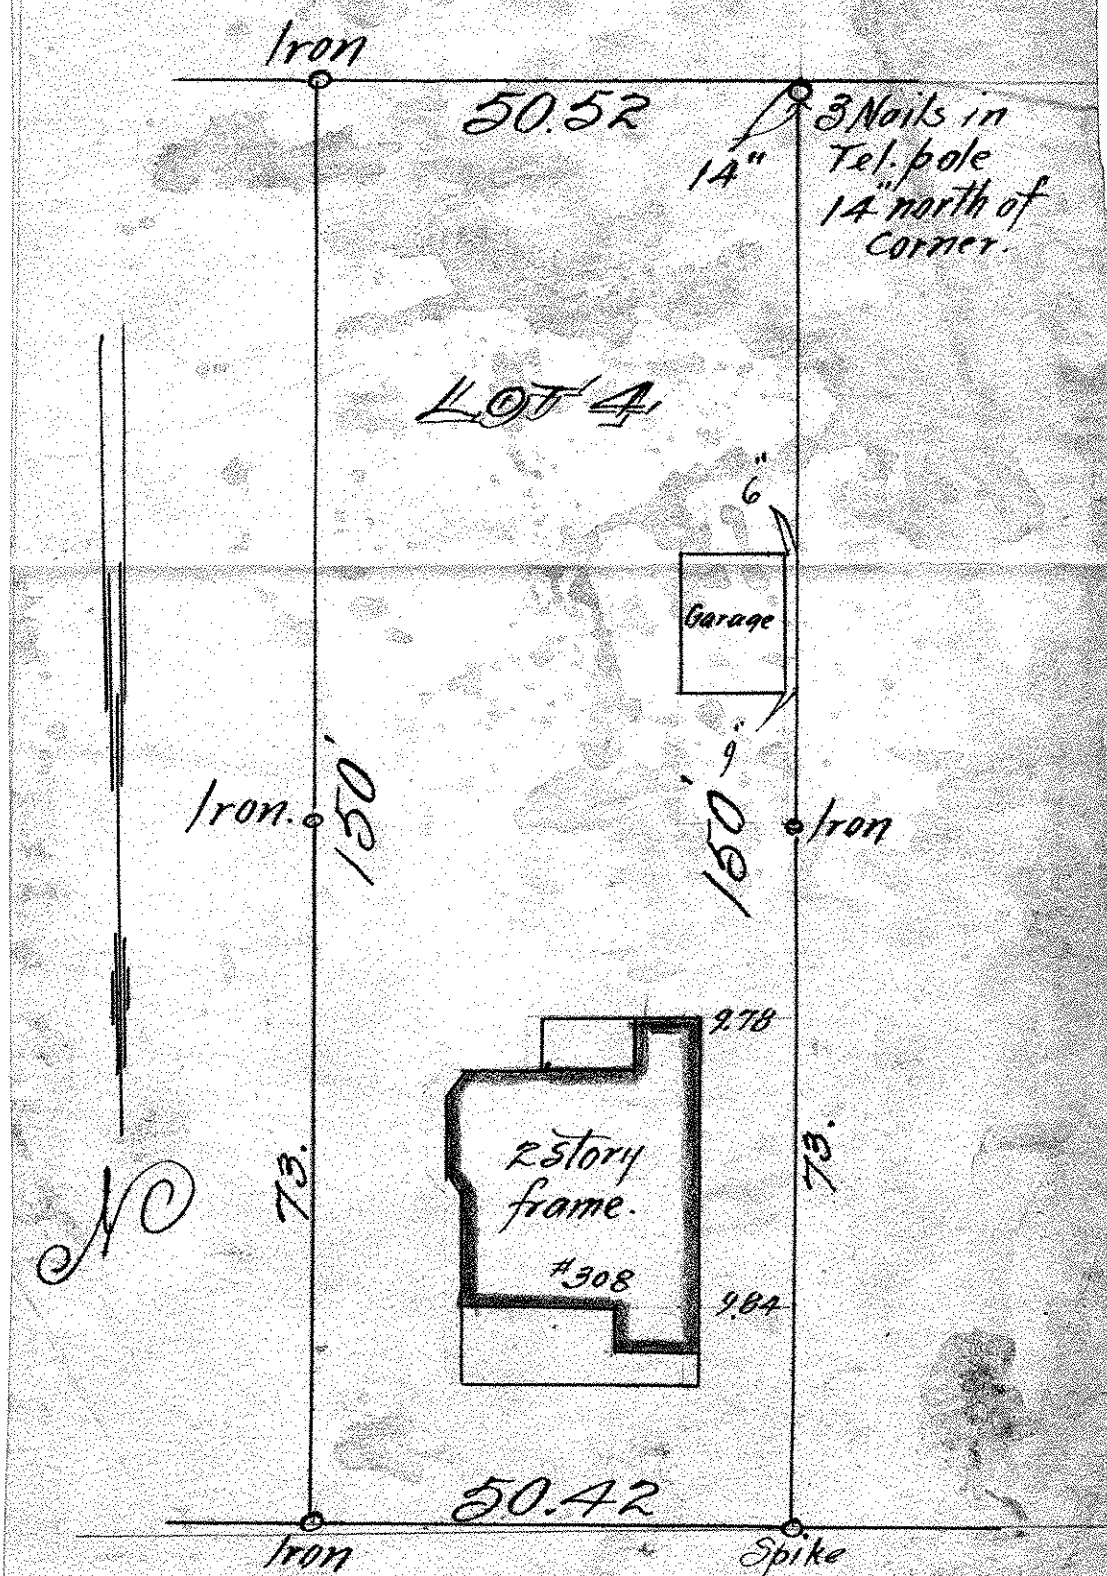

PAGE 511