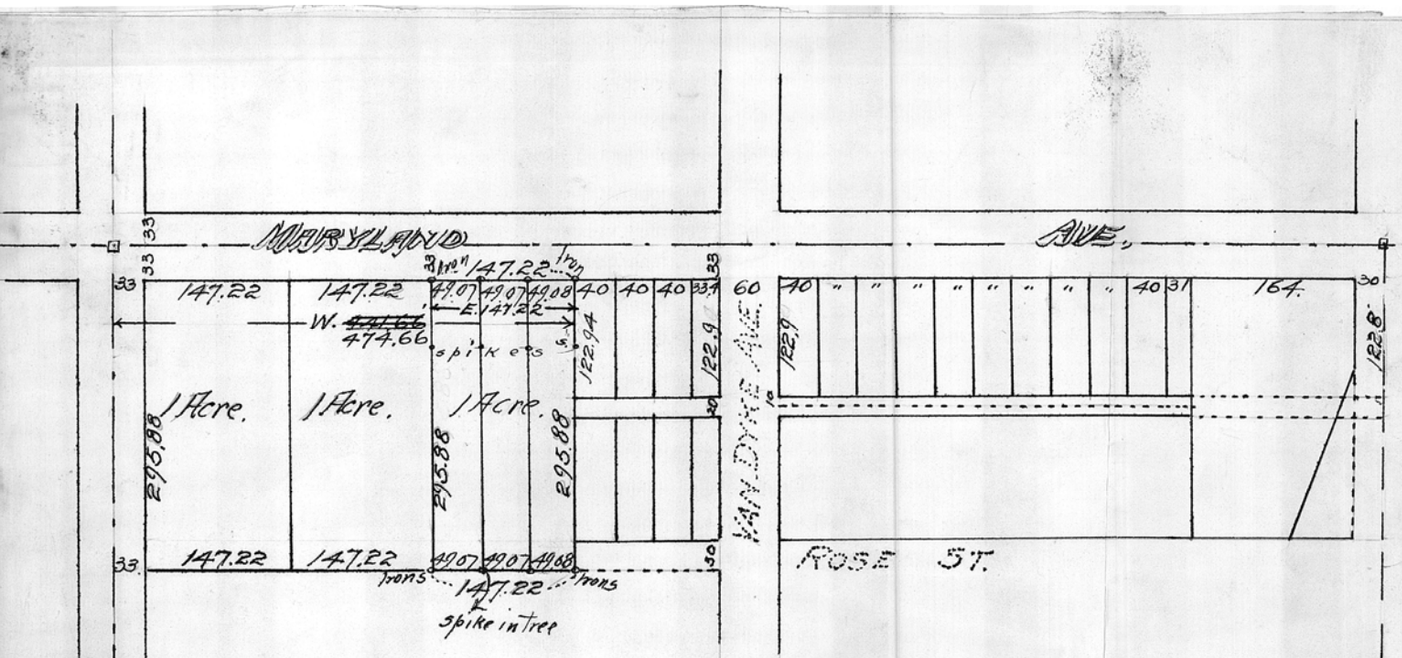

ONE ACRE,

EAST 147.22 ft. of WEST ~~474.66~~ 474.66 ft.
OF THE SOUTH 295.88 ft. of THE NORTH
328.88 ft. of THE N.W.¼ of N.W.¼ OF
SECTION 26, TOWN 29, RANGE 22,

John B. Irvine Surveyor.
August. 4-1921
Scale. 100 ft. per inch.

N