


WEST 50 FT. LOT 8 BLOCK 1.

BROWN'S 1ST ADD.

John B. Irvine, Surveyor.

April 18th 1921.

Scale. 20 ft. per inch.

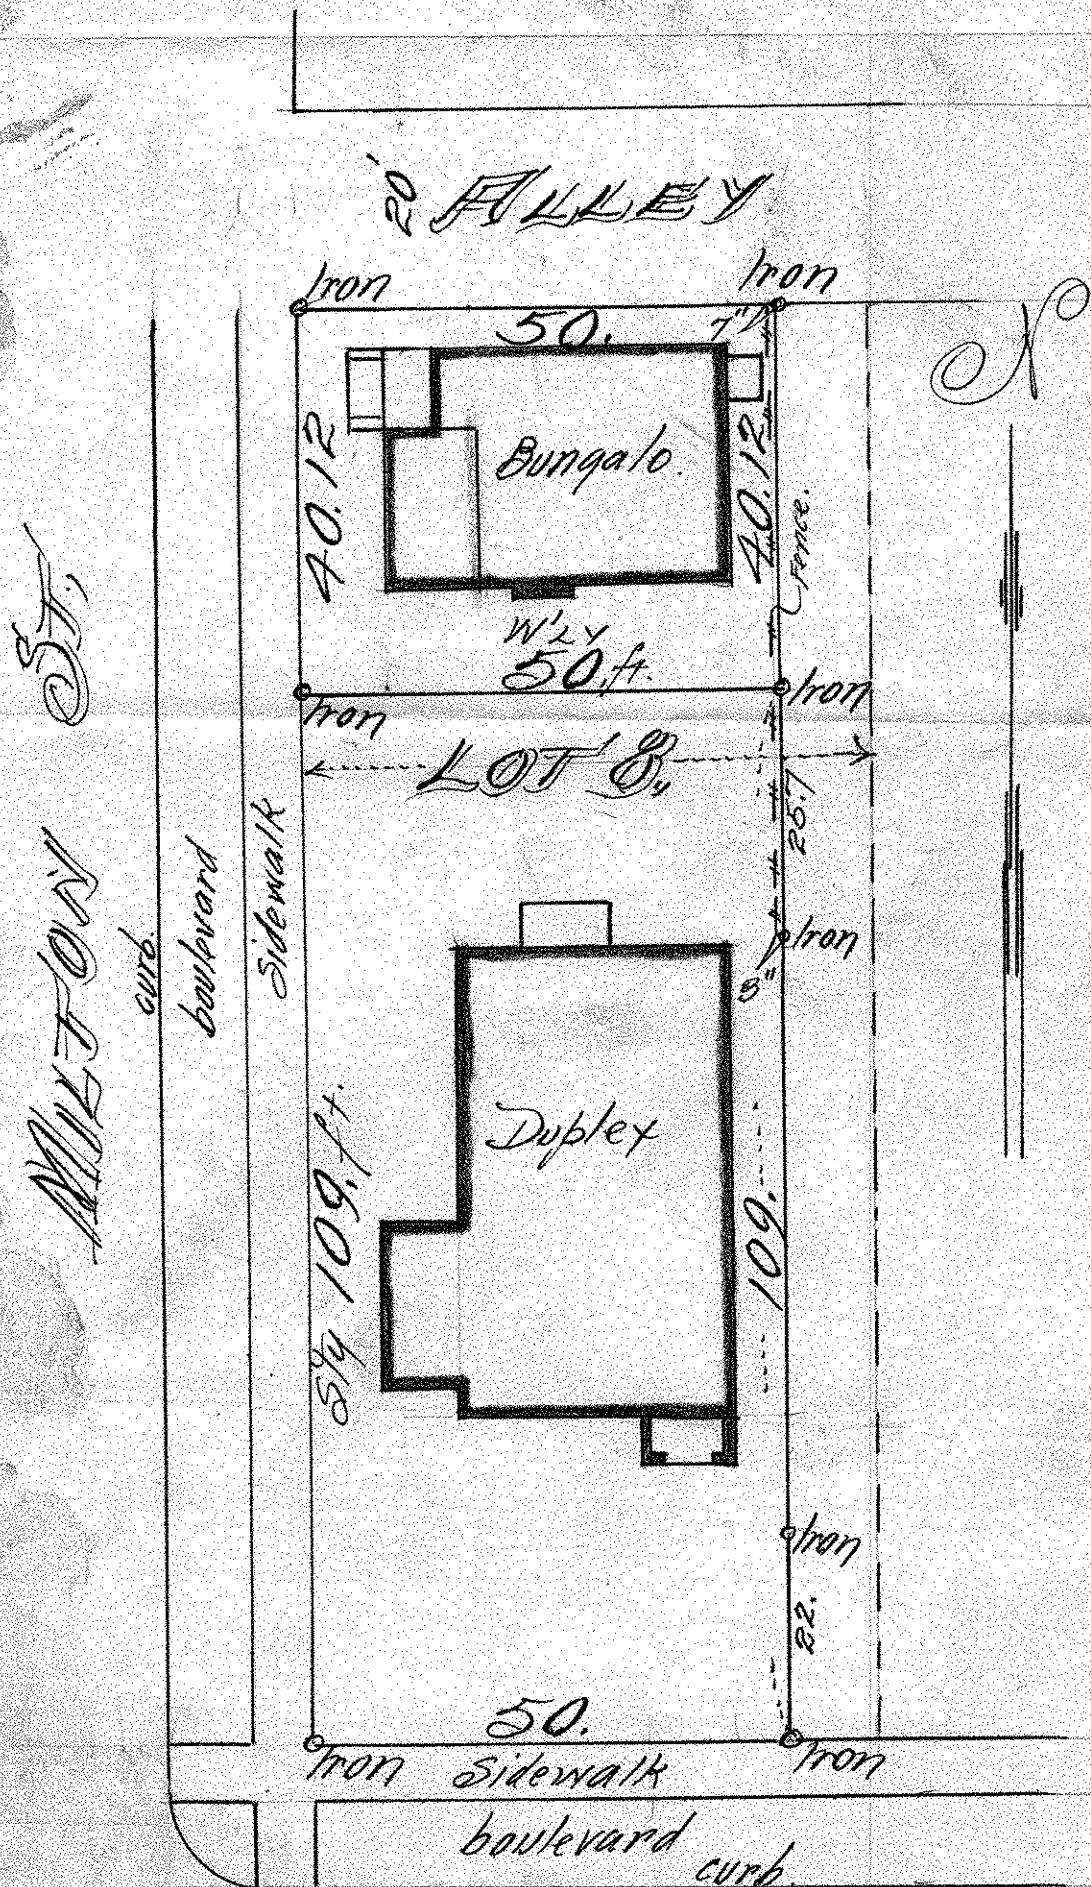

DAYTON AVE.