


RAMSEY COUNTY
MINNESOTA

SURVEY OF ALL OF THE
S.W. 1/4 OF SEC. 2, T. 29-N., R. 22-W
LYING W. OF & OF WHITE
BEAR ROAD

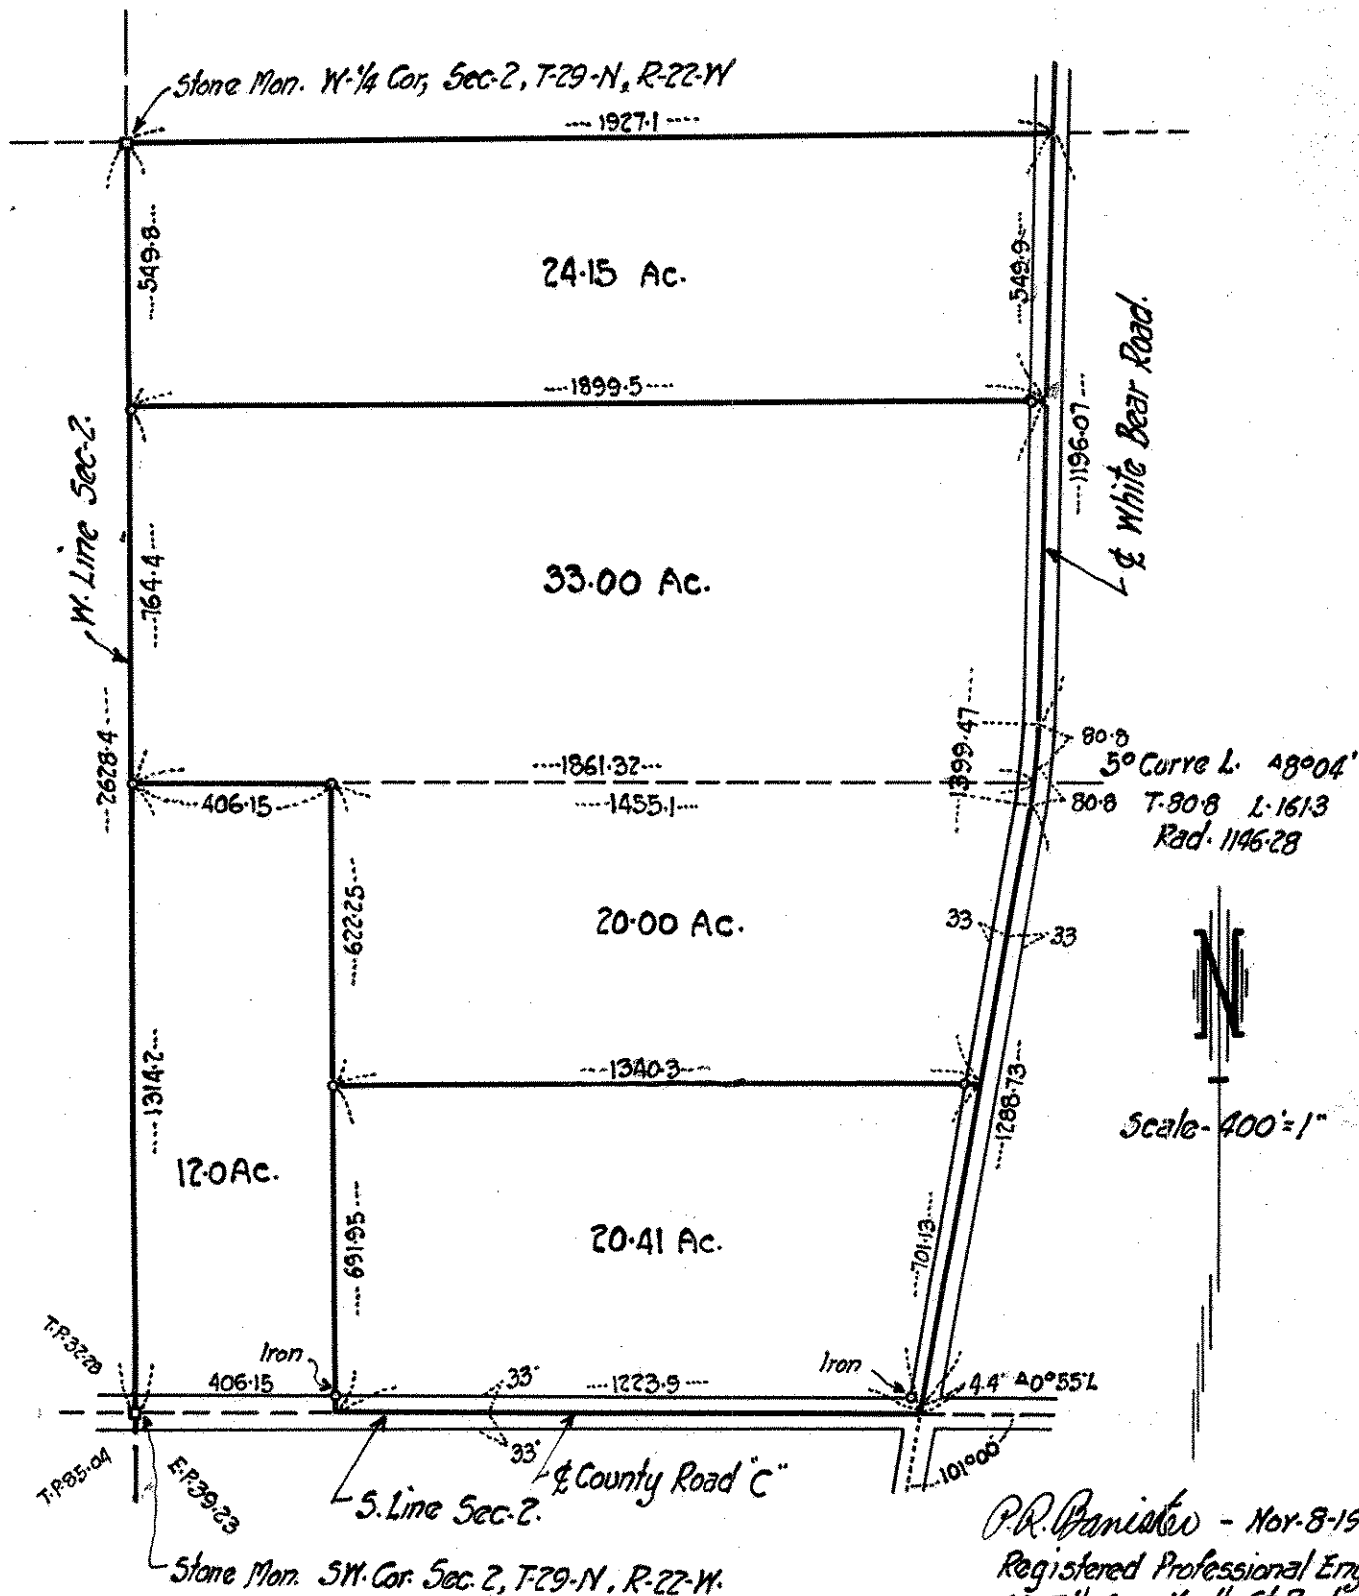

P.R. Panistev - Nov. 8-1928
Registered Professional Engr.
69-7th Ave - North St. Paul
Phone N.S.P. 407

FILE-2-29-22

Sec 2-29-22