


WABASSO ST

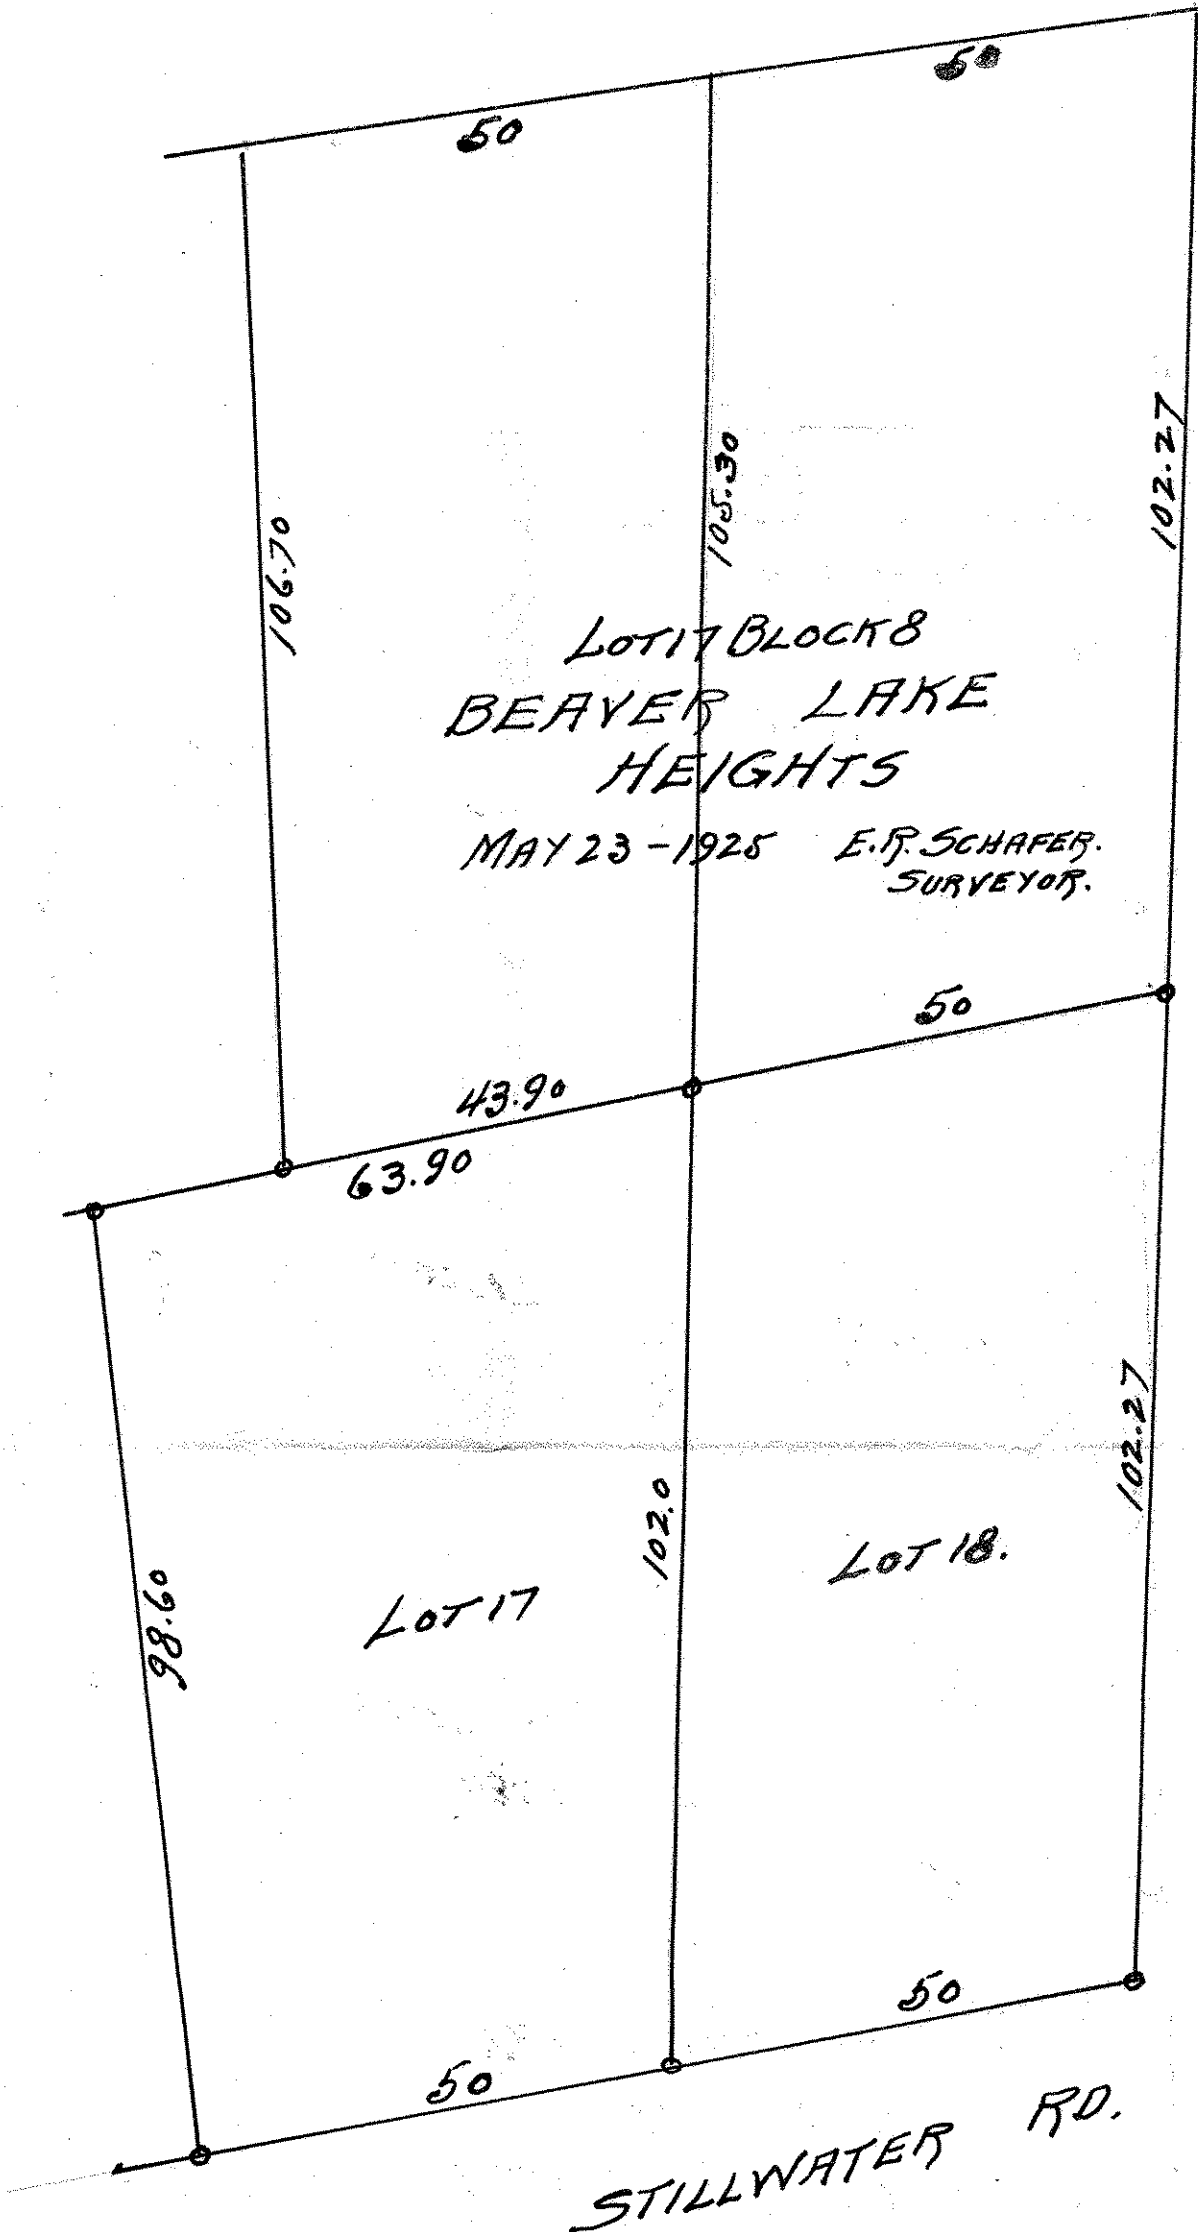

LOT 17 BLOCK 8
BEAVER LAKE
HEIGHTS

SURVEYOR.

LOT 17

LOT 18.

1700 QUIS ST

STILLWATER RD.