Proposed Roads in Govt Lot 3 Sec. 1. T. 29. R. 22

John B. Irvine, Surveyor.

July 28, 26 - 1921.
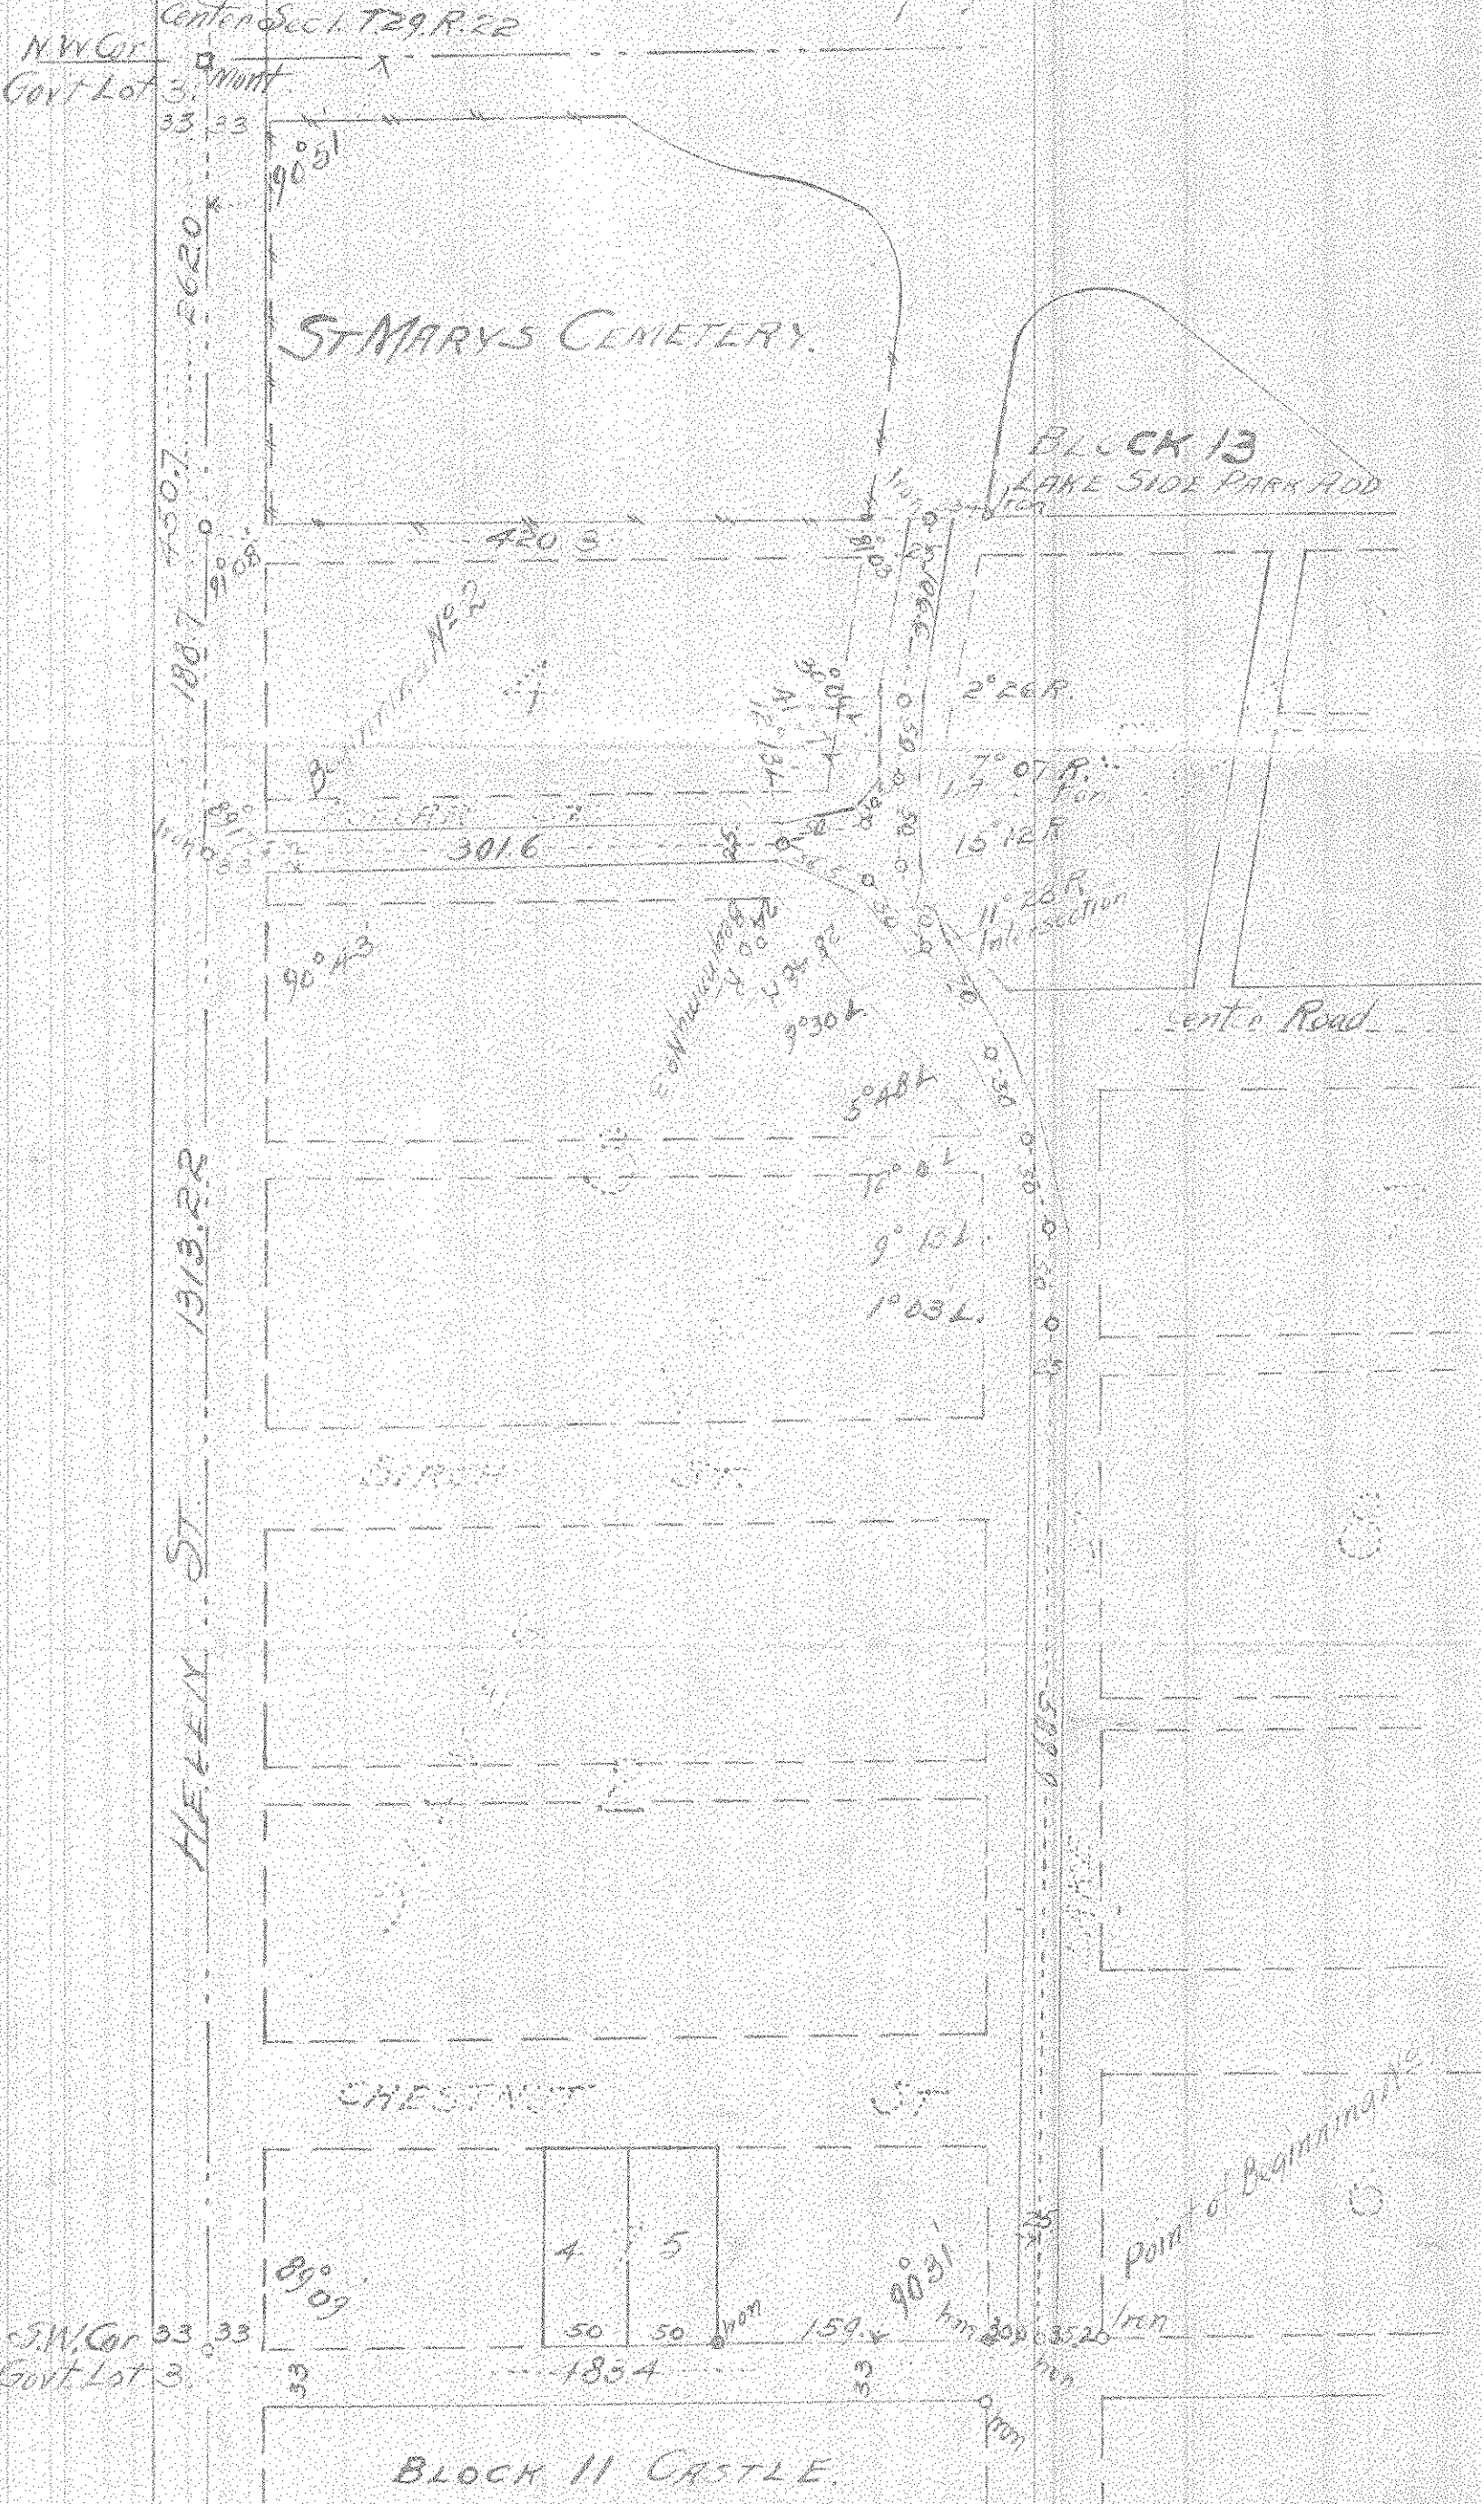
Scale 100 ft. per inch.