


(2)

3-30-22

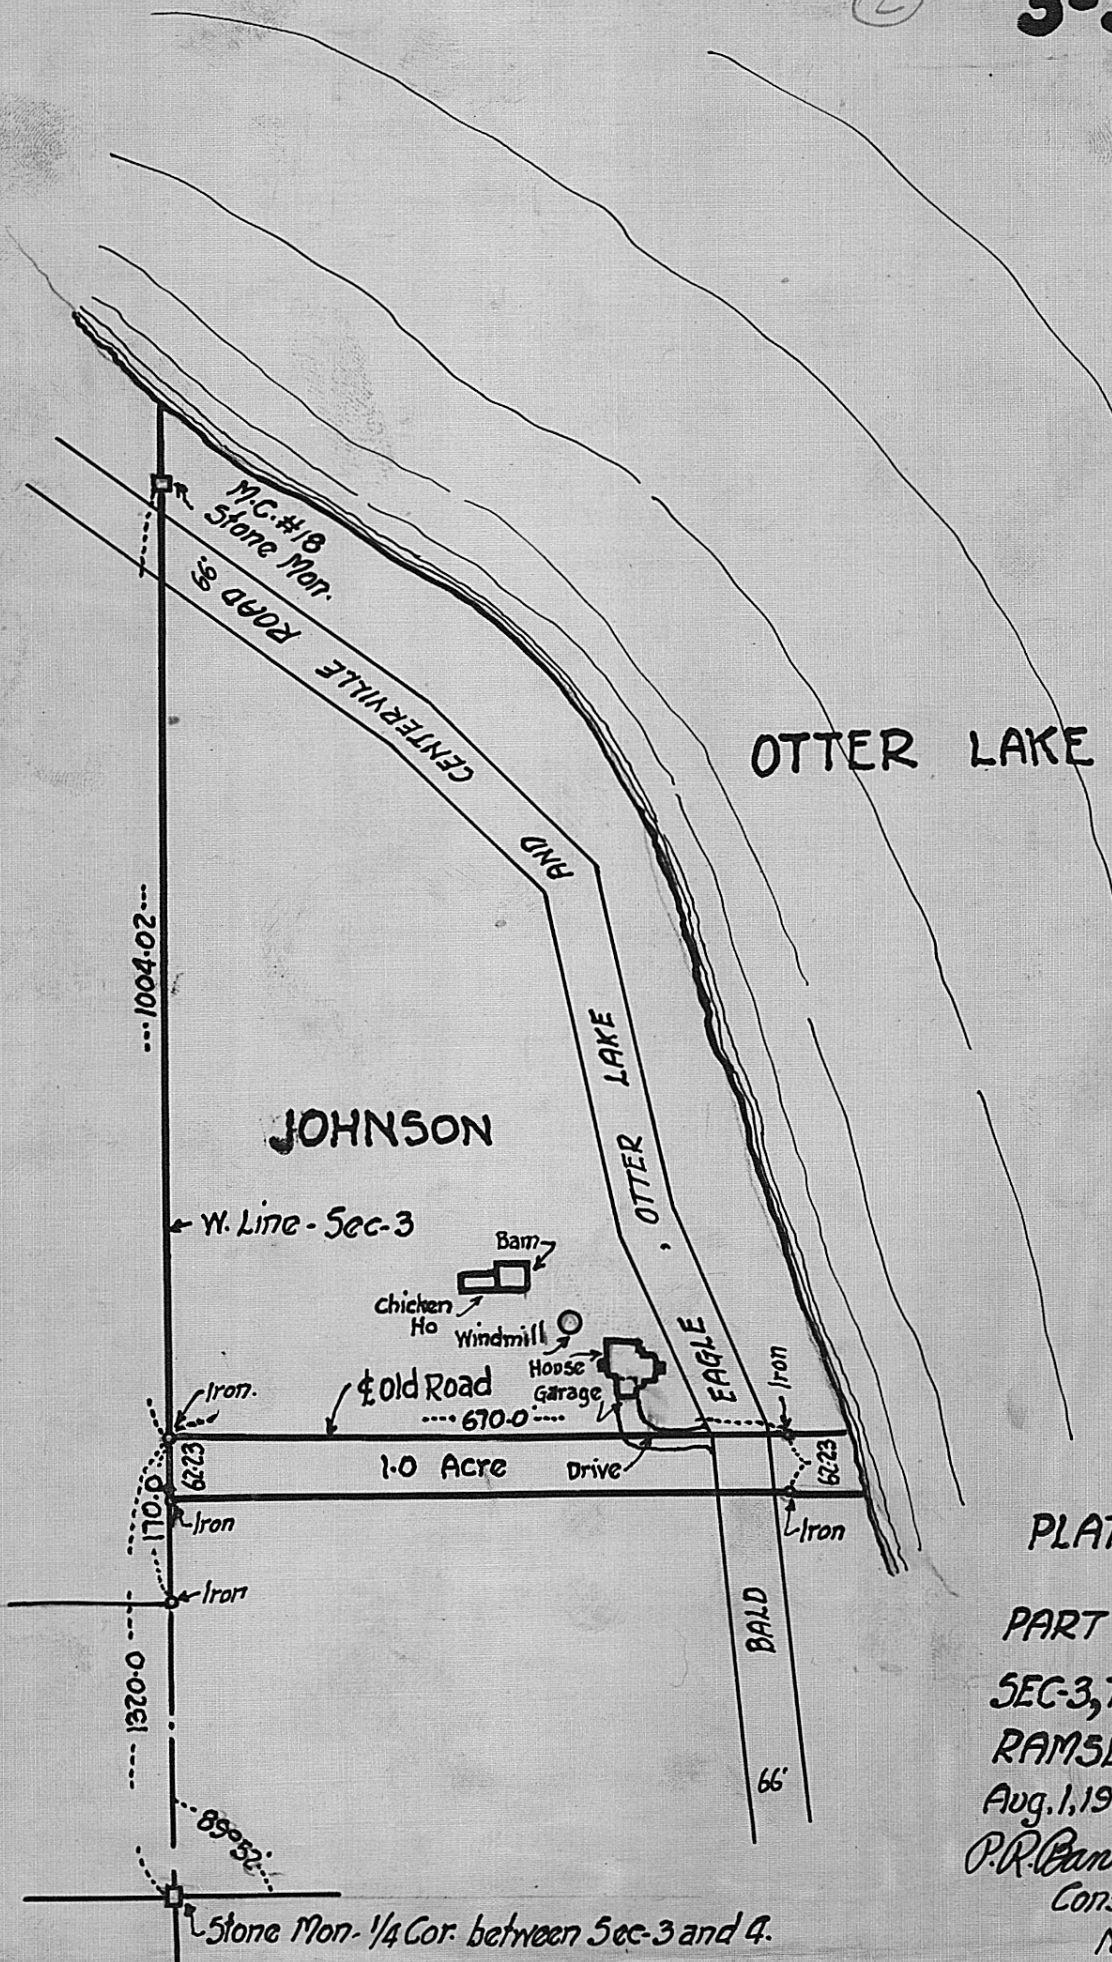

PLAT OF SURVEY
 OF
 PART OF GOV. LOT-1
 SEC-3, T-30-N, R-22-W
 RAMSEY CO. MINN
 Aug. 1, 1929, Scale 100=1"
 P.R. Banister
 Consulting Engineer
 North St. Paul, Minn.