


SURVEY OF
 PART OF GOV. LOT 5, SEC. 36.
 T-30-N, R-23-W - RAMSEY COUNTY

By P. R. Arnister - Registered Professional Engr.
 Res-139-18th Ave Office-69-7th Ave
 Phone N.S.P. 448 Phone - N.S.P. 407

NORTH ST. PAUL Feb-2-1929

Scale-100=1"

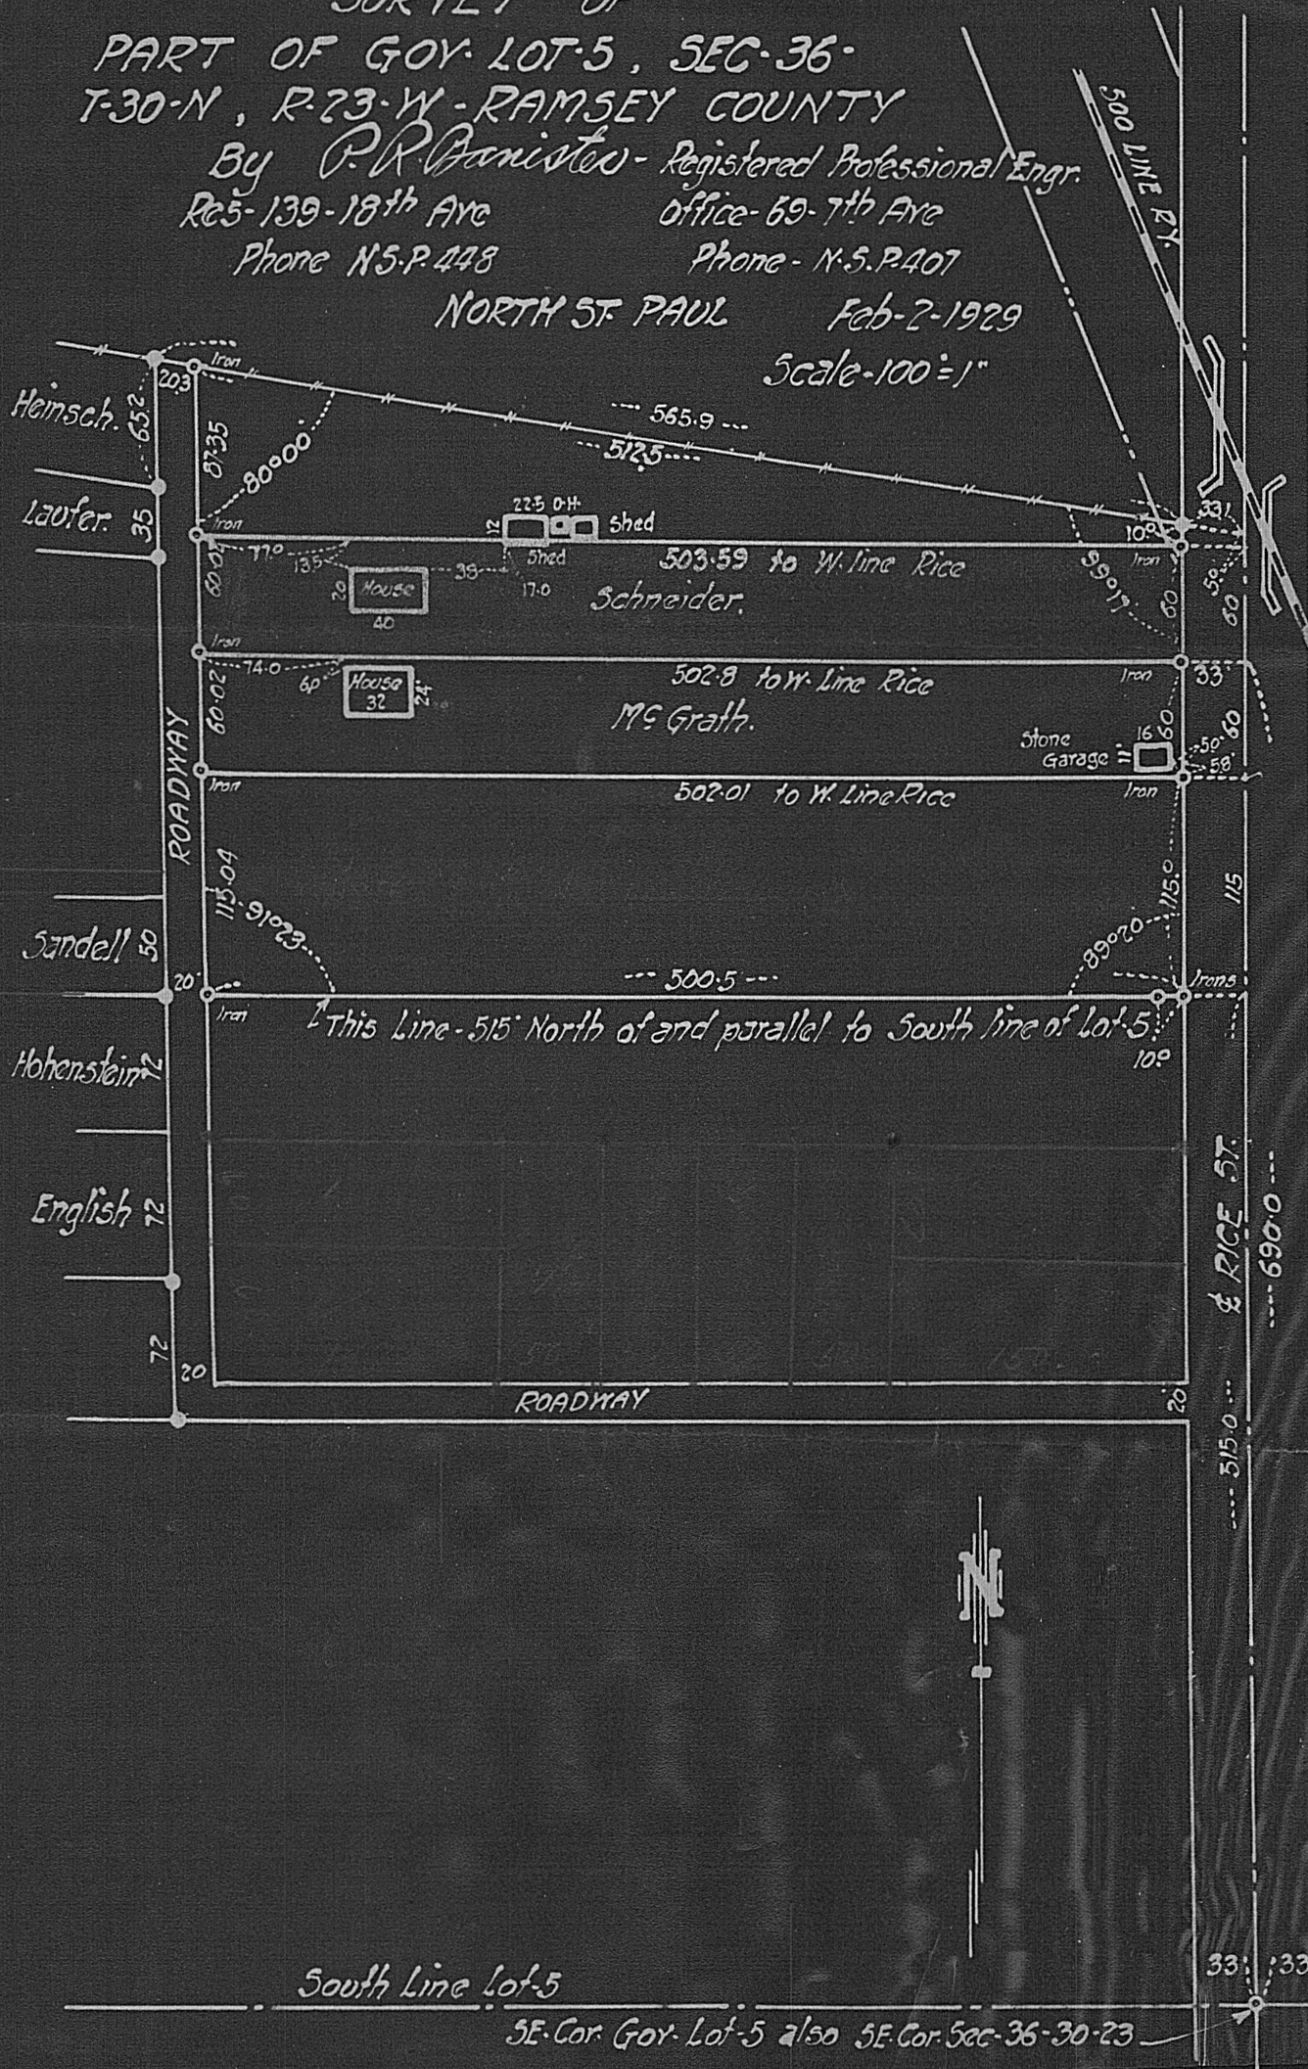

South Line Lot 5

SE. Cor. Gov. Lot 5 also SE. Cor. Sec. 36-30-23