LAMBERT SUBURBAN TRACTS
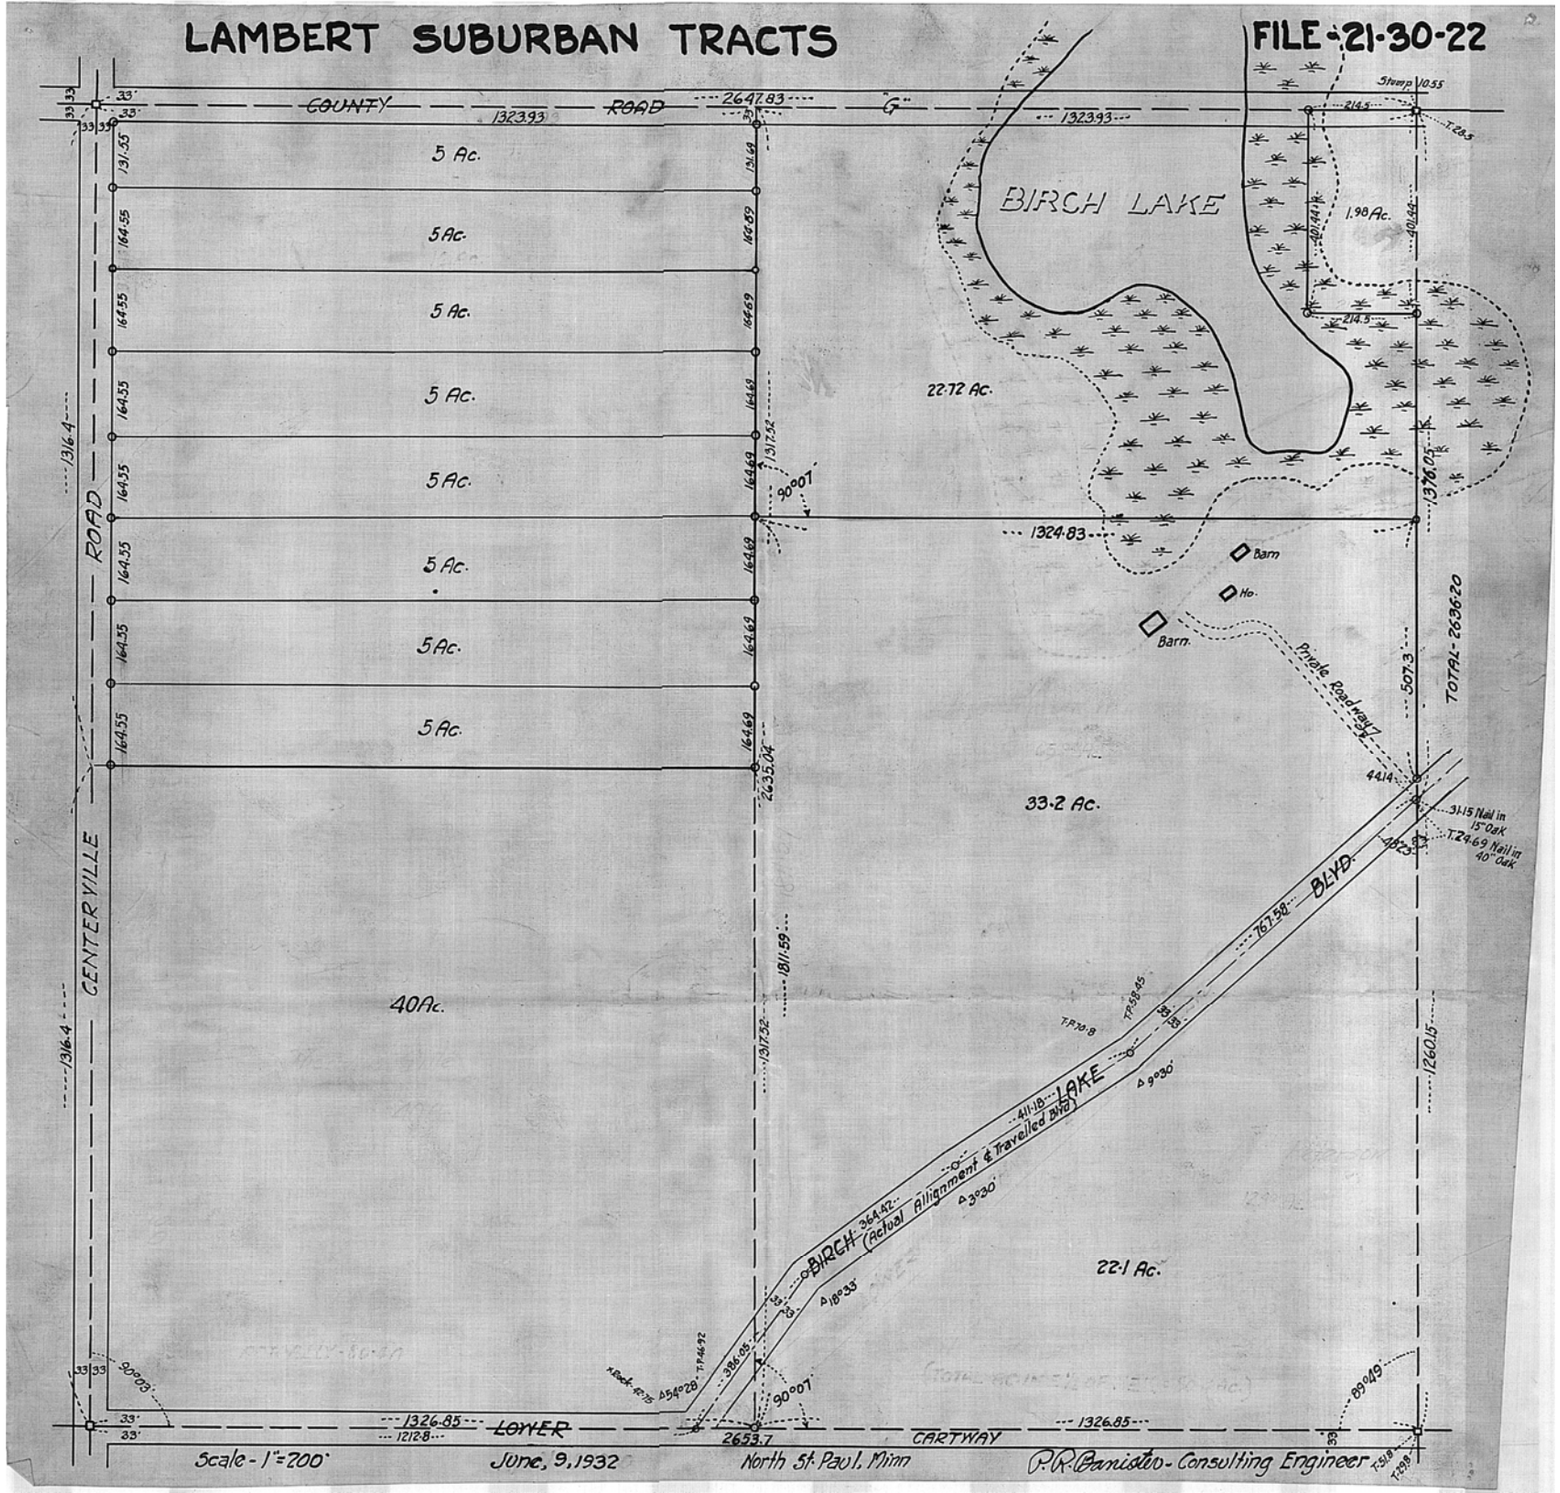
FILE - 21-30-22