


FILE-1-29-22

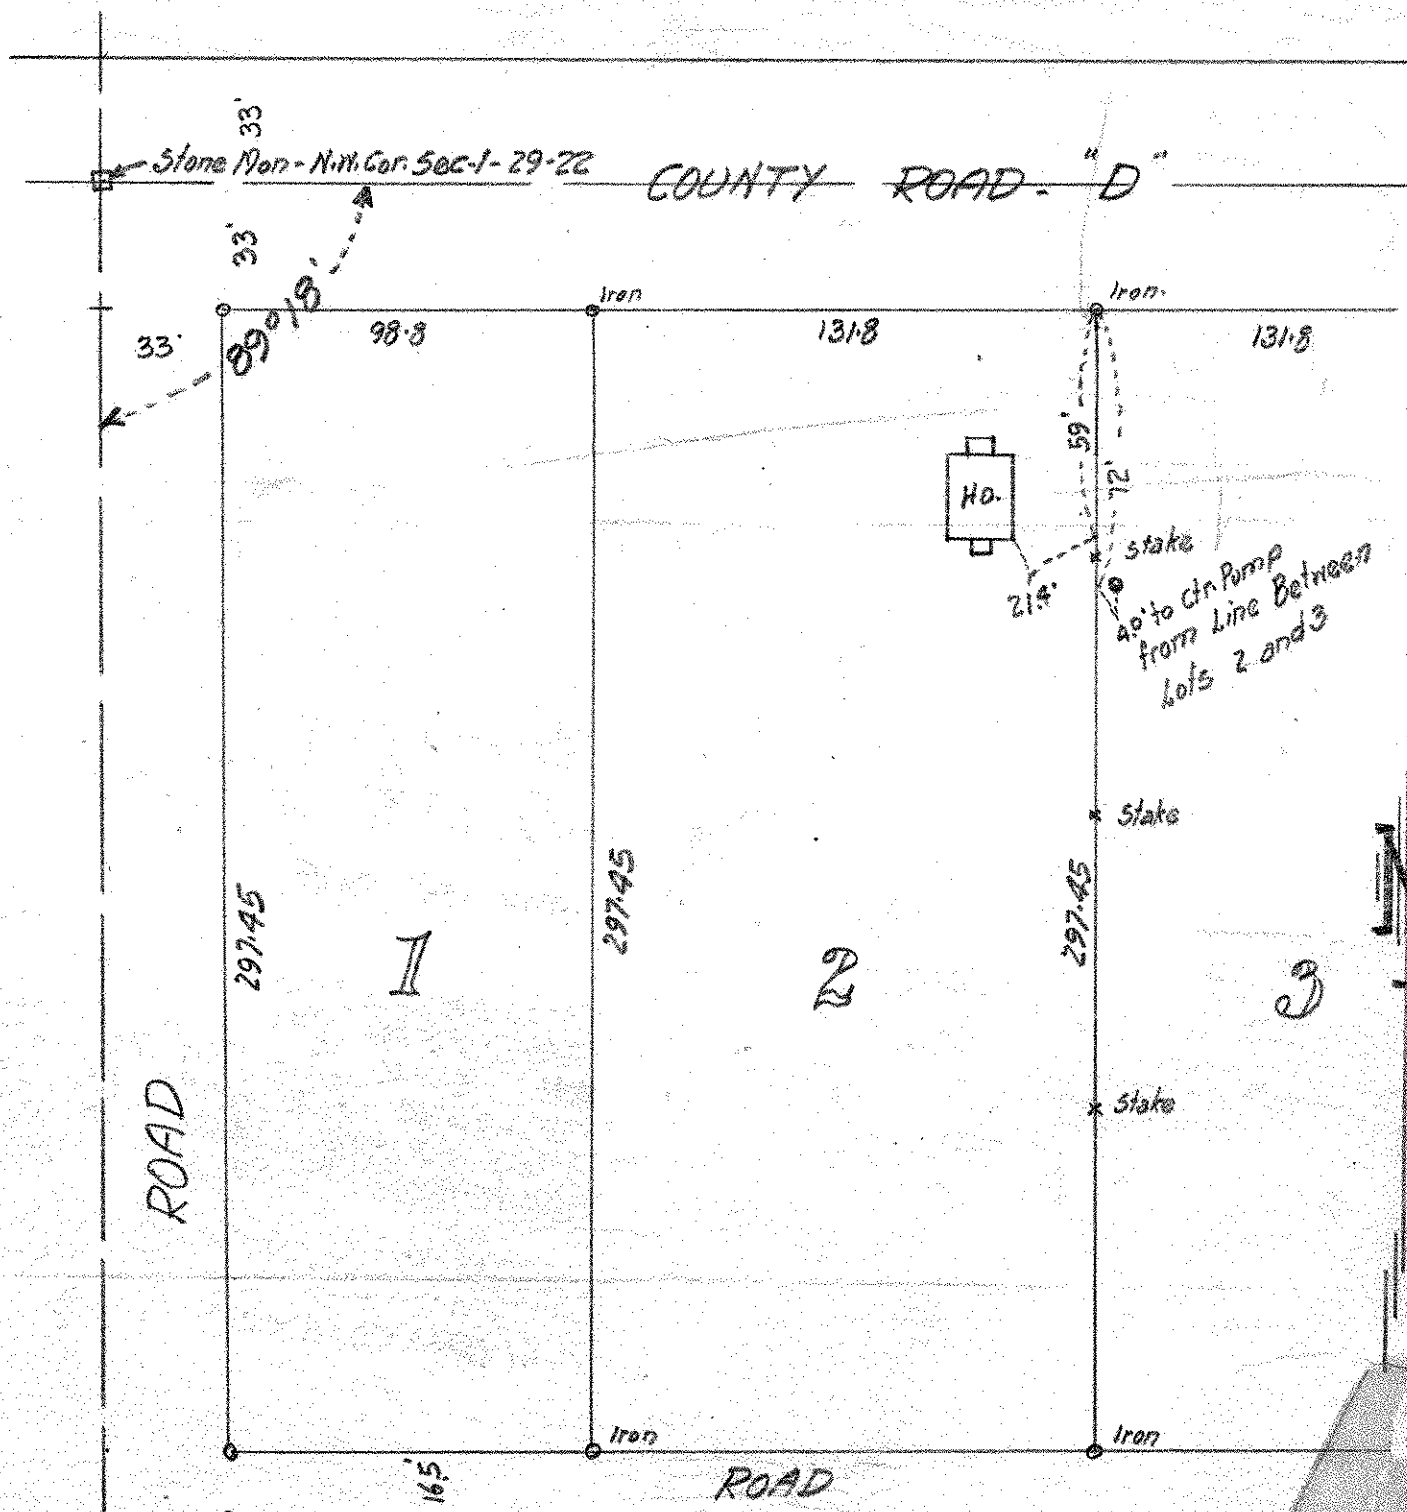

Scale - 50' = 1"  
October-23-1932

P. R. Banister  
Consulting Engineer  
North St. Paul, Minn.

