


PLAT OF SURVEY

OF PROPERTY OF _____

DESCRIBED AS FOLLOWS Lots 11 and 12, except So. 105 ft. Block 3,
Brunson Add. to Town of St. Paul.
No. 577 Brunson St. Paul, Minn.

SCALE: 1 INCH. 30 FEET.

T. J. WELCH, REGISTERED SURVEYOR
 738 VAN BUREN PLACE, ST. PAUL, MINN.

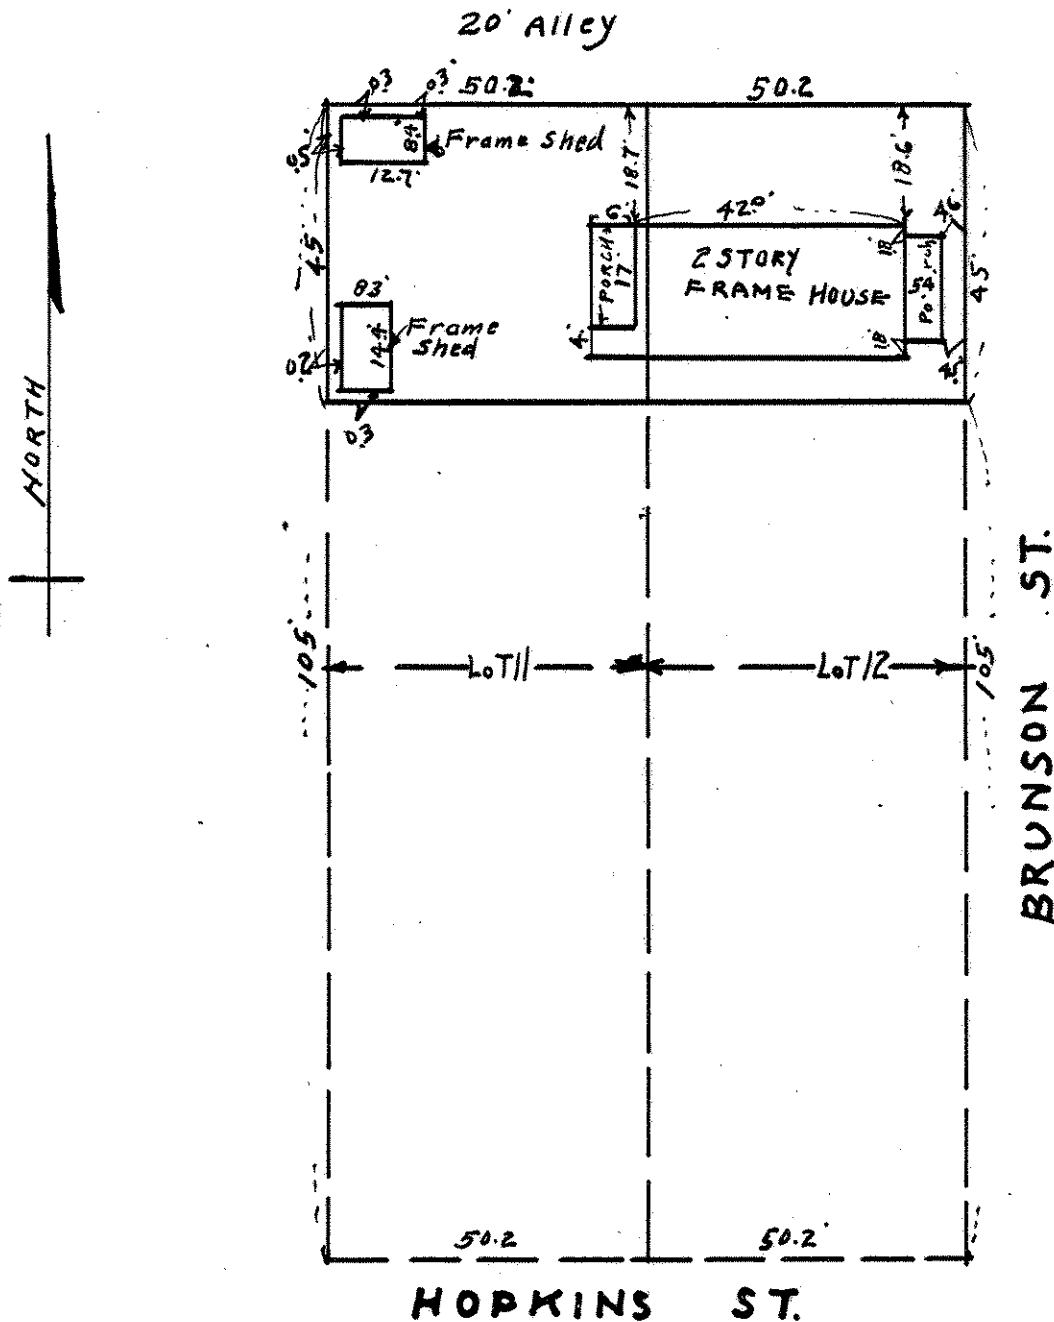

CERTIFICATE OF LOCATION OF BUILDING

I hereby certify that on April, 10, 1936
 I made a survey of the location of the building on the above
 described property and that the location of said building is
 correctly shown on the above plat.

T. J. Welch

CERTIFICATE OF SURVEY

I hereby certify that on April, 10, 1936
 I surveyed the property described above and that the above
 plat is a correct representation of said survey.

T. J. Welch