


PLAT OF SURVEY

OF PROPERTY OF Edward K. Delaney
DESCRIBED AS FOLLOWS Lot 30, Block 8, Boulevard Addition
No. 1463 Hague Ave., St. Paul, Minn.

SCALE: 1 INCH 20 FEET

T. J. WELCH, REGISTERED SURVEYOR
738 SURREY AVENUE, ST. PAUL, MINN.

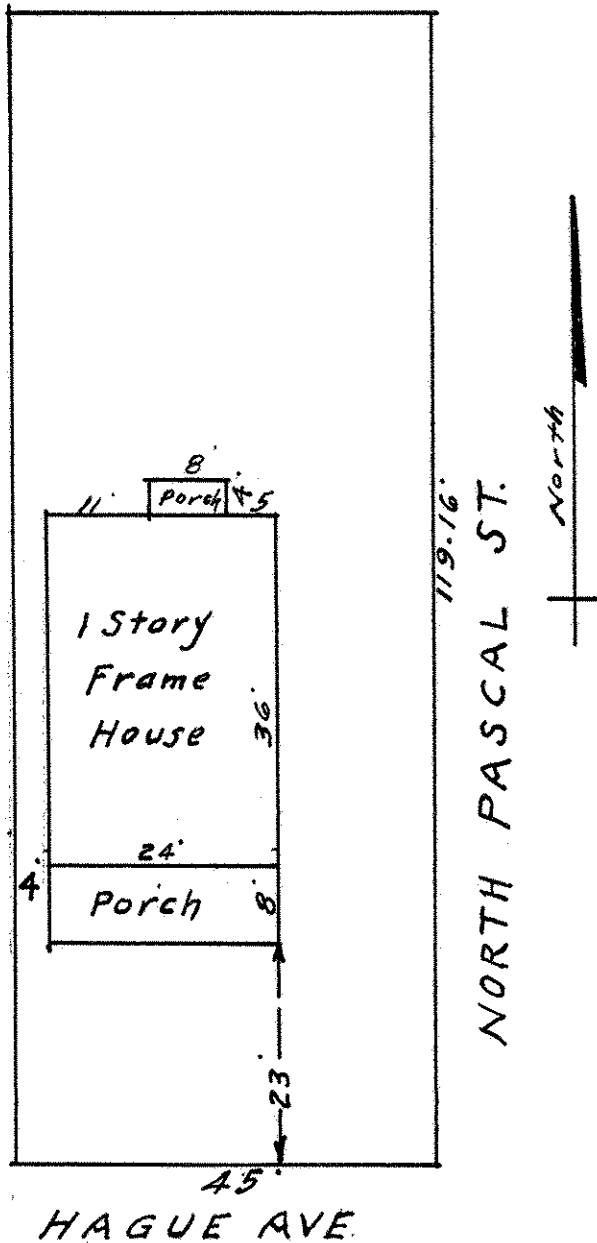

CERTIFICATE OF SURVEY

I hereby certify that on March 18, 19 43
I surveyed the property described above and that the above
plat is a correct representation of said survey.

T. J. Welch