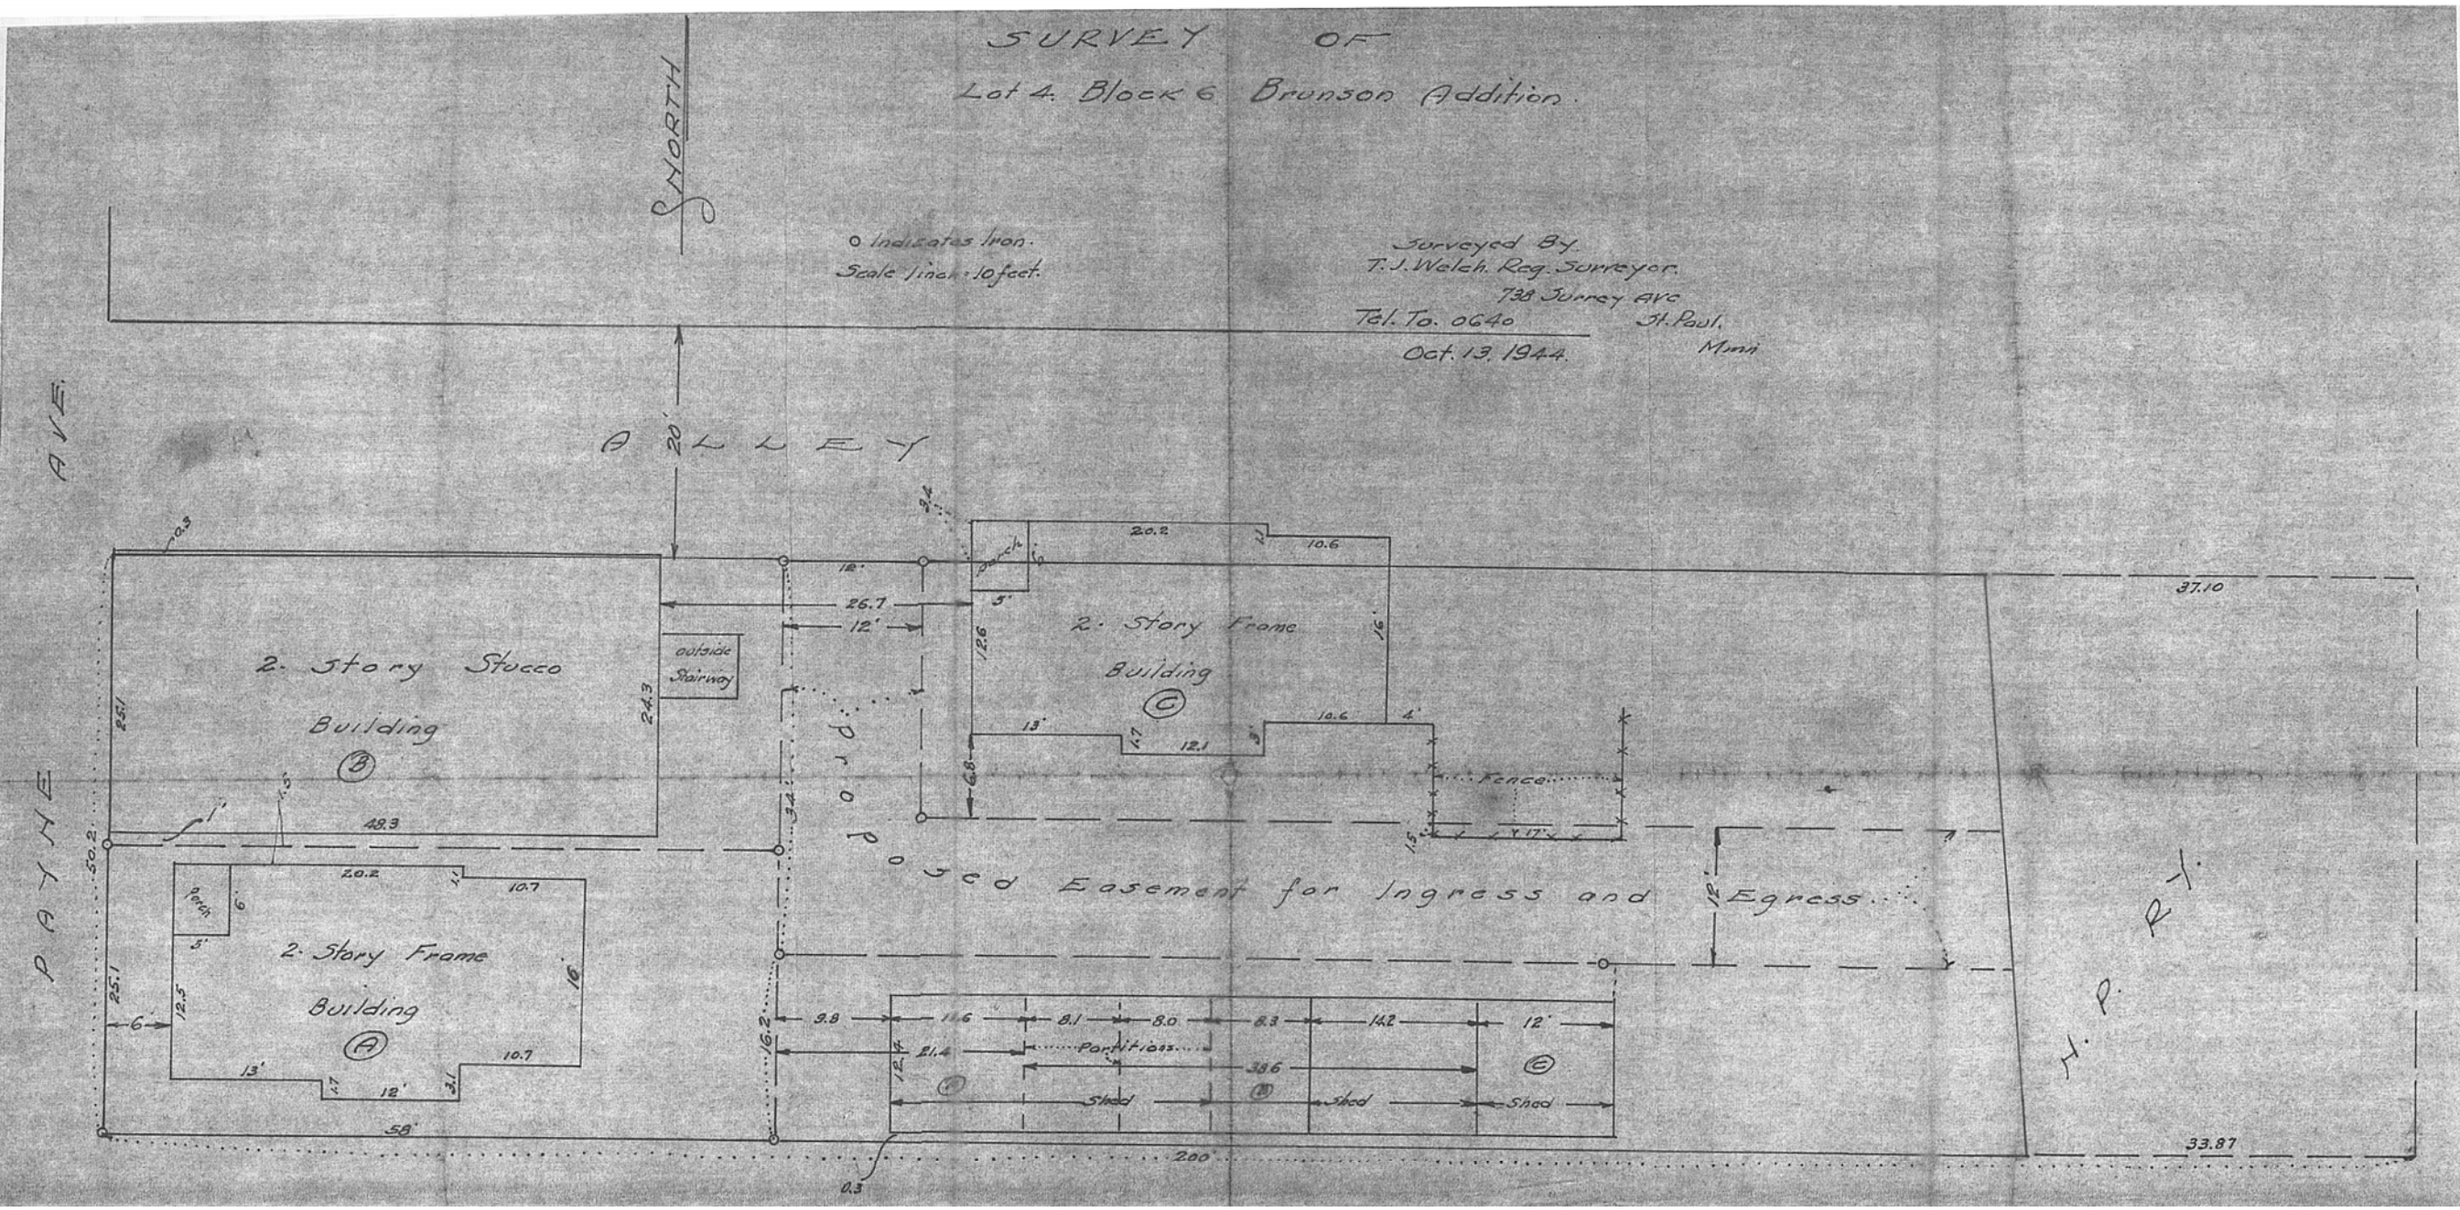
SURVEY OF
Lot 4. Block 6 Brunson Addition.
NORTH
o Indicates Iron.
Scale 1 inch = 10 feet.
Surveyed By
T. J. Welch. Reg. Surveyor.
738 Surrey Ave
St. Paul.
Minn
Tel. To. 0640
Oct. 13. 1944.
ALLEY
20'
PAYNE AVE.
2. Story Stucco Building
B
outside Stairway
2. Story Frame Building
C
2. Story Frame Building
A
Porch
Fence
Proposed Easement for Ingress and Egress
Partitions
Shed
H. P. RY.
37.10
33.87
200'
58'
48.3
26.7
12'
20.2
10.6
10.7
13'
12.1
12.5
21.4
38.6
9.8
11.6
8.1
8.0
8.3
14.2
12'
25.1
24.3
50.2
16.2
6'
0.3