

conditions indicated hereon are as shown.

Surveyed Sept., 14, 1951.

Plat Scale - 1 in = 50 ft. Indicates Iron Mont.

Description - The East 80 ft. of West 233 1/3 ft. of that part of Govt. Lot 2, Section 24, T.30 N., R.22 W. lying between Schneider Road (now South Shore Blvd.) and Minneapolis & St. Paul Suburban Ry. right of way, now abandoned.

*Bluffgram*

SOUTH SHORE


BLVD

153 1/3'

80.9' ±

80'


156'

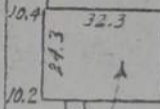

1.5. HOUSE UNDER CONSTR.

TRACT DESCRIBED HEREDN

WEST LINE OF GOVT. LOT 2, SEC. 24 - 30 - 22

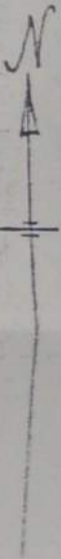

80'