34 29 22

# PLAT OF SURVEY

OF

PARTS OF S.E. ¼ OF SEC. 34, T. 29 N., R. 22 W.

SURVEYED JUNE 21 & 22, 1951.

PLAT SCALE - 1 IN = 50 FT.

• INDICATES IRON MONT.

[signature]
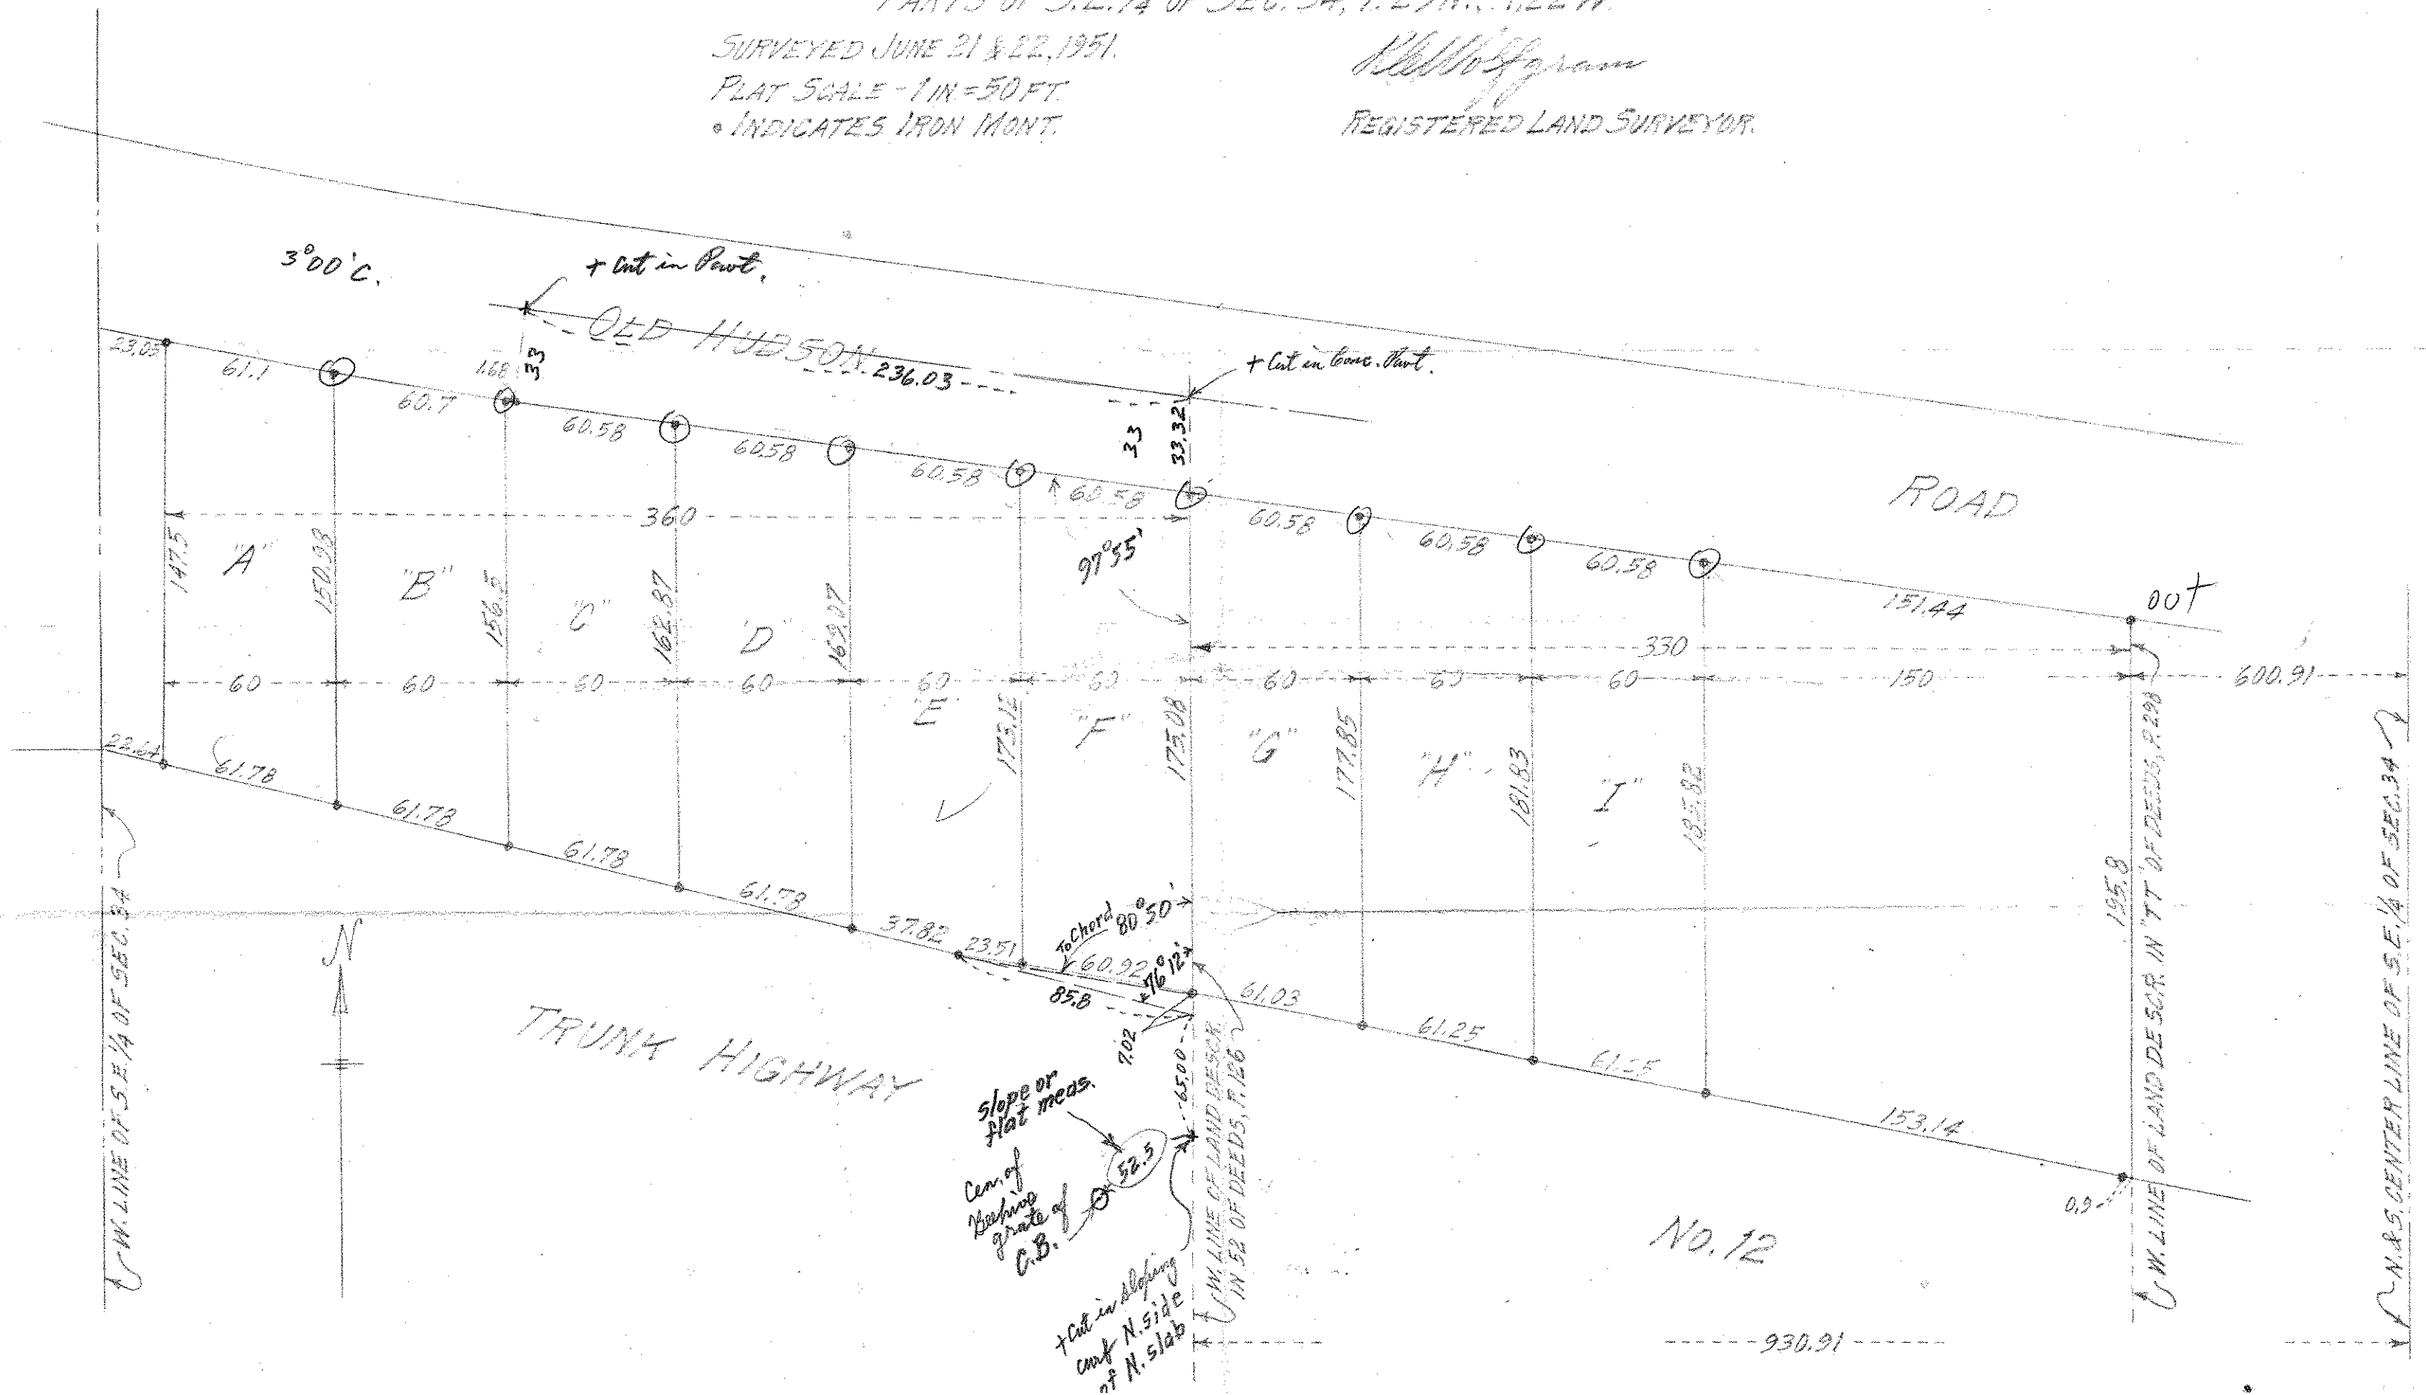
REGISTERED LAND SURVEYOR.