

SCALE: 1 INCH 200 FEET

THE E. B. McDONOUGH CO.  
1953 UNIVERSITY AVE., SAINT PAUL 4  
400 NATIONAL BUILDING, MINNEAPOLIS 2


TELEPHONES { MI 3201  
GE 9441  
EM 5072

# PLAT OF SURVEY

OF PROPERTY OF Albert Lokken, 2400 No. Hamline Ave., St. Paul, Minn.

DESCRIBED AS FOLLOWS The South 1/8 of the Southwest 1/4 of the Northeast 1/4 of Section 10, Township 29, Range 23, except that part taken for Hamline Ave.

Note: That part taken for Hamline Ave. is excepted from the West  $\frac{1}{2}$  of the above description.

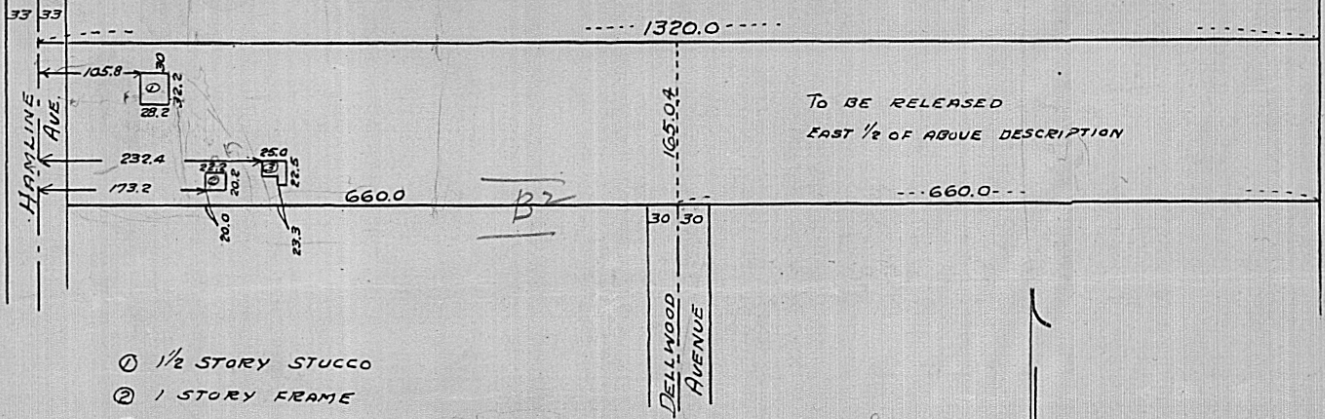

- ① 1/2 STORY STUCCO
- ② 1 STORY FRAME
- ③ SHED

1058  
33  
728

### CERTIFICATE OF LOCATION OF BUILDING

I hereby certify that on 3-31 1952  
I made a survey of the location of the building(s) on the above described property and that the location of said building(s) is correctly shown on the above plat.

*E. B. McDonough*

E. B. McDONOUGH, REGISTERED SURVEYOR, NO. 1990  
DONALD O. WEBER, REGISTERED SURVEYOR, NO. 665

### CERTIFICATE OF SURVEY

I hereby certify that on \_\_\_\_\_ 19\_\_\_\_  
I surveyed the property described above and that the above plat is a correct representation of said survey.