REGISTERED LAND SURVEY NO. 15

314443 DUPLICATE

OFFICE OF REGISTRAR OF TITLES
RAMSEY COUNTY, MINNESOTA

I Hereby Certify That I have carefully compared the within copy of Registered Land Survey No. 15 Files of Registrar of Titles, Ramsey County, with the original which was Filed in this office this 29th day of December A.D. 1952 at 2 40 o'clock P.M. and found the same to be a true and correct copy thereof.

J. C. Burkhard
Registrar of Titles

J. Woodlock
Deputy.

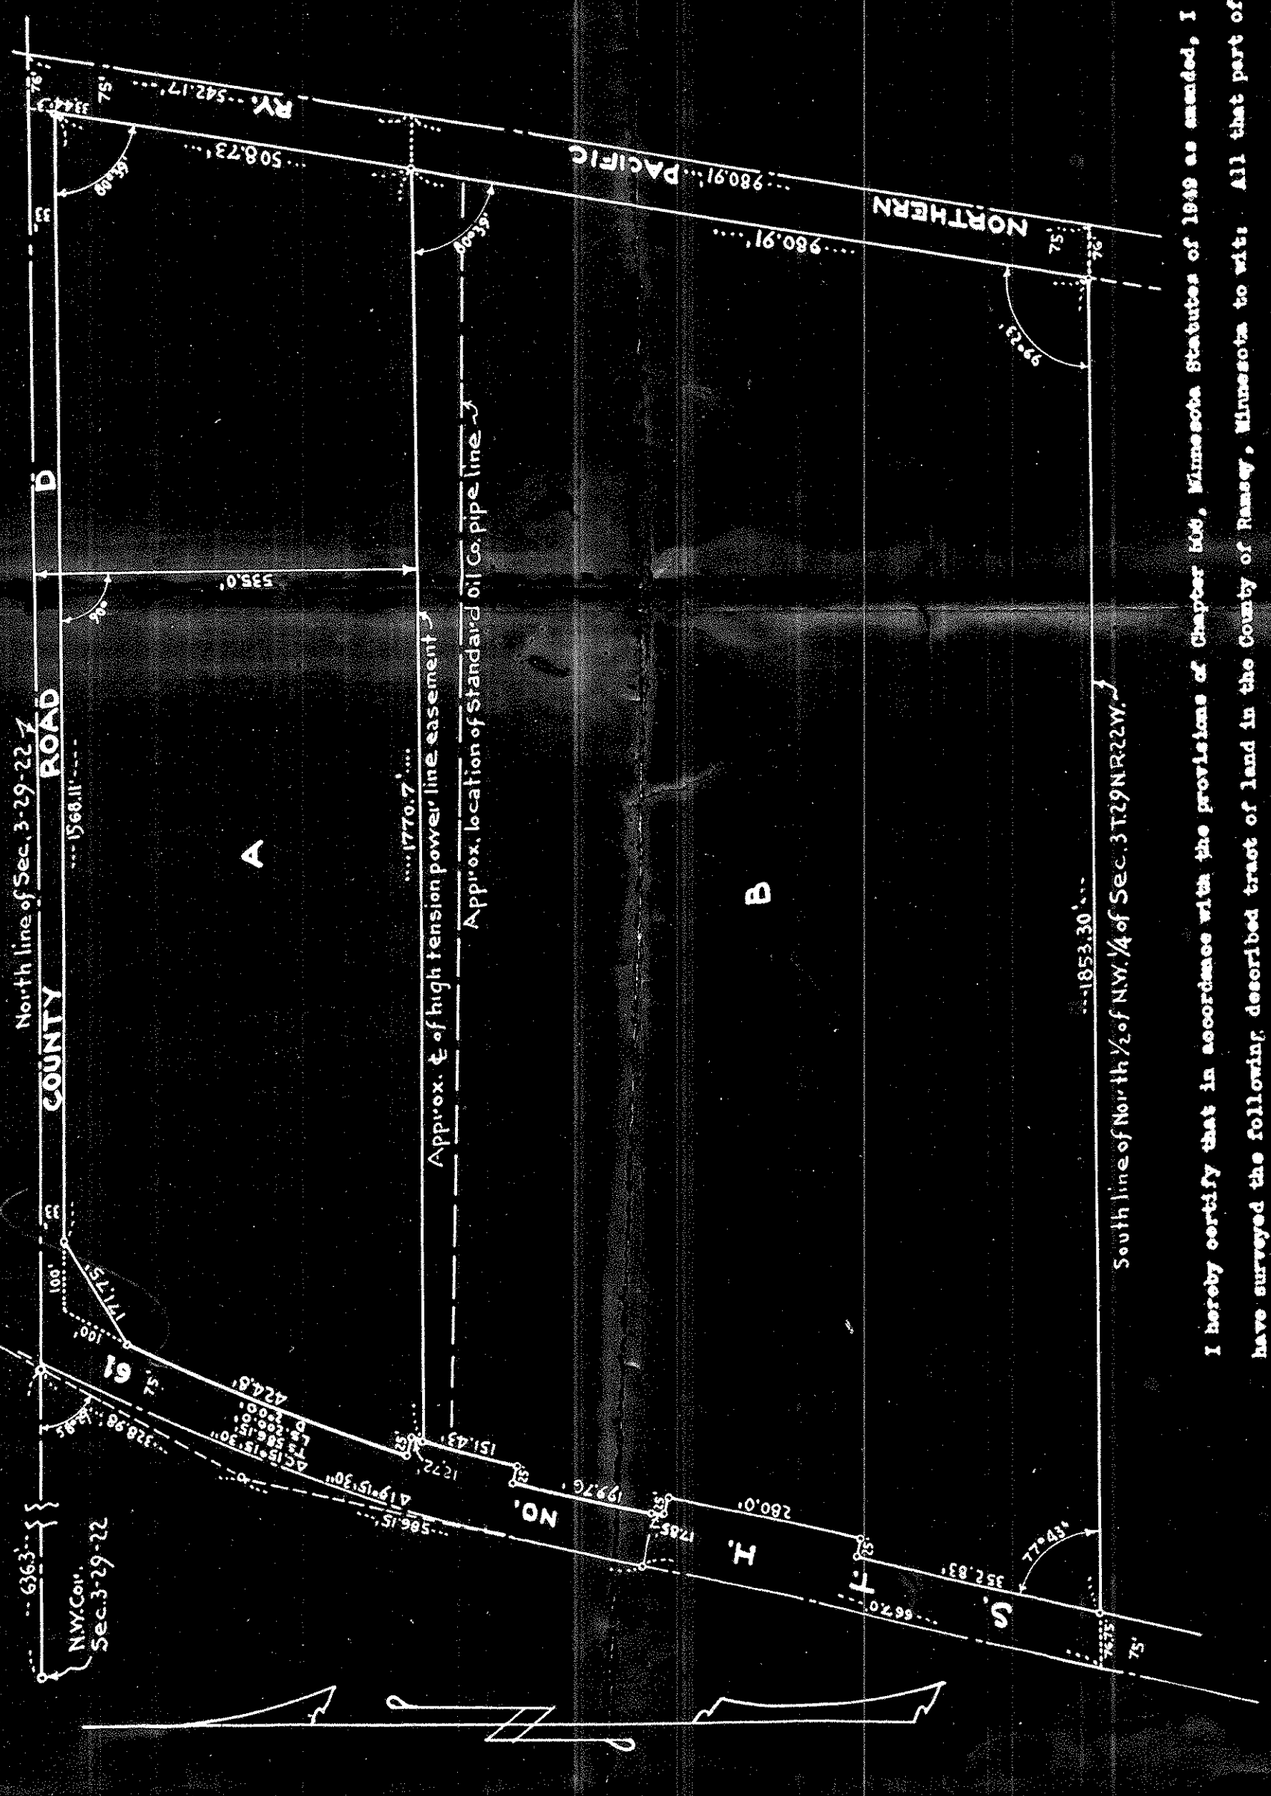

I hereby certify that in accordance with the provisions of Chapter 508, Minnesota Statutes of 1949 as amended, I have surveyed the following described tract of land in the County of Ramsey, Minnesota to wit: All that part of the Northwest 1/4 of the Northwest 1/4 of Section 3, Township 29 North, Range 22 West, which lies west of the Westerly right of way line of the Northern Pacific Railroad as now located and Easterly of the St. Paul and White Bear Road (S. T. E. 61) as now widened, subject to County Road "D". power easement and pipeline easement. That the survey thereon is a correct delineation of said survey.

Scale 1" - 200'. ○ indicates iron

this 27th day of [illegible] 1952.

[illegible]
Registered Surveyor No. 3624