


# CERTIFICATE of SURVEY

F. J. ARMSTRONG  
Civil Engineer and Surveyor  
ST. PAUL, MINN.

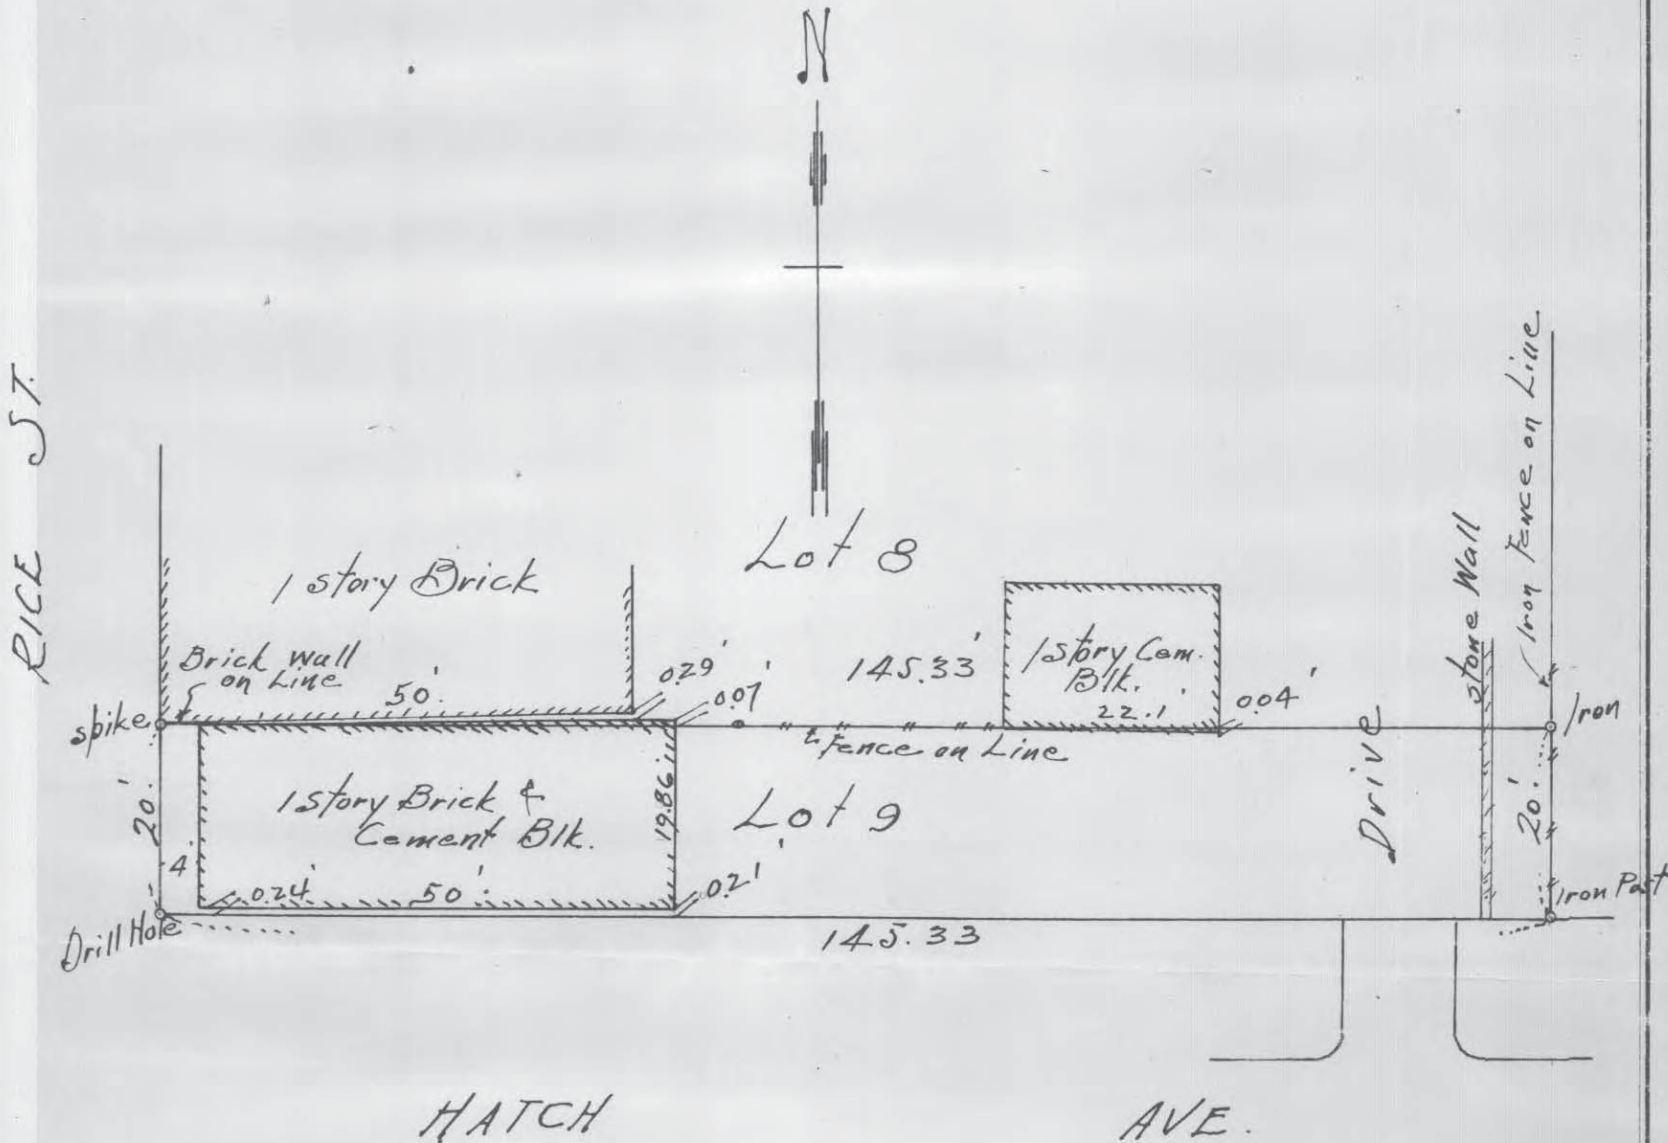

Scale 20 ft. per inch

I HEREBY CERTIFY that on the 2<sup>nd</sup> day of June, A. D. 1954

I made a survey of the following described property, to-wit: Lot 9 Auditor's Subdivision No 17 St. Paul, Minn.

Subscribed and sworn to before me this

3 day of June, 1954

Helen O. Anderson  
Notary Public.

and the above map is a true and correct map of said survey and the improvements shown thereon are correctly indicated; there are no encroachments other than indicated.

My Commission Expires.....

HELEN O. ANDERSON

F. J. Armstrong Civil Engineer

# 8045