

TELEPHONE TOWER 0640


# PLAT OF SURVEY

OF PROPERTY OF \_\_\_\_\_

DESCRIBED AS FOLLOWS Lot 26, Block 29, Beaver Lake Heights

SCALE: 1 INCH 30 FEET  
O DENOTES IRON

T. J. WELCH, REGISTERED SURVEYOR  
738 SURREY AVENUE, ST. PAUL 6, MINN.

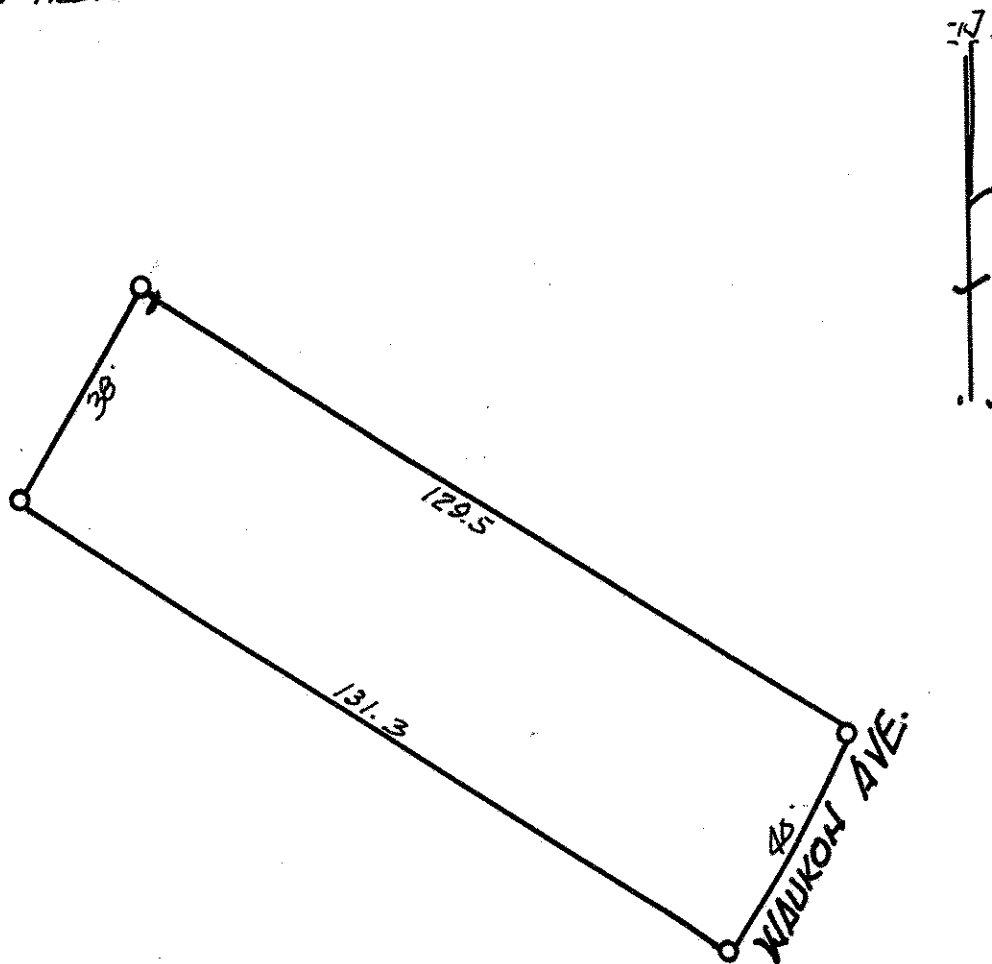

## CERTIFICATE OF SURVEY

I hereby certify that on 10-22 1954

I surveyed the property described above and that the above  
plat is a correct representation of said survey.

T. J. Welch