FROM THE OFFICE OF

CHARLES O. GEORGI COMPANY

2215 West County Road B — Saint Paul 8, Minnesota

MINNESOTA REGISTERED LAND SURVEYOR

Certificate of Survey

I Hereby Certify that this plat shows a survey made by me of the property described on this plat, and that the corners are correctly placed as shown, and that all locations, encroachments, etc., have been correctly shown.

Surveyed For ROBERT H. AGAR

Date October 1955 10/1/69 Added 2 Descriptions

Scale 1" = 100'

By Charles O. Georgi
REGISTERED LAND SURVEYOR

DESCRIPTION:

The SW 1/4 of the SW 1/4 of the SE 1/4 of Section 8 T29 R23 except the East 480 feet and excepting the rights of the public in that portion thereof taken or occupied as public roads or highways, Ramsey County, Minnesota

4/24/69 Lorette Hanna

Description
The North 331.0 feet of the SW 1/4 of the SW 1/4 of the SE 1/4 of Section 8 T29, R23 except the East 480 feet and excepting rights of the public in that part thereof taken or occupied as public roads or highways, Ramsey County, Minn

Description:
The SW 1/4 of the SW 1/4 of the SE 1/4 of Section 8 T29 R23 except the North 331.0 feet thereof and except the East 480 feet thereof and excepting the rights of the public in that portion thereof taken or occupied as public roads or highways, Ramsey County, Minn

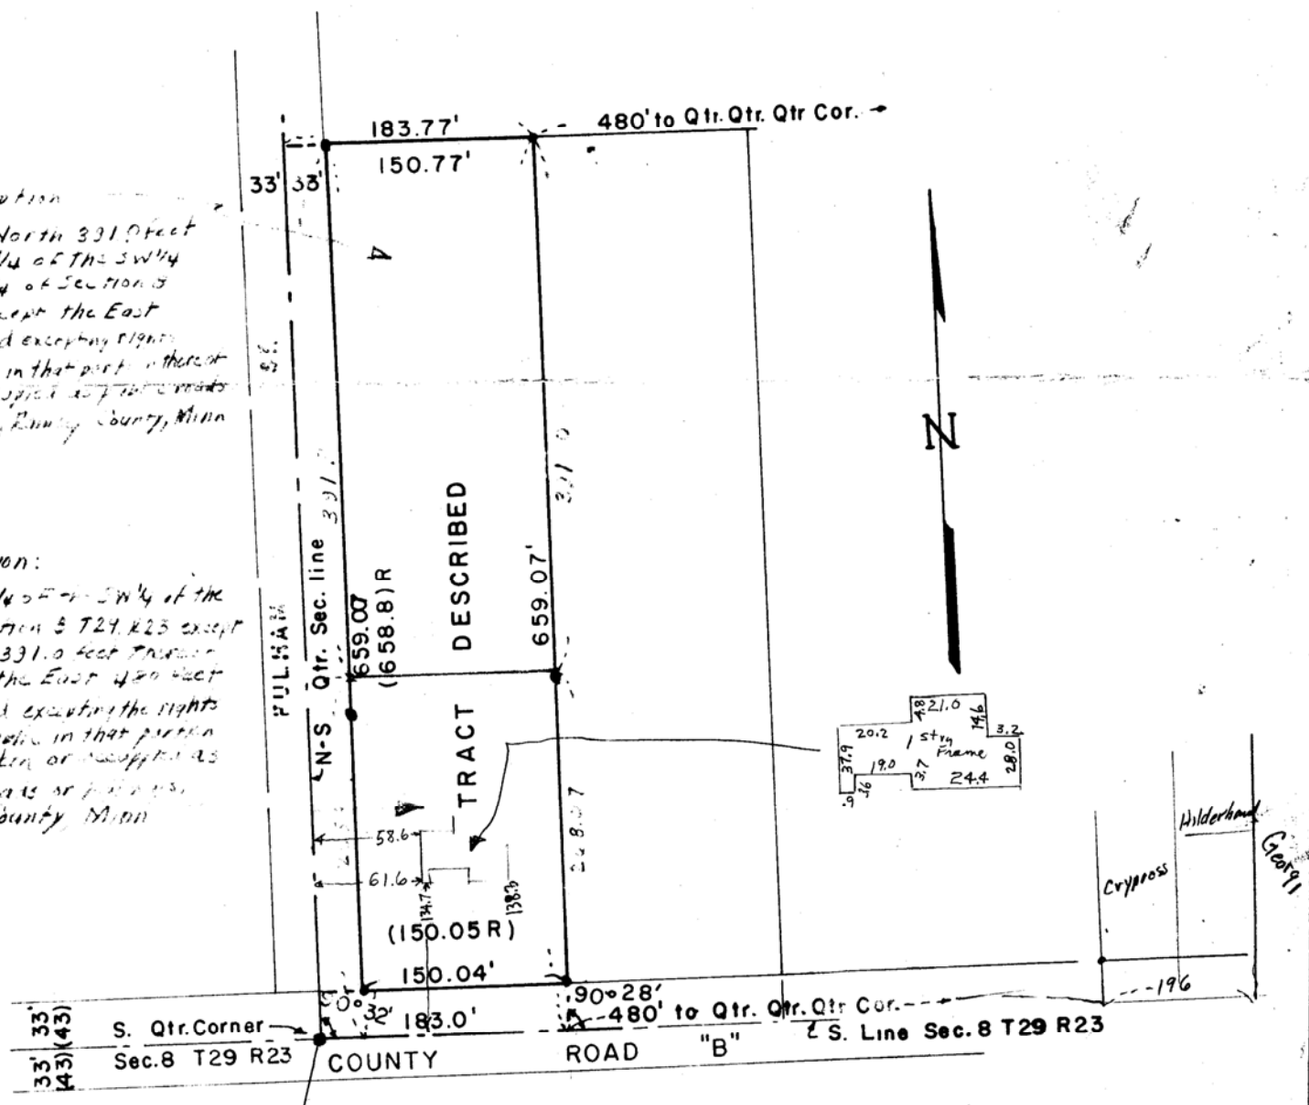

CI Mont
NE 51.9 14" oak
SE 38.15 ↑P
NW 32.06
1961 N2676 PP
SW 57.71 Cor Mont