Certificate of Survey

FROM THE OFFICE OF

CHARLES O. GEORGI COMPANY

2215 West County Road B — Saint Paul 8, Minnesota

MINNESOTA REGISTERED LAND SURVEYOR

I Hereby Certify that this plat shows a survey made by me of the property described on this plat, and that the corners are correctly placed as shown, and that all locations, encroachments, etc., have been correctly shown.

Surveyed For WILLIAM F. STENGER

Date 8/ 18/ 55

Scale 1" = 200'

By Charles O. Georgi

REGISTERED LAND SURVEYOR

DESCRIPTION:
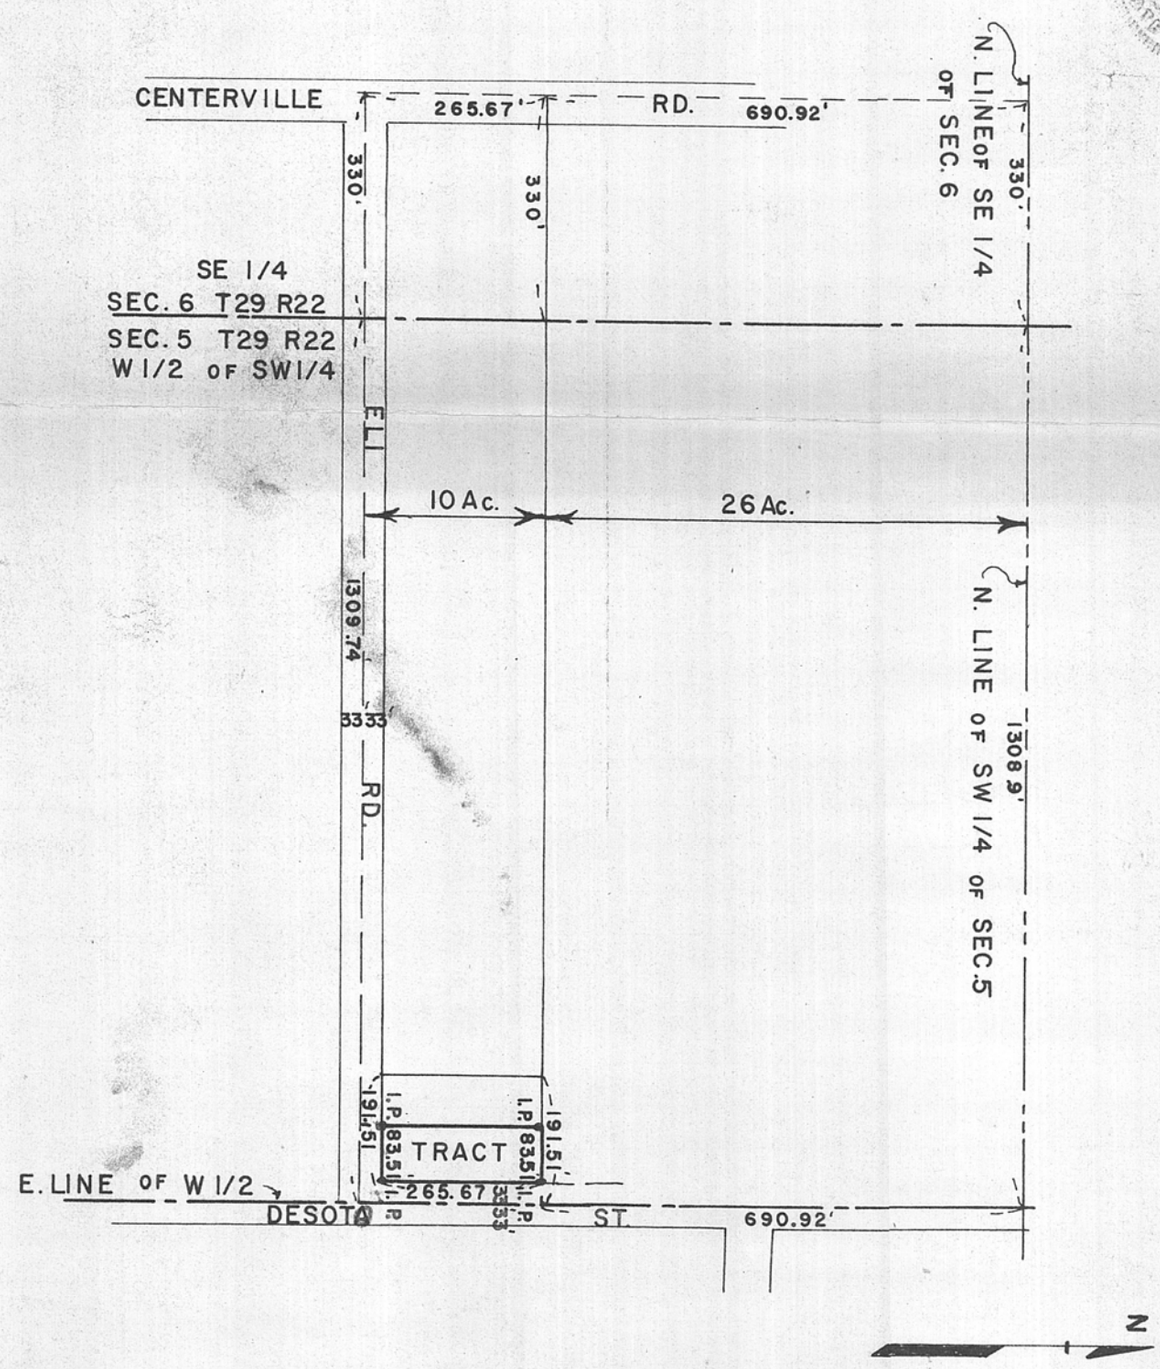
East 116.51 feet of the East 191.51 feet of the South 10 Acres of the North 36 Acres of the following described tract:
The East 330 feet of the Southeast Quarter of Section 6 and of the West one-half of the Southwest one-Quarter of Section 5 Township 29 Range 22; subject to Eli Road and Desota Street.