

Sw 16 27 29


FROM THE OFFICE OF

# CHARLES O. GEORGI COMPANY

2215 West County Road B

Saint Paul 8, Minnesota

MINNESOTA REGISTERED LAND SURVEYOR

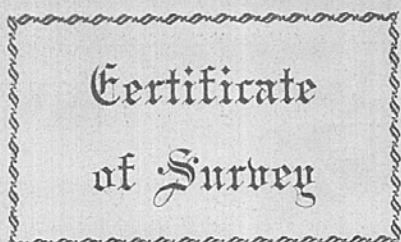

## Certificate of Survey

I Hereby Certify that this plat shows a survey made by me of the property described on this plat, and that the corners are correctly placed as shown, and that all locations, encroachments, etc., have been correctly shown.

Surveyed For MRS. ANNA SCHMELZ HOFFMAN

Date October 1955

Scale 1" = 100'

By *Charles O. Georgi*  
REGISTERED LAND SURVEYOR

### DESCRIPTIONS.

Tract 1 and 2 (In accordance with Abstract Office -per Nash and Boherty, Attorneys

The East 123 feet of the South 708.29 feet of that part of the West  $\frac{1}{2}$  of the SW  $\frac{1}{4}$  of Section 16 Township 29 Range 23, lying West of the East 15 acres thereof.

#### Tract 1

The East 123 feet of the West 1066.8 feet of the South 268.0 feet of the SW  $\frac{1}{4}$  of the SW  $\frac{1}{4}$  of Section 16 Township 29 Range 23. Subject to Larpenteur Avenue.

#### Tract 2

The East 123 feet of the West 1066.8 feet of the North 440.29 feet of the South 708.29 feet of the SW  $\frac{1}{4}$  of the SW  $\frac{1}{4}$  of Section 16 Township 29 Range 23.

