

W. F. BRETTSCHEIDER

Registered Civil Engineer and Land Surveyor

1160 Charles Ave. - St. Paul 4, Minn.

Phone: Midway 5-7505

Scale: 1 inch = 100 feet.


PLAT OF SURVEY

o Indicates Iron

OF PROPERTY OF *Frank McCarron*

described as follows: *Except The Northeasterly 145 Ft, The Southwesterly 85 Ft Of The Northeasterly 230 Ft Measured On The $\frac{1}{2}$ of McCarron's Blvd North Of The Following Description. Subject To McCarron's Blvd North, Part Of The South 594 Ft Of The North 2200 Ft Of The NW $\frac{1}{4}$, Southeasterly Of The $\frac{1}{2}$ Of Said Blvd & Southwesterly Of A Line Run $N44^{\circ}10'W$ From A Point On The East Line Of $\frac{1}{2}$ 758 Ft. South From The N.E. Cor. Of The S.E. $\frac{1}{4}$ Of The N.W. $\frac{1}{4}$ Of Sec 13 T29 R23*

N.E. Cor. of S.E. $\frac{1}{4}$ of N.W. $\frac{1}{4}$
Sec 13 T29 R23

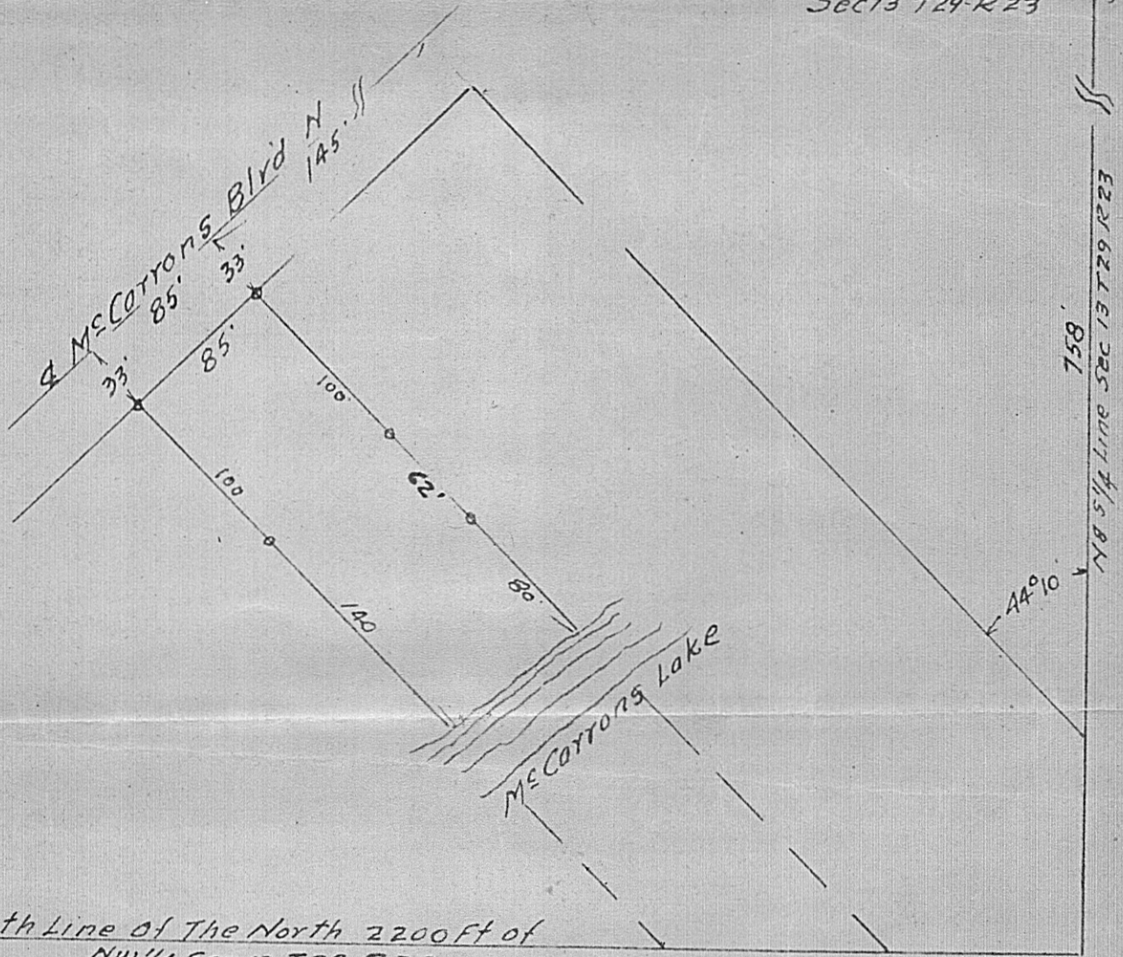

John's Sub

CERTIFICATE OF LOCATION OF BUILDING

I hereby certify that on _____, 19____, I made a survey of the proposed location of the building on the above described property and that the location of said building is correctly shown on the above plat.

CERTIFICATE OF SURVEY

I hereby certify that on *Oct 9*, 19*56*, I surveyed the property described above and that the above plat is a correct representation of said survey, and there are no encroachments except as shown hereon.

W. F. Brettschneider

2