343023

FROM THE OFFICE OF

CHARLES O. GEORGI COMPANY

2215 West County Road B — Saint Paul 8, Minnesota

MINNESOTA REGISTERED LAND SURVEYOR

Certificate of Survey

I Hereby Certify that this plat shows a survey made by me of the property described on this plat, and that the corners are correctly placed as shown, and that all locations, encroachments, etc., have been correctly shown.

Surveyed For VERNON S. SMITH
Date MAY 1956
Scale 1" = 50'

By Charles O. Georgi
REGISTERED LAND SURVEYOR

DESCRIPTION:
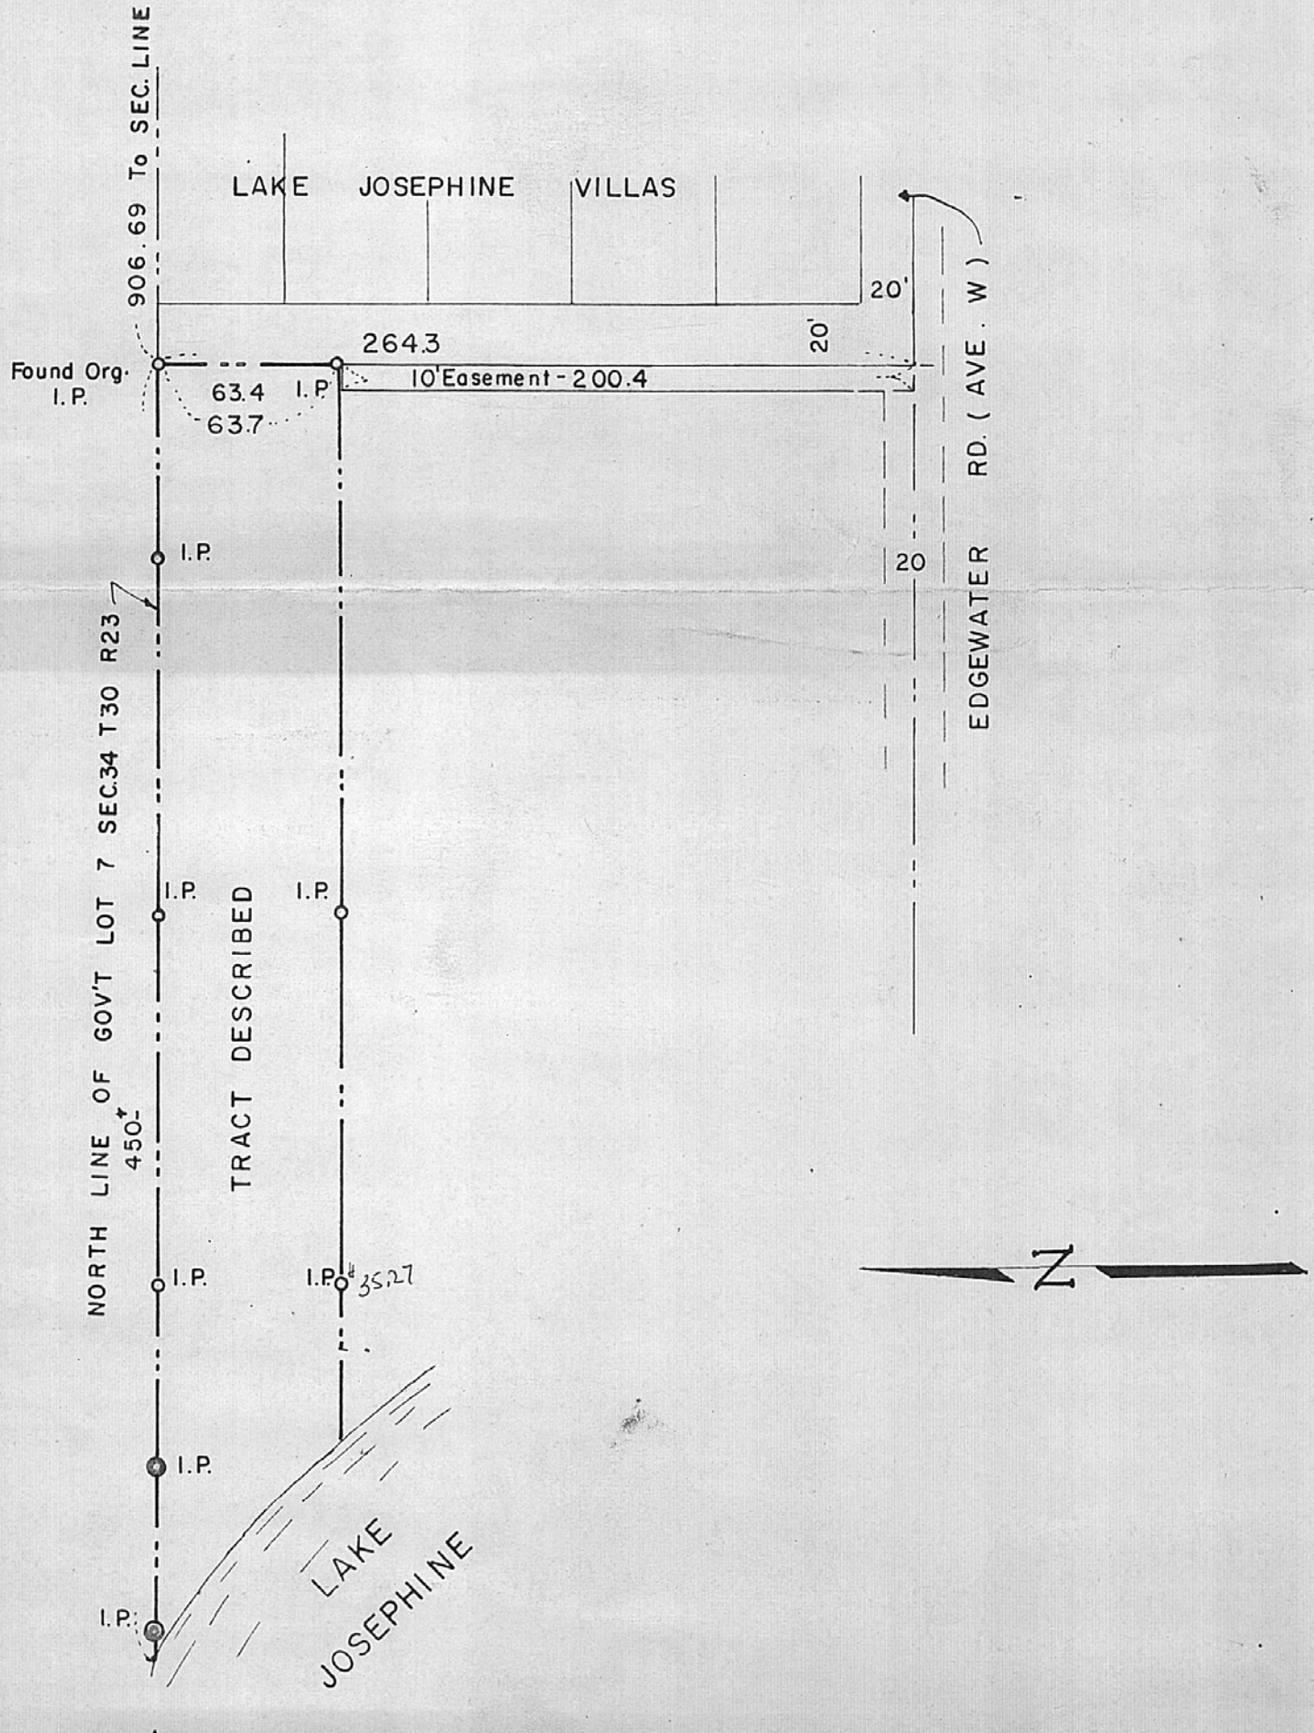
NORTH 63.4 (Written as 63.7) Feet of that part of the NORTH 264.3 Feet of GOV'T LOT 7, SEC. 34 T30 R23, lying between the EAST 906.69 Feet of said GOV'T LOT 7 & the Shore line of LAKE JOSEPHINE.