

PR. 4-4492


WARREN I. FORSBERG

2060 E. 5th St.
St. Paul 6, Minn.

Registered Land Surveyor

PLAT OF SURVEY

PROPERTY OF Abel Swanson Jr.
described as follows: The South 671.0' of Lot 26, Auditor's Sub #43, Ramsey County, Minn., Subject to additional right of way for Keller Parkway.

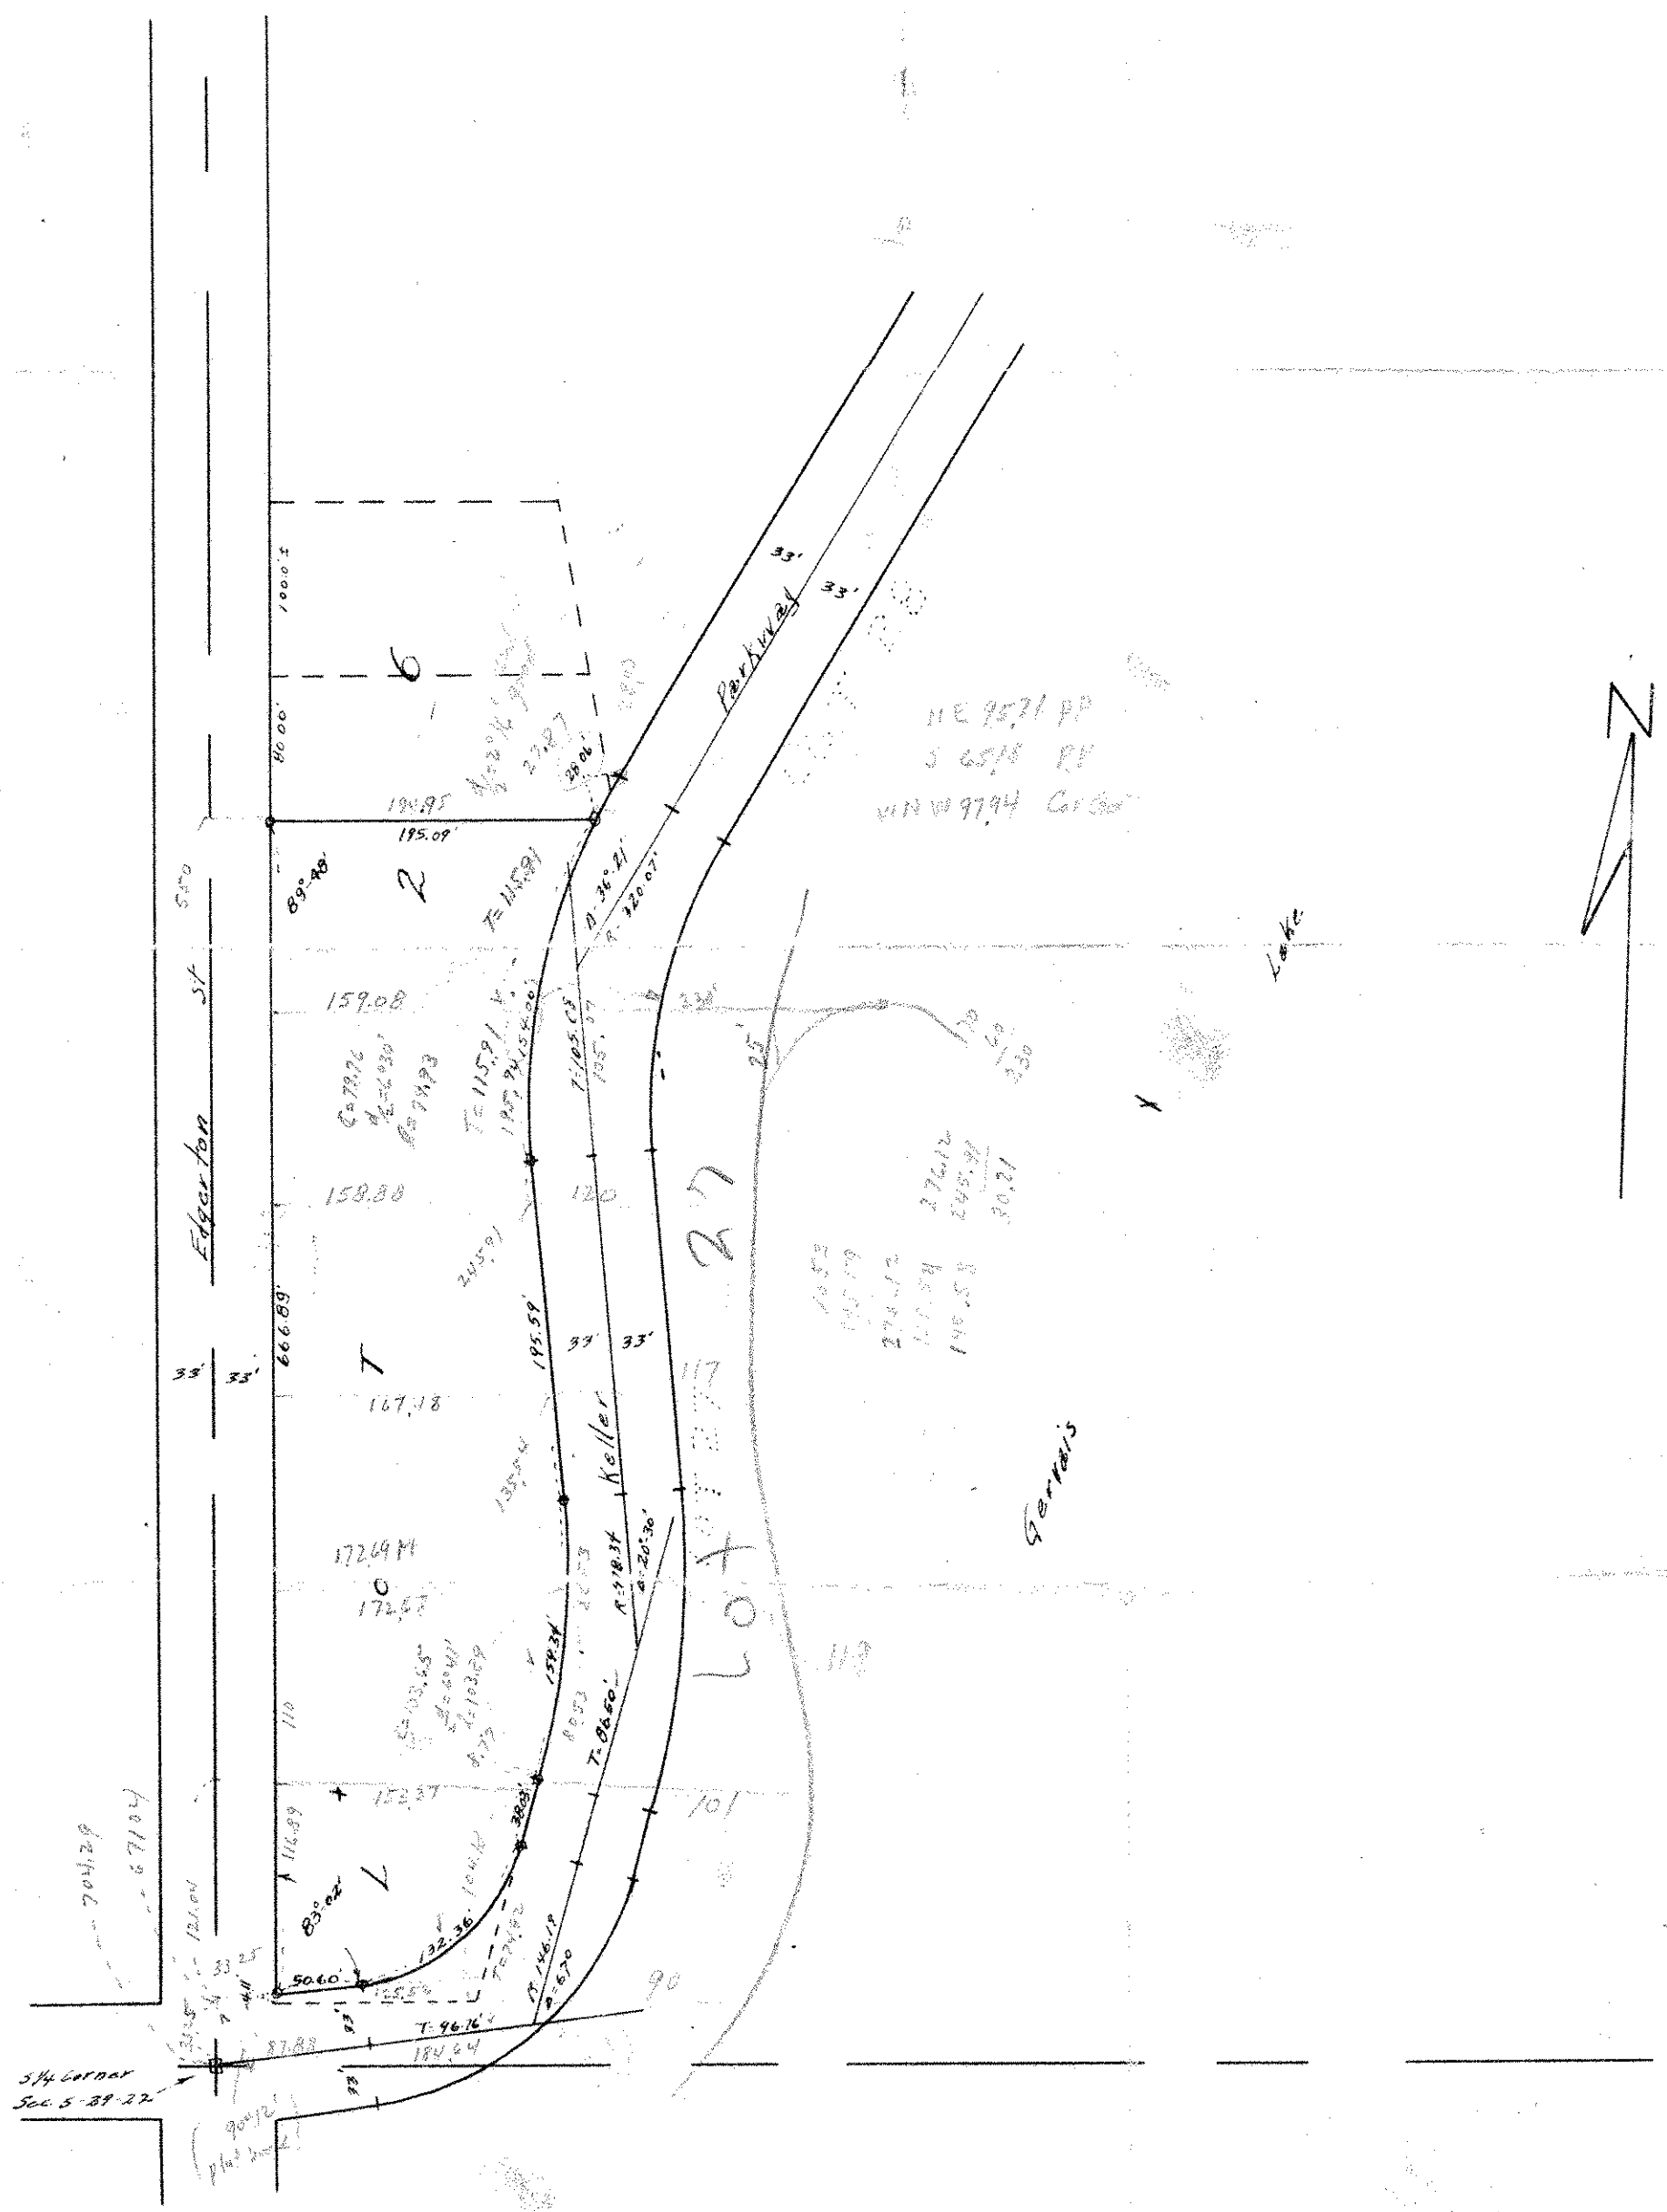

CERTIFICATE OF SURVEY

I hereby certify that on Oct 30 1956 I surveyed the property described above and that the above plat is a correct representation of said survey.

Scale: 1 inch 100' feet.

O—Indicates Iron Monument.

Warren I. Forsberg