

TELEPHONE TOWER 0640


PLAT OF SURVEY

OF PROPERTY OF _____

DESCRIBED AS FOLLOWS *Subject to County Road "C" the West 88' of the East 388' of the South 213' of the SE 1/4 of SE 1/4 of Section 3-29-22*

SCALE: 1 INCH = 50 FEET
o Denotes Iron

T. J. WELCH, REGISTERED SURVEYOR
738 SURREY AVENUE, ST. PAUL 6, MINN.

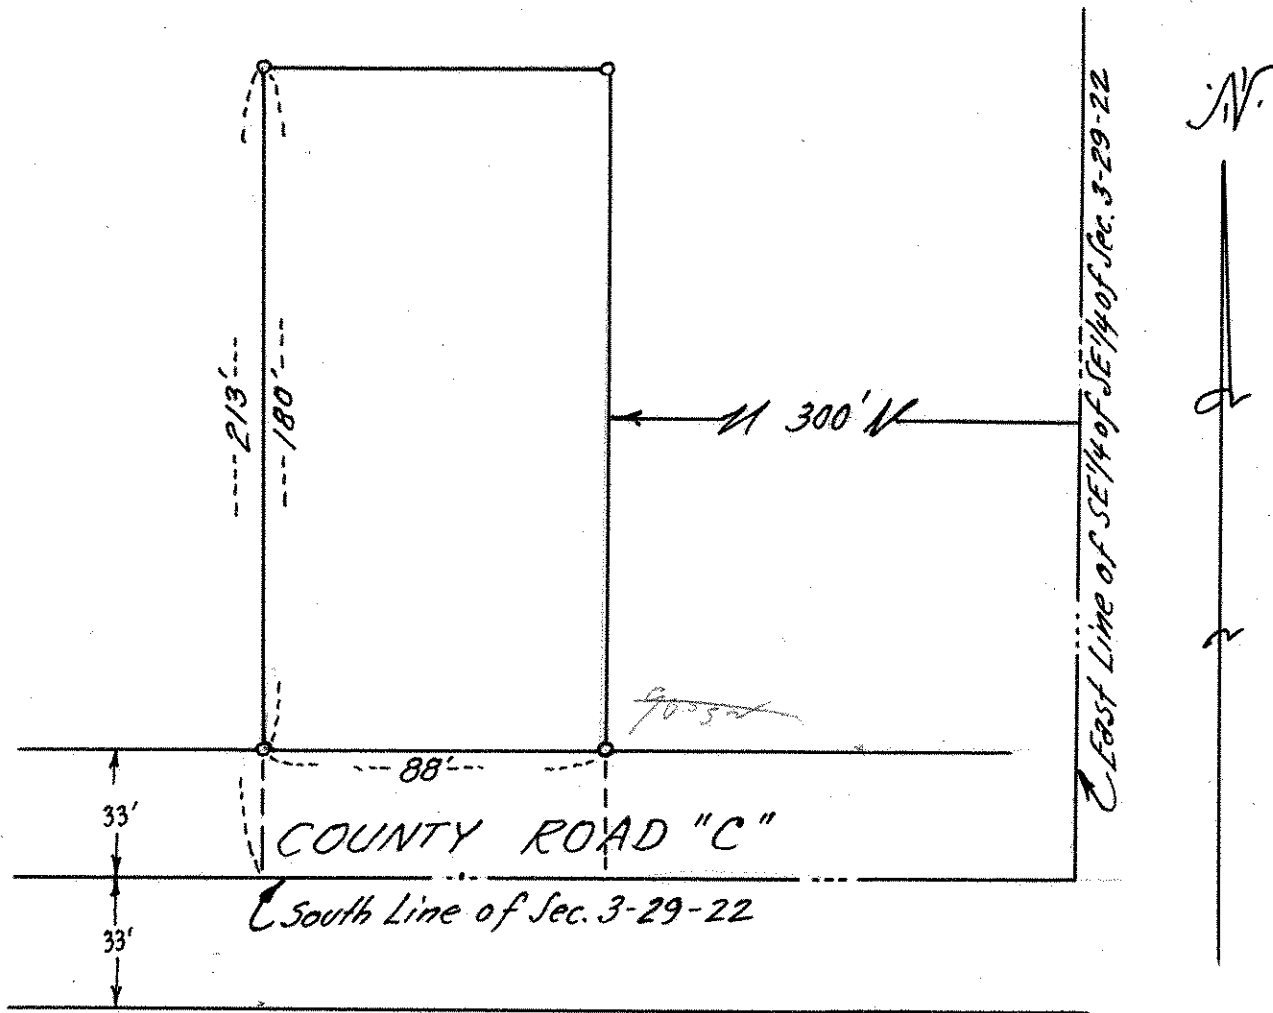

CERTIFICATE OF SURVEY

I hereby certify that on 6-20 19 57

I surveyed the property described above and that the above plat is a correct representation of said survey.

T. J. Welch